


T37S R8W East Half of Southwest and West Half of Southeast Quarters of Section 35

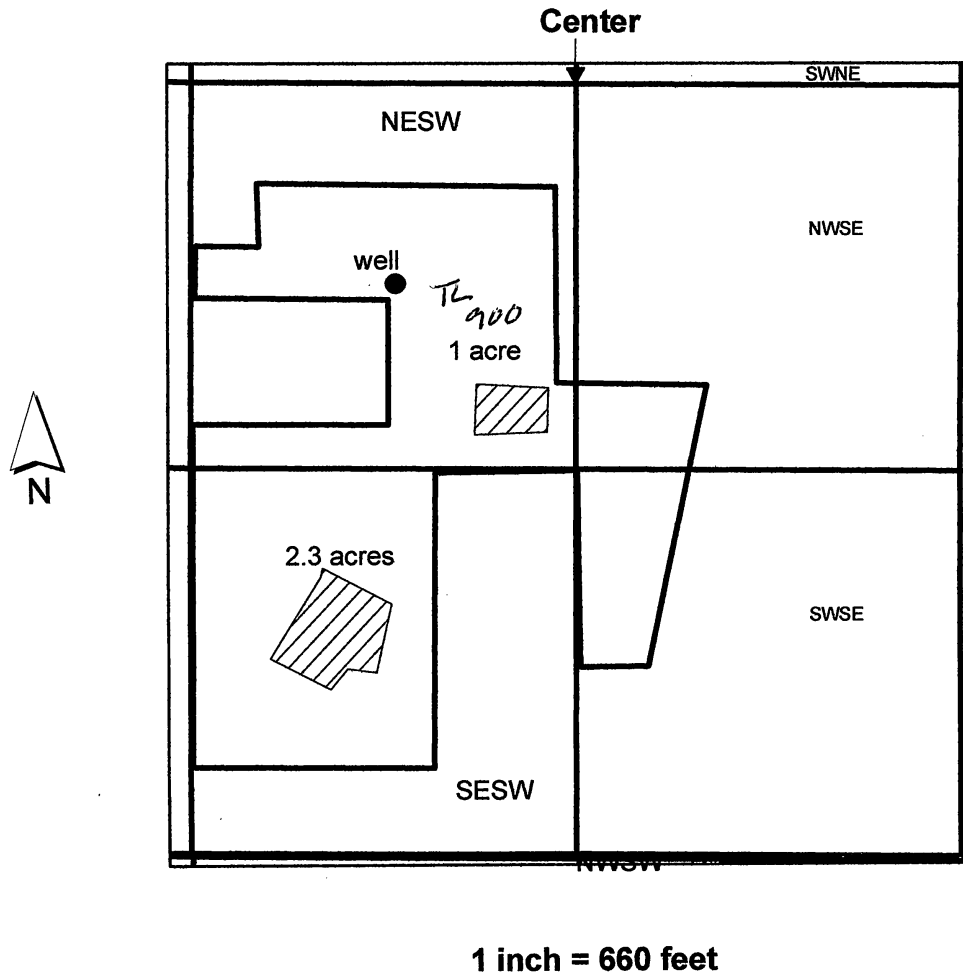

The well is located 686 ft south and
633 ft west from the center of Section 35.

RECEIVED BY OWRD

JAN 26 2017

SALEM, OR

G-18445