
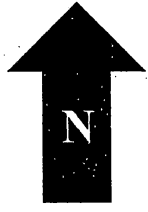


Groundwater Application Map – Guilford

T. 18 S. R. 5 W. Sec. 6, Tax Lot 601

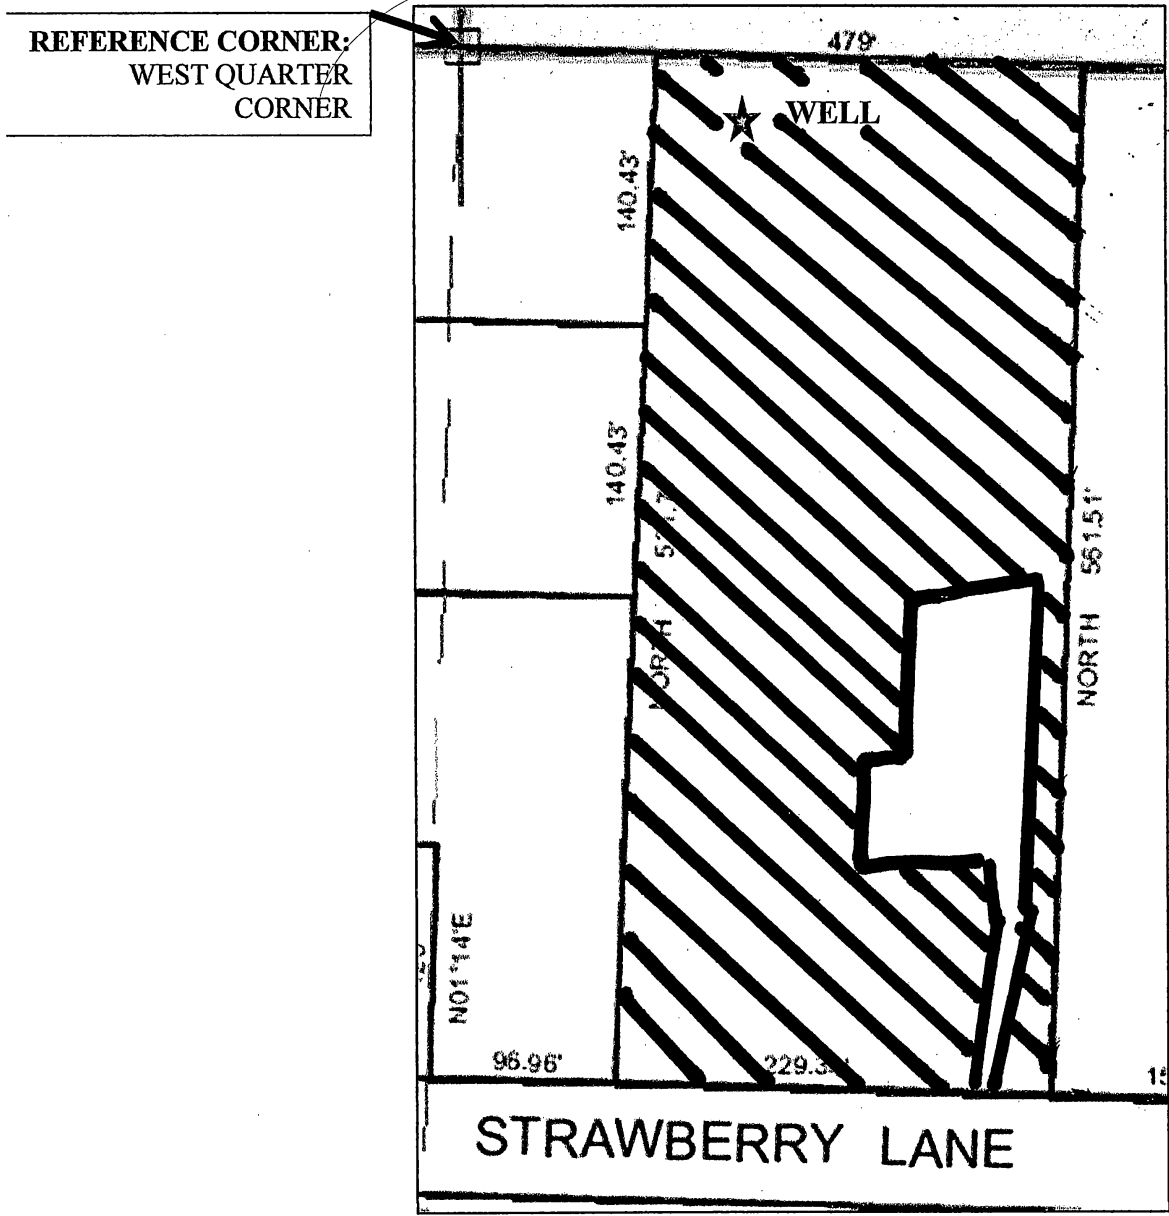

1 INCH = 100 FEET

 IRRIGATION: 1.76 ACRES

EXISTING POINT OF APPROPRIATION:
41.5 FEET SOUTH AND 147 FEET EAST OF THE REFERENCE CORNER

RECEIVED

JAN 25 2018

OWRD

G-18601