

RECEIVED
DEC 06 2018
OWRD

Scale: 1" = 1320'

Authorized Locaiton Well#3
 2560' South of NW Corner of SEC 6
 900' East of NW Corner of SEC 6

Ammended Locaiton Well#3
 2605' South of NW Corner of SEC 6
 1265' East of NW Corner of SEC 6

LEGEND



Buried Pipeline
 Well



Proposed Permit G-17865 Place of Use

APPLICATION MAP FOR PLACE OF
 USE & POINT OF APPROPRTIAON
 AMMENDMENT FOR PERMIT
 G-17865 & G-17567
 FOR
 V BOX LAND & LIVESTOCK CO.

RECEIVED BY OWRD

MAY 22 2014

SALEM, OR



SCALE: 1"=1320'

**APPLICATION MAP FOR
CHANGE IN PLACE OF USE
UNDER C-28451**

and for
**NEW GROUND WATER
FOR**

V BOX LAND & LIVESTOCK CO.

TRANSFER

- Authorized Existing POA C-28451
Well #1: 350 ft. South & 2470 ft. East
from E1/4 Cor. Section 12, T.24S., R.38E.
- C-28451 ----- 102.5 Ac.
- From Lands ----- 38.7 Ac.
- To Lands ----- 38.7 Ac.
- Remaining Rights ----- 63.8 Ac.

RECEIVED

JAN 13 2016

PREPARED BY
ROBERT D. BAGETT
217 N. CANYON BLVD.
JOHN DAY, OREGON
(541) 575-1251
FEBRUARY 13, 2014

WATER RESOURCES DEPARTMENT
SALEM, OREGON


*Well #3 - 2560' S. & 900' E. from
the NW Cor. Section 6.*

**GROUND WATER
UNDER NEW APPLICATION**

- Proposed New POA
Well #2: 3075 ft. South & 2585 ft. East
from NW Cor. Section 6, T.24S., R.39E.
- Proposed Place of Use Well #1 --- 19.8 Ac.
- Proposed Place of Use-Well #2 --- 200.8 Ac.

LEGEND

- Proposed Buried Pipeline
- *6.4 Acres from C-28451 to be Transferred
- Acres from C-28451 - Remaining Rights
- Acres per C-28451
- (300) Tax Lot

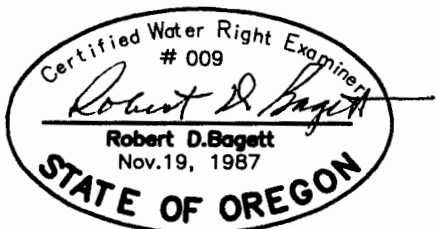

RENEWS 12/31/2015

NOTE: THIS MAP IS NOT INTENDED TO PROVIDE LEGAL DIMENSIONS OR LOCATIONS OF PROPERTY LINES.

