


Margo Lucas

1" = 1320'

Tax Lot:

Township 9 South, Range 4 West, Section 15, Tax Lot 607 & 608

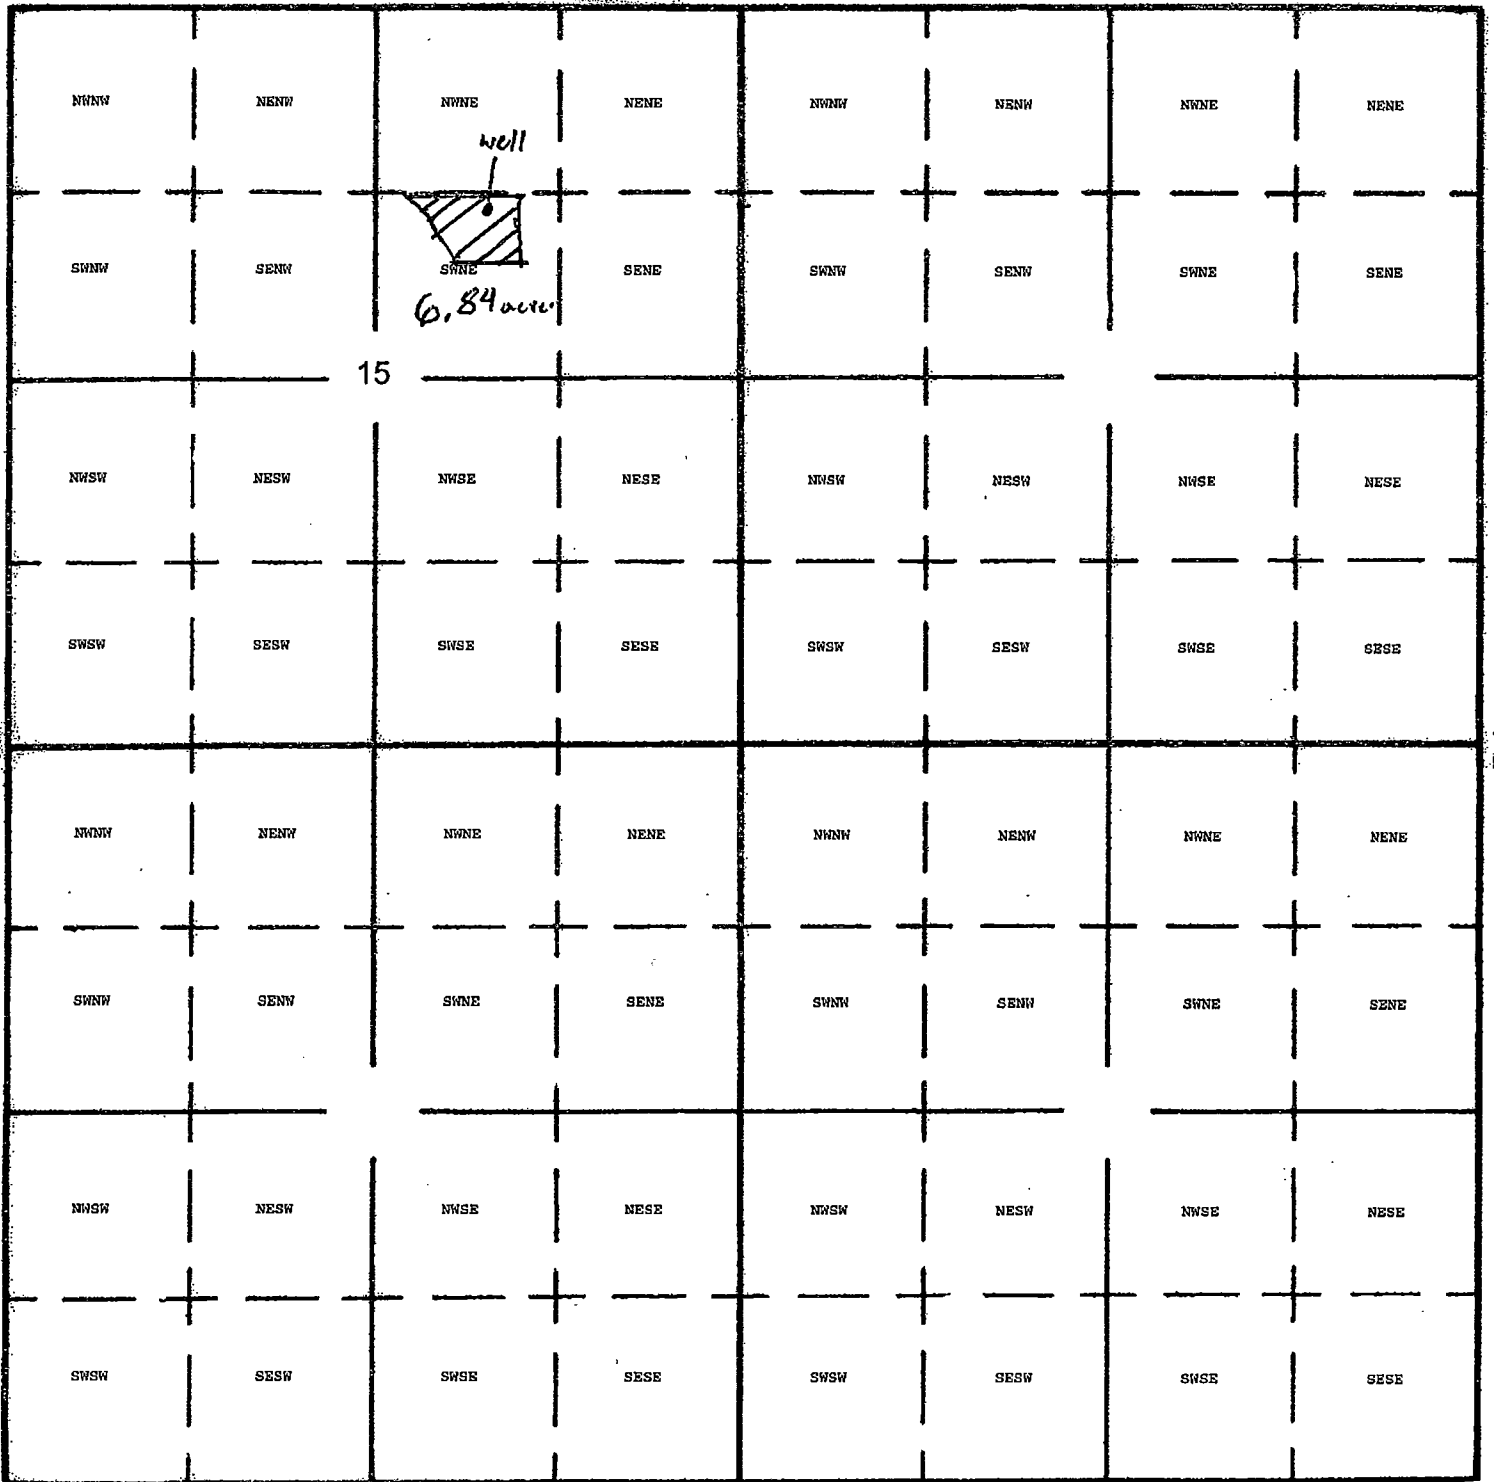

Well 1 (POLK 3884): 1390' Feet South and 1785' Feet West from NE Corner Section 15

RECEIVED

JAN 24 2018

OWRD

G-18599