


Elizabeth and Joe Thompson
 T. 16 S. R. 4 W. Sections 34 and 35
 Tax Lot 402

1" = 500'

Well LANE8306: 1515 FEET SOUTH AND 186 FEET EAST OF
 THE NW CORNER OF SECTION 35
 IRRIGATION OF 35 ACRES TOTAL

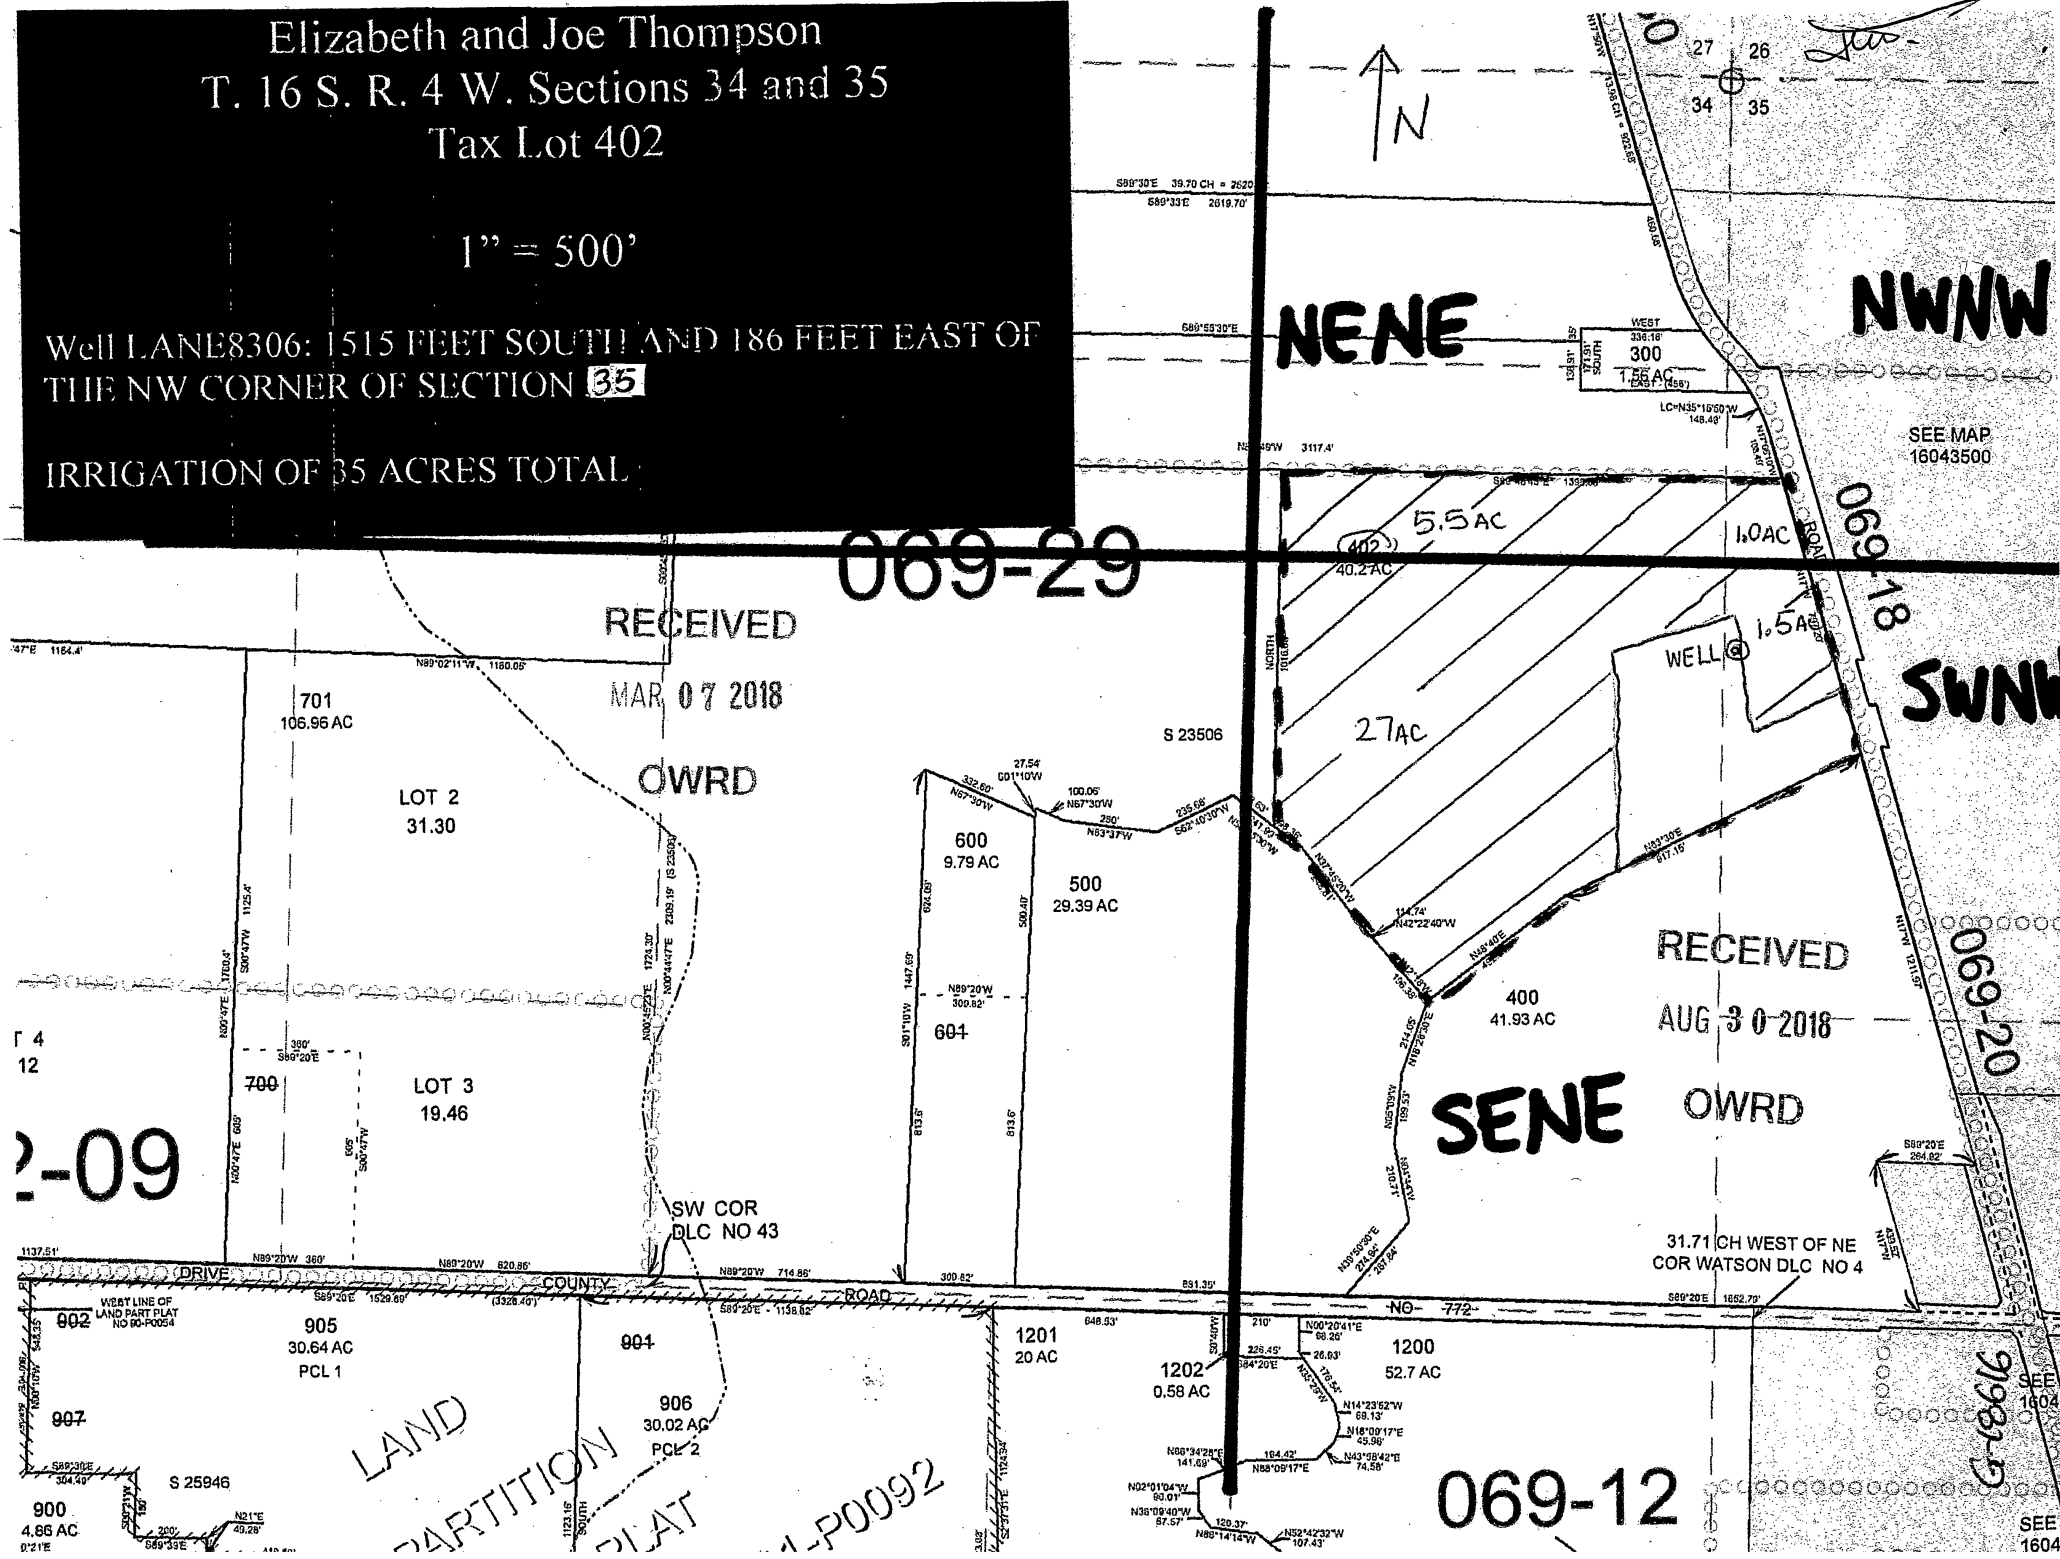

NENE

NWNW

SEE MAP
16043500

069-29

069-18

SWNW

RECEIVED
MAR 07 2018

RECEIVED
AUG 30 2018

SENE

069-20

069-09

069-12

LAND PARTITION
PLAT

PLP0092

SEE MAP
1604

SEE MAP
1604