

THIS MAP WAS PREPARED FOR ASSESSMENT PURPOSE ONLY

0 25 50 100 Feet

N.E. 1/4 S.W. 1/4 SEC. 28 T.5N. R.1W. W.M. COLUMBIA COUNTY


1" = 100'

North

05 01 28 CA COLUMBIA CITY

Cancelled: 4001

..... = Place of Use (Tax Lot 5000 not included)
- - - - = 4" Pipeline

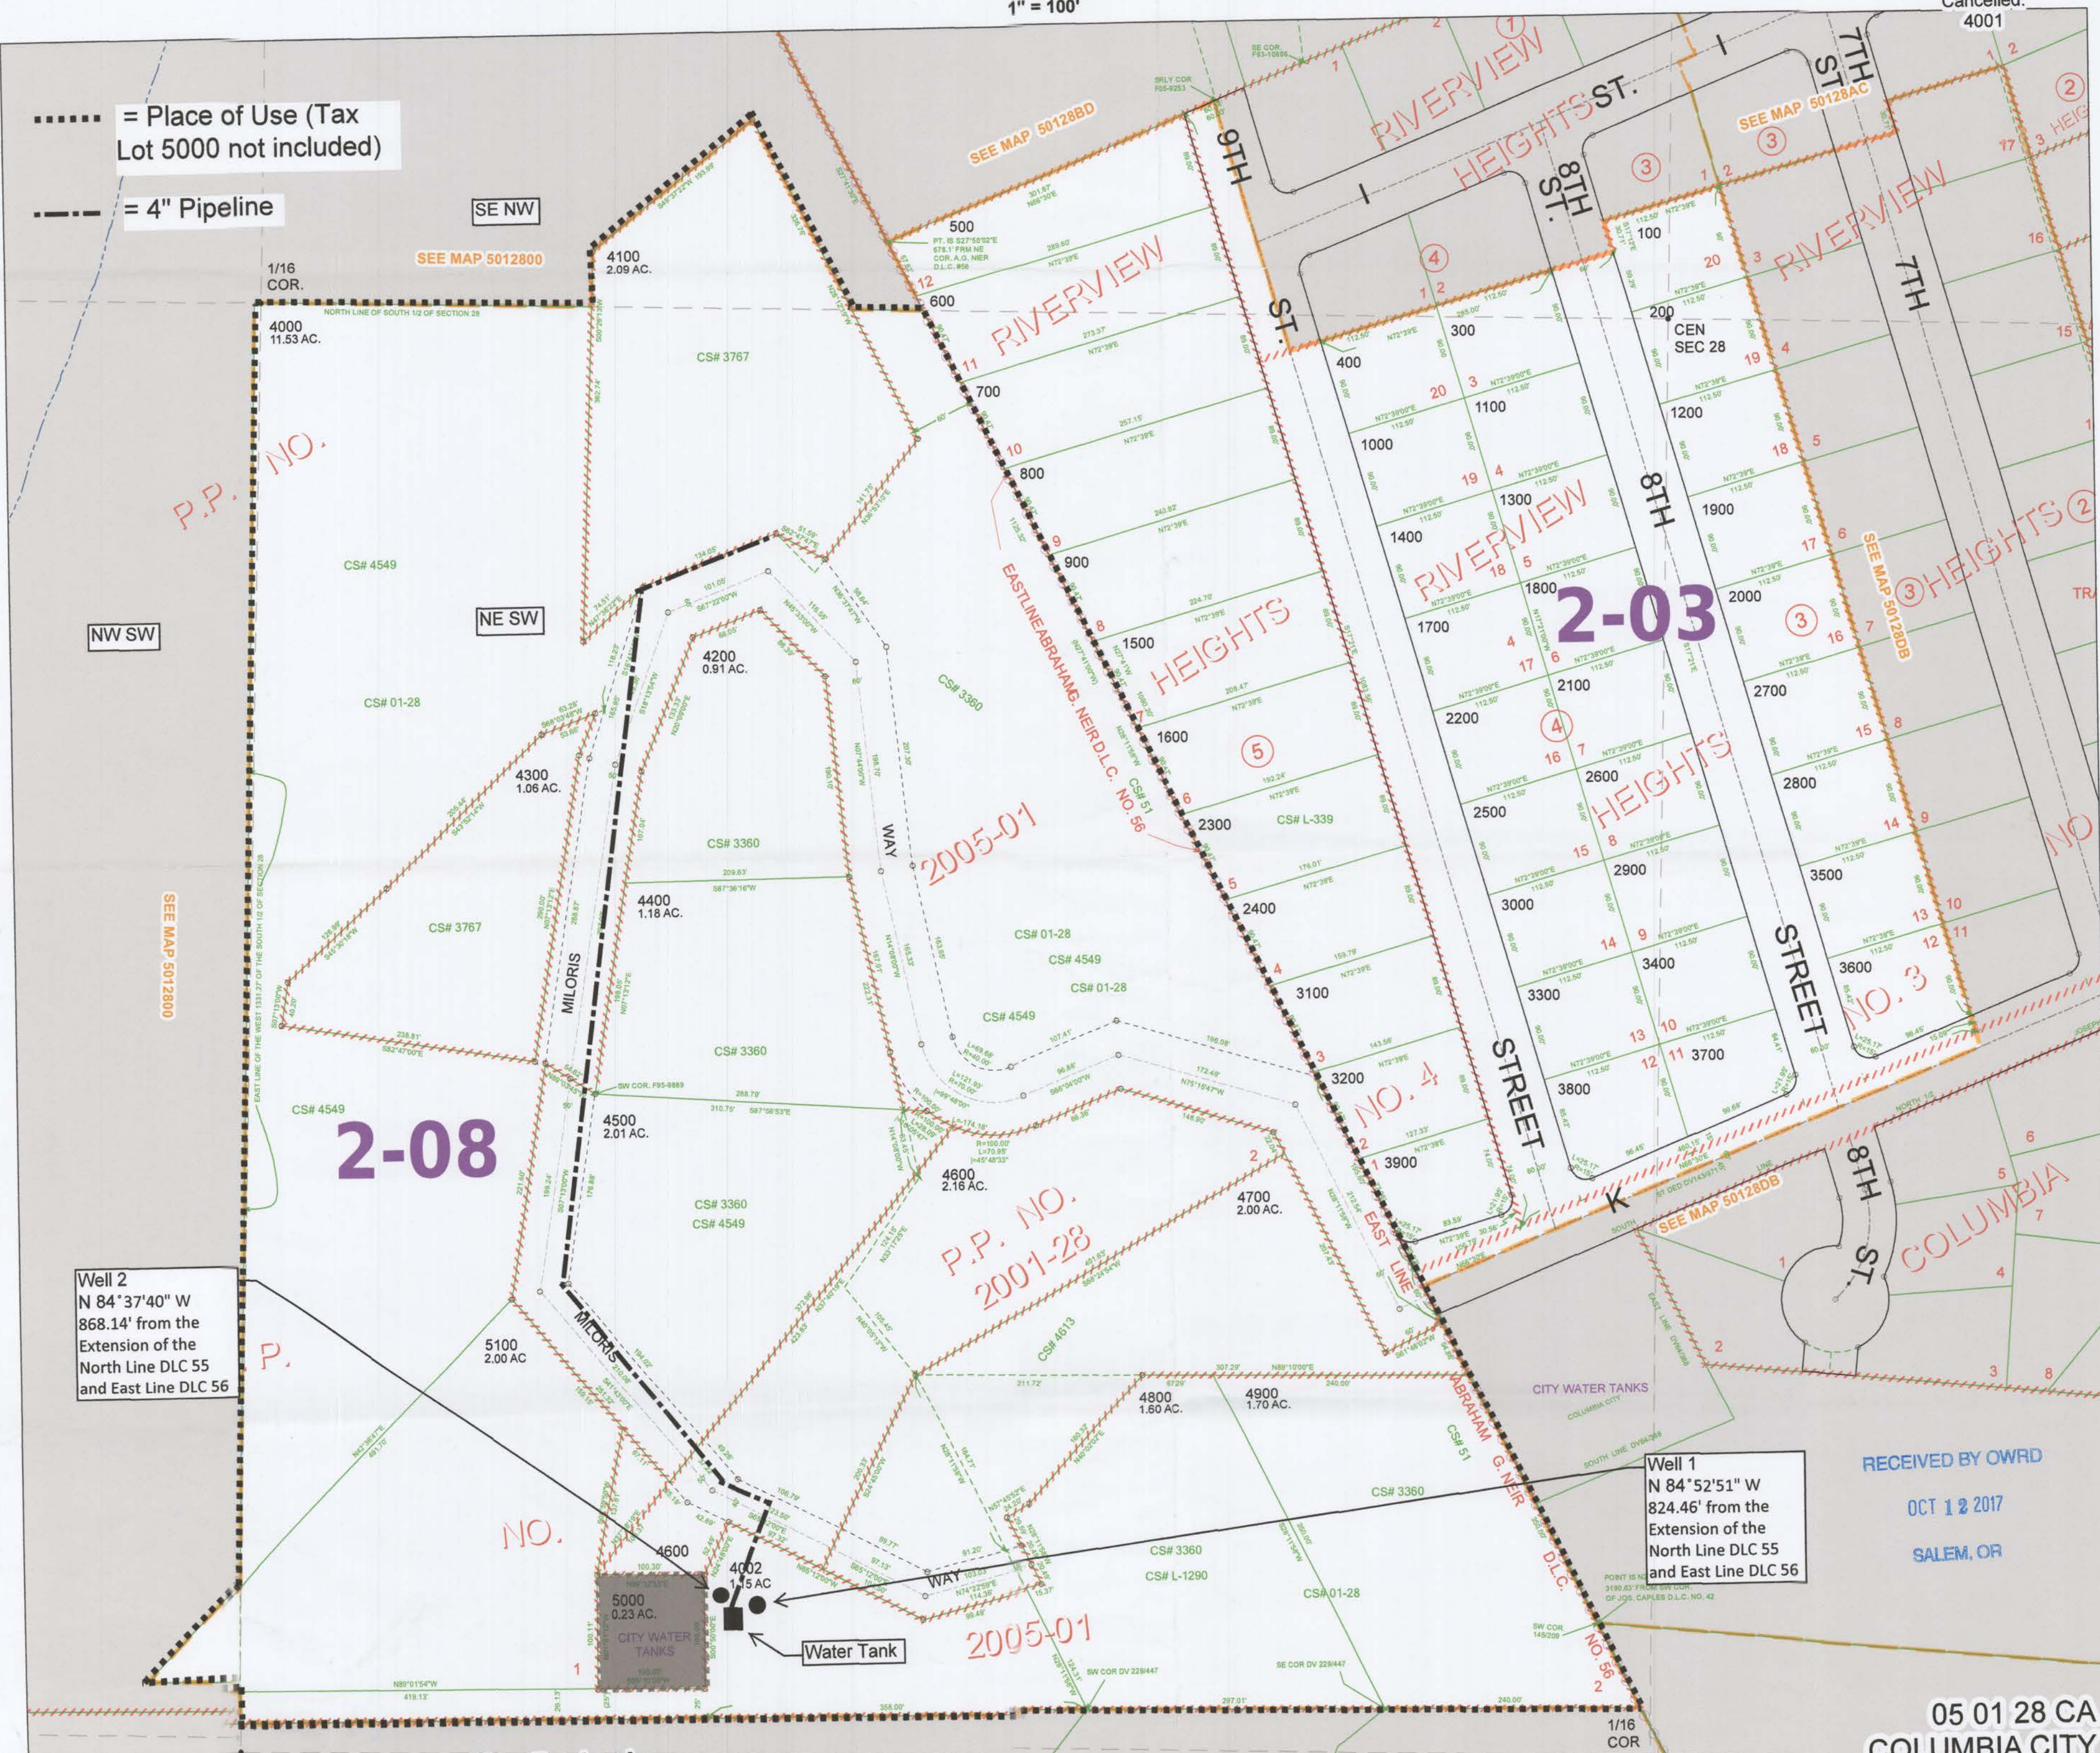

Well 2
N 84° 37' 40" W
868.14' from the
Extension of the
North Line DLC 55
and East Line DLC 56

Well 1
N 84° 52' 51" W
824.46' from the
Extension of the
North Line DLC 55
and East Line DLC 56

RECEIVED BY OWRD
OCT 12 2017
SALEM, OR

Map Revised:
10/28/2011

05 01 28 CA COLUMBIA CITY

G-18568

CEN SW 1/4

SEE MAP 5012800