T. 17 S., R. 20 E., W.M.

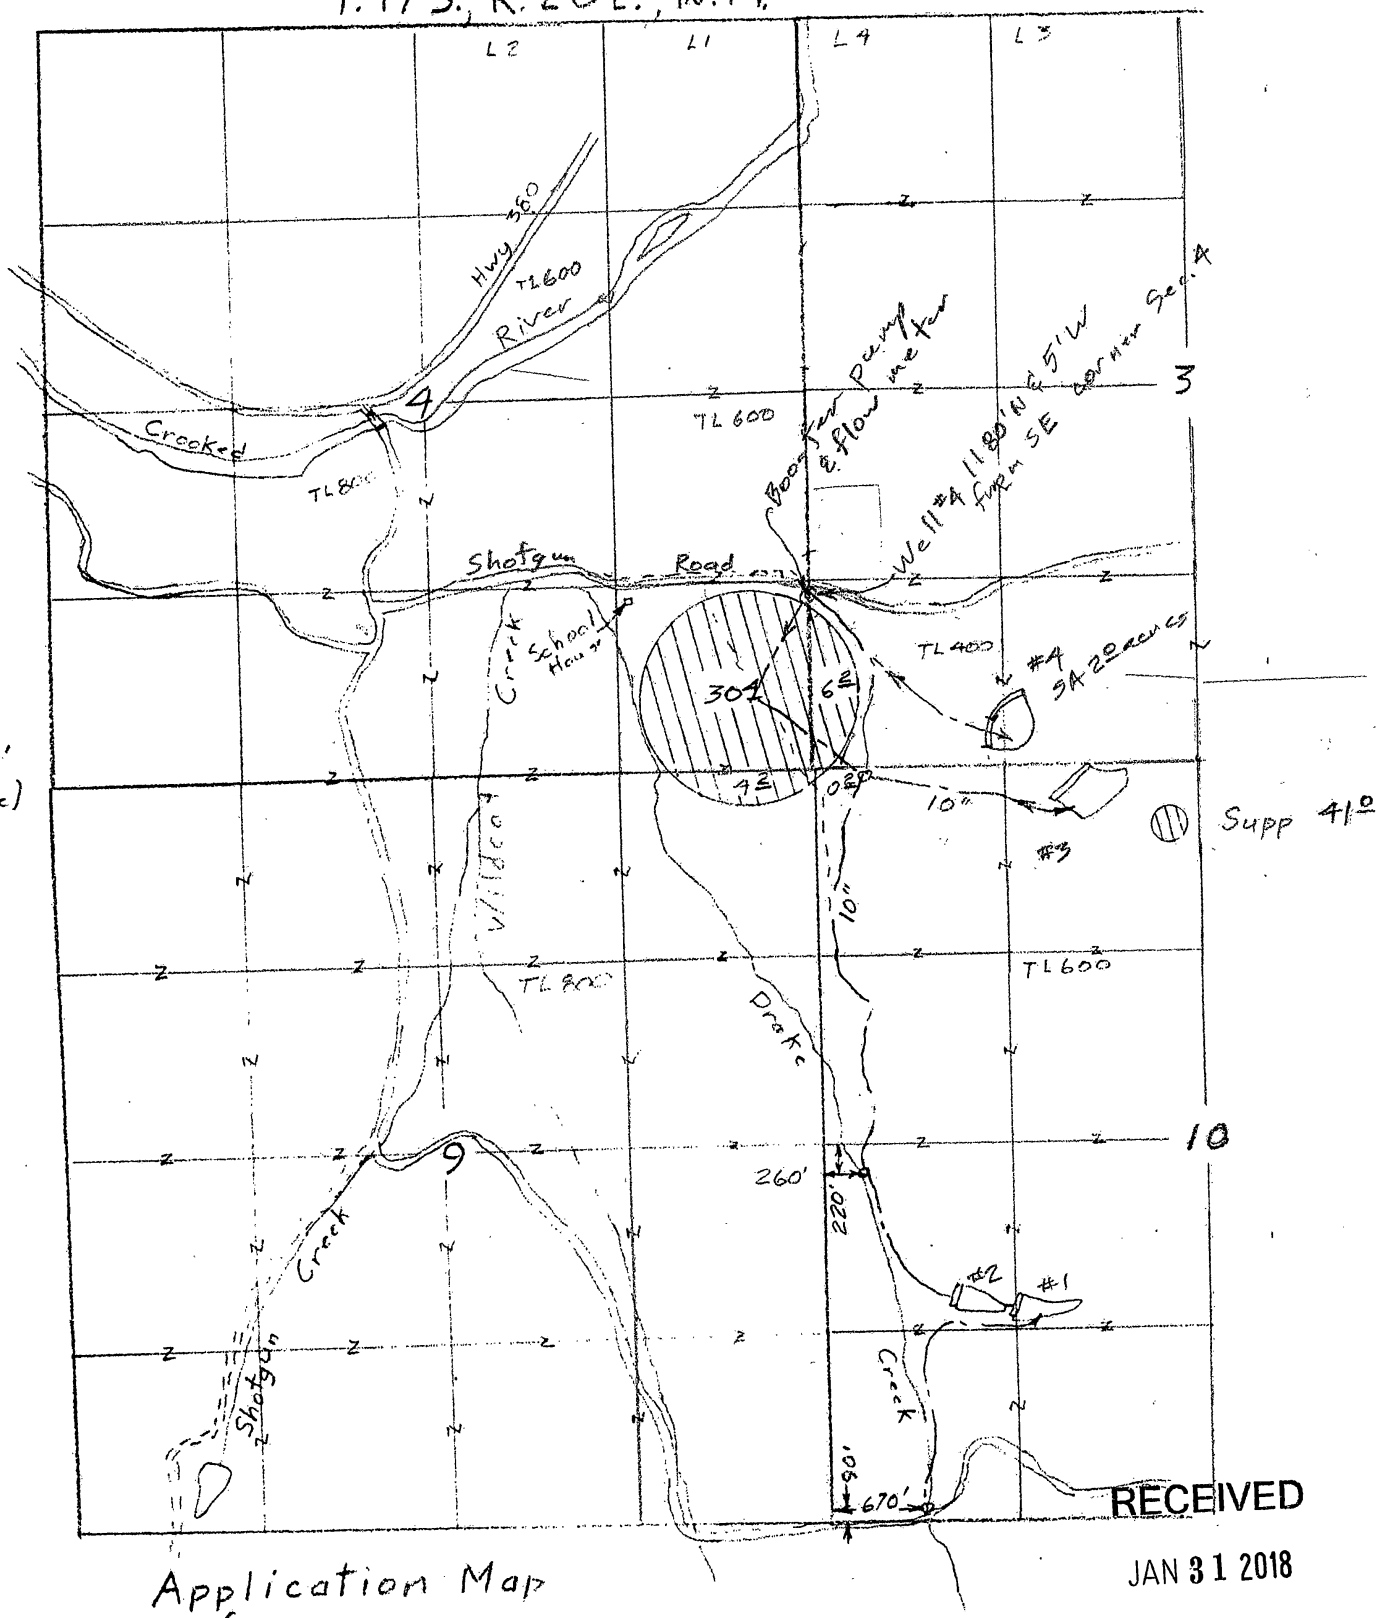

Scale
1" = 1320'
(4" = 1 mile)

RECEIVED
JAN 31 2018
OWRD

Application Map
for
Shotgun Ranch, LLC

This map is for the purpose of locating a water right only and has no intent to provide legal dimensions or the locatior of property lines.

Certified Water Right Examiner
#1
Bruce A. Estes
Nov 19, 198
STATE OF OREGON
Renewal Dec 31, 2018

ESTES SURVEYS, LLC
~~PO Box 17510~~
~~Salem, OR 97305-7510~~
~~(503) 585-7508~~
60382 Arnold Rd
Bend, OR 97702
(541) 382-7391

G-18604