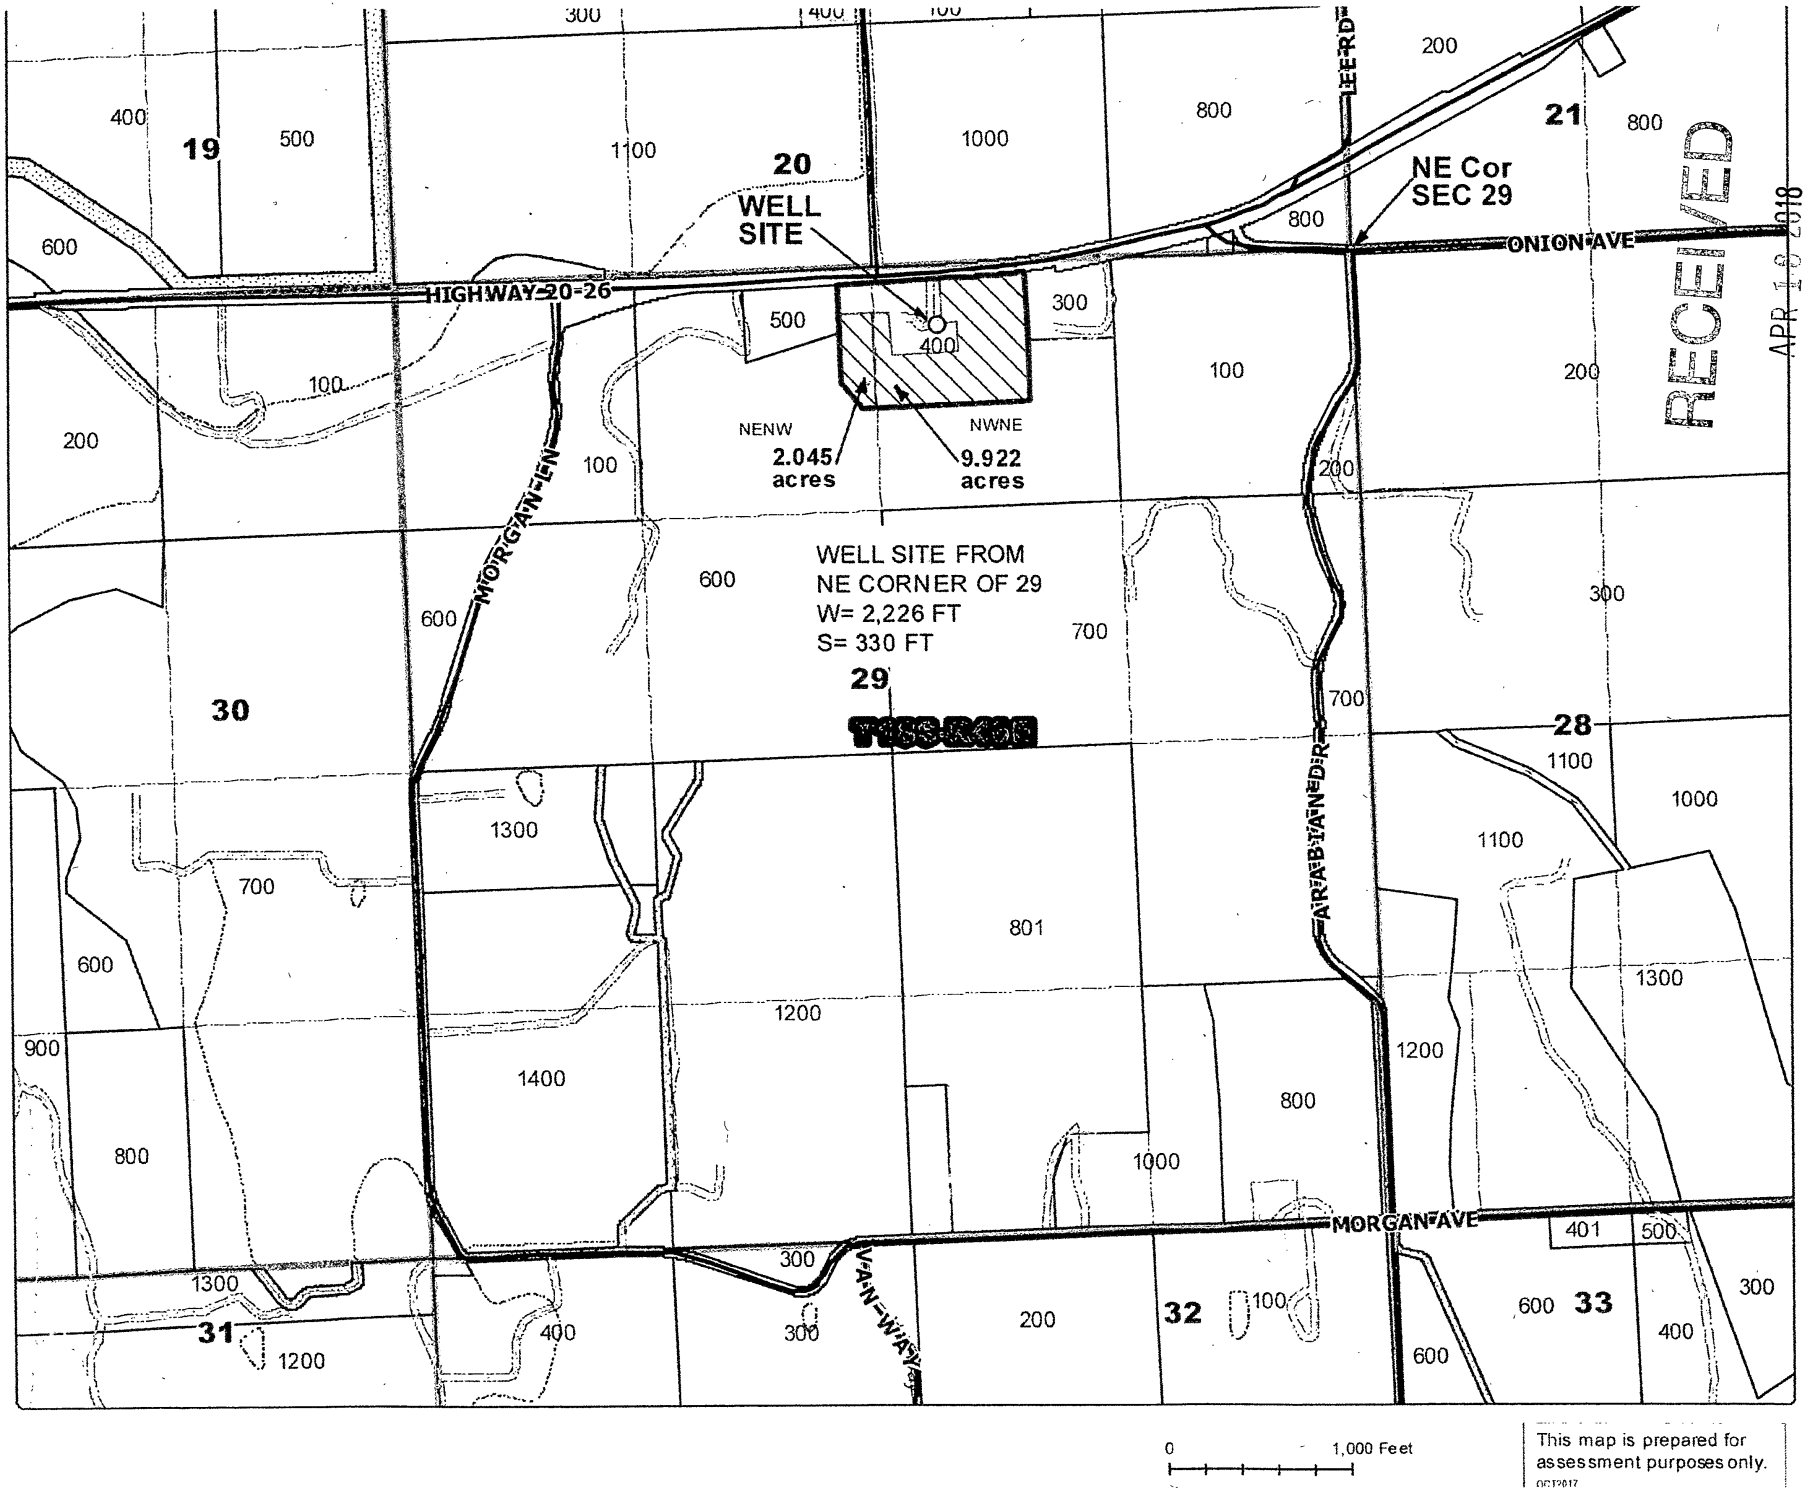
WELL SITE
NE Cor SEC 29
HIGHWAY 20-26
ONION AVE
LEE RD
MORGAN LN
NENW
2.045 acres
NWNE
9.922 acres
WELL SITE FROM
NE CORNER OF 29
W= 2,226 FT
S= 330 FT
MORGAN AVE
VAN WAY
19
20
21
28
29
30
31
32
33
0
1,000 Feet
This map is prepared for assessment purposes only.
OCT 2017
RECEIVED
APR 10 2018
BOARD
N