


18781


THIS MAP WAS PREPARED FOR ASSESSMENT PURPOSE ONLY

 

SECTION 23 T.20S. R.46E. W.M. MALHEUR COUNTY

20S46E23

1 1/2 in = 1320 Aprox

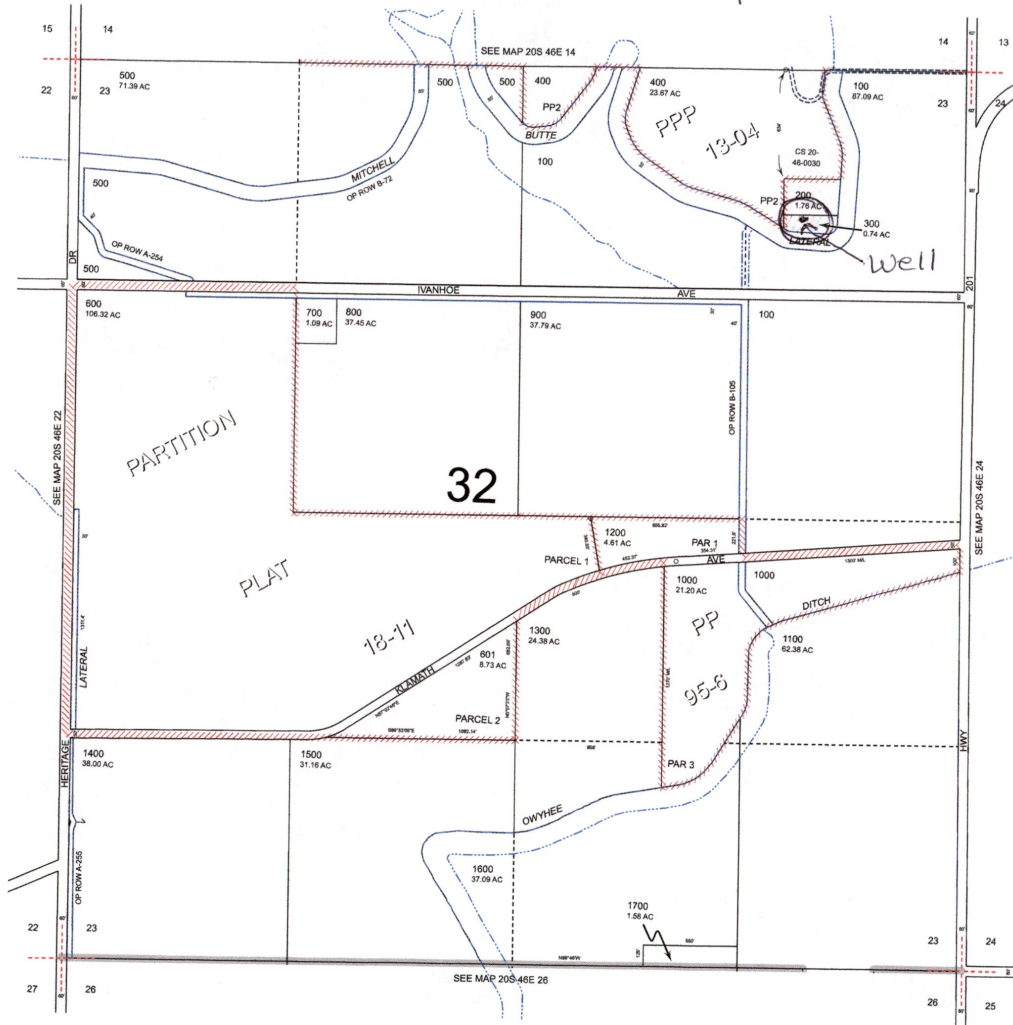

902 ft W and 823 ft S from the NE NE of section 23


NORTH ↑

RECEIVED DEC 31 2018  
RECEIVED JAN 22 2019  
OWRD

Revised: MA 10/10/2018

20S46E23

Section 23 Township 20S, Range 46E, Tax Lot # 300

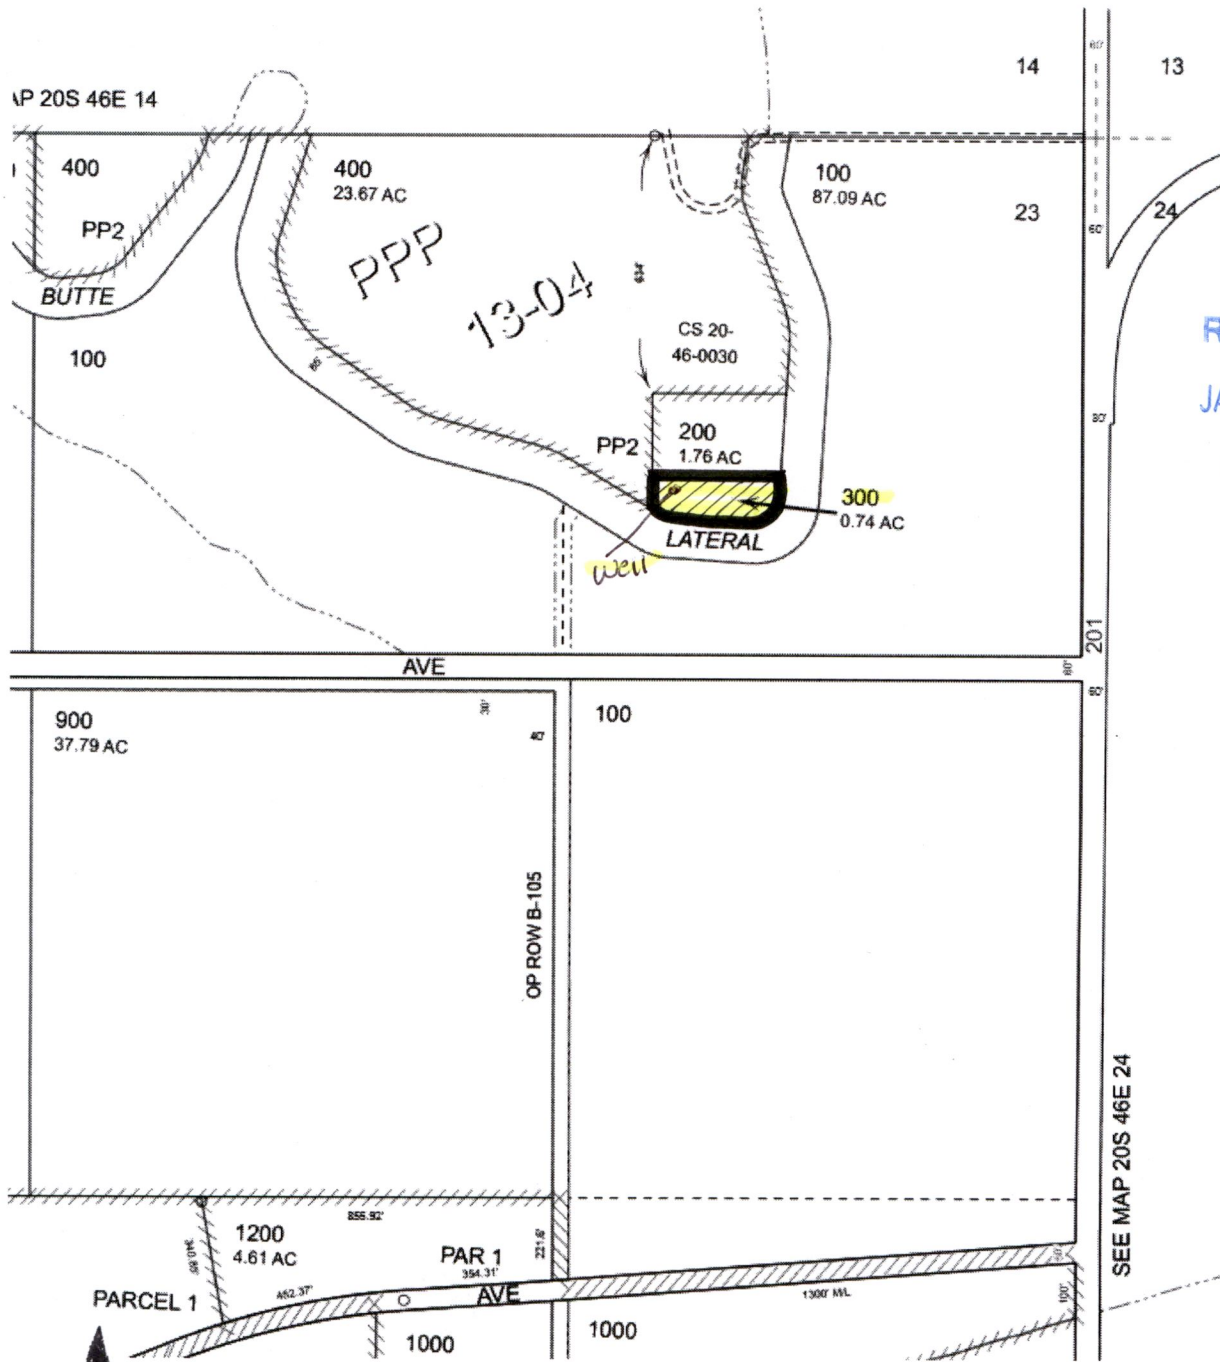

RECEIVED  
 JAN 22 2019  
 OWRD

SEE MAP 20S 46E 24



Commissions of  
 MALHEUR COUNTY  
 TITLE COMPANY INC  
 Map No. 204623  
 Tax Lot 300  
 This sketch is furnished  
 to assist in property  
 location and the company  
 assumes no liability  
 for its accuracy

Malheur County  
 Title Company Inc.  
 81 S. Oregon St.  
 Ontario, Oregon 97914

G-10781