


Survey Map

T. 11S R. 4W
BENTON COUNTY

S $\frac{6}{7}$

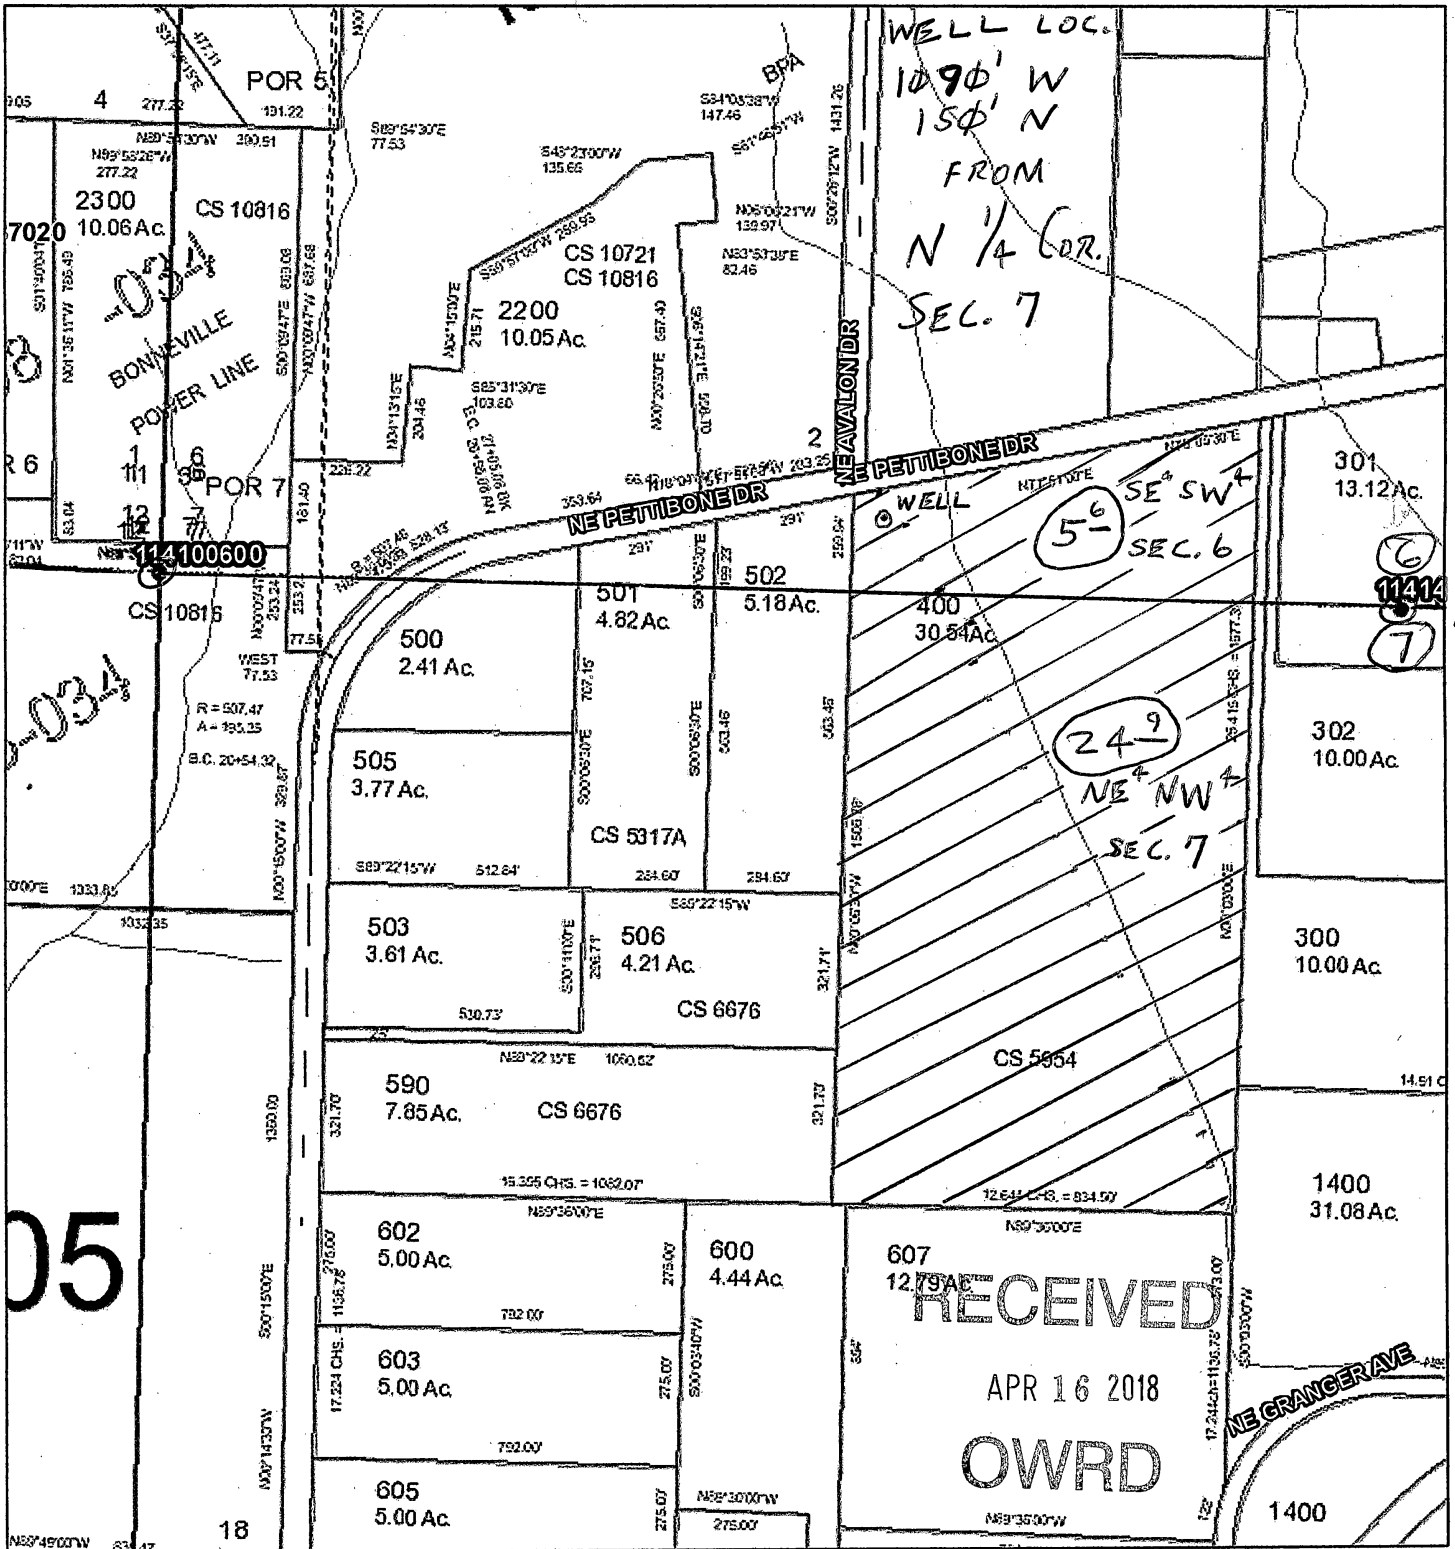

3/16/2018, 12:35:54 PM

1:4,800 1" = 400'

ArcGIS_Public.SDE.sectionlines

— SEC-LINE

— TWP-LINE

□ TaxlotOwners

ArcGIS_Public.SDE.Roads

● ArcGIS_Public.SDE.section_comer_index


Donation Land Claims

ArcGIS_Public.SDE.survey_index

□ Hydro_polys

— Hydro_lines

□ Cities and Places

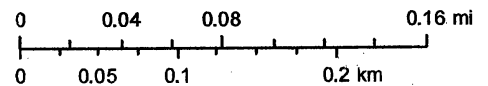

Benton County, Oregon
Benton County, Oregon - Assessor's Department

G-18652