


G-18752

June 13th, 2019

1" = 880'

Proposed modified location
 of Well #2 - Moved closer
 to R-O-W of 3 lakes road and
 on south side of BPA transmission lines.

A-18752 ver'd 10.14.19

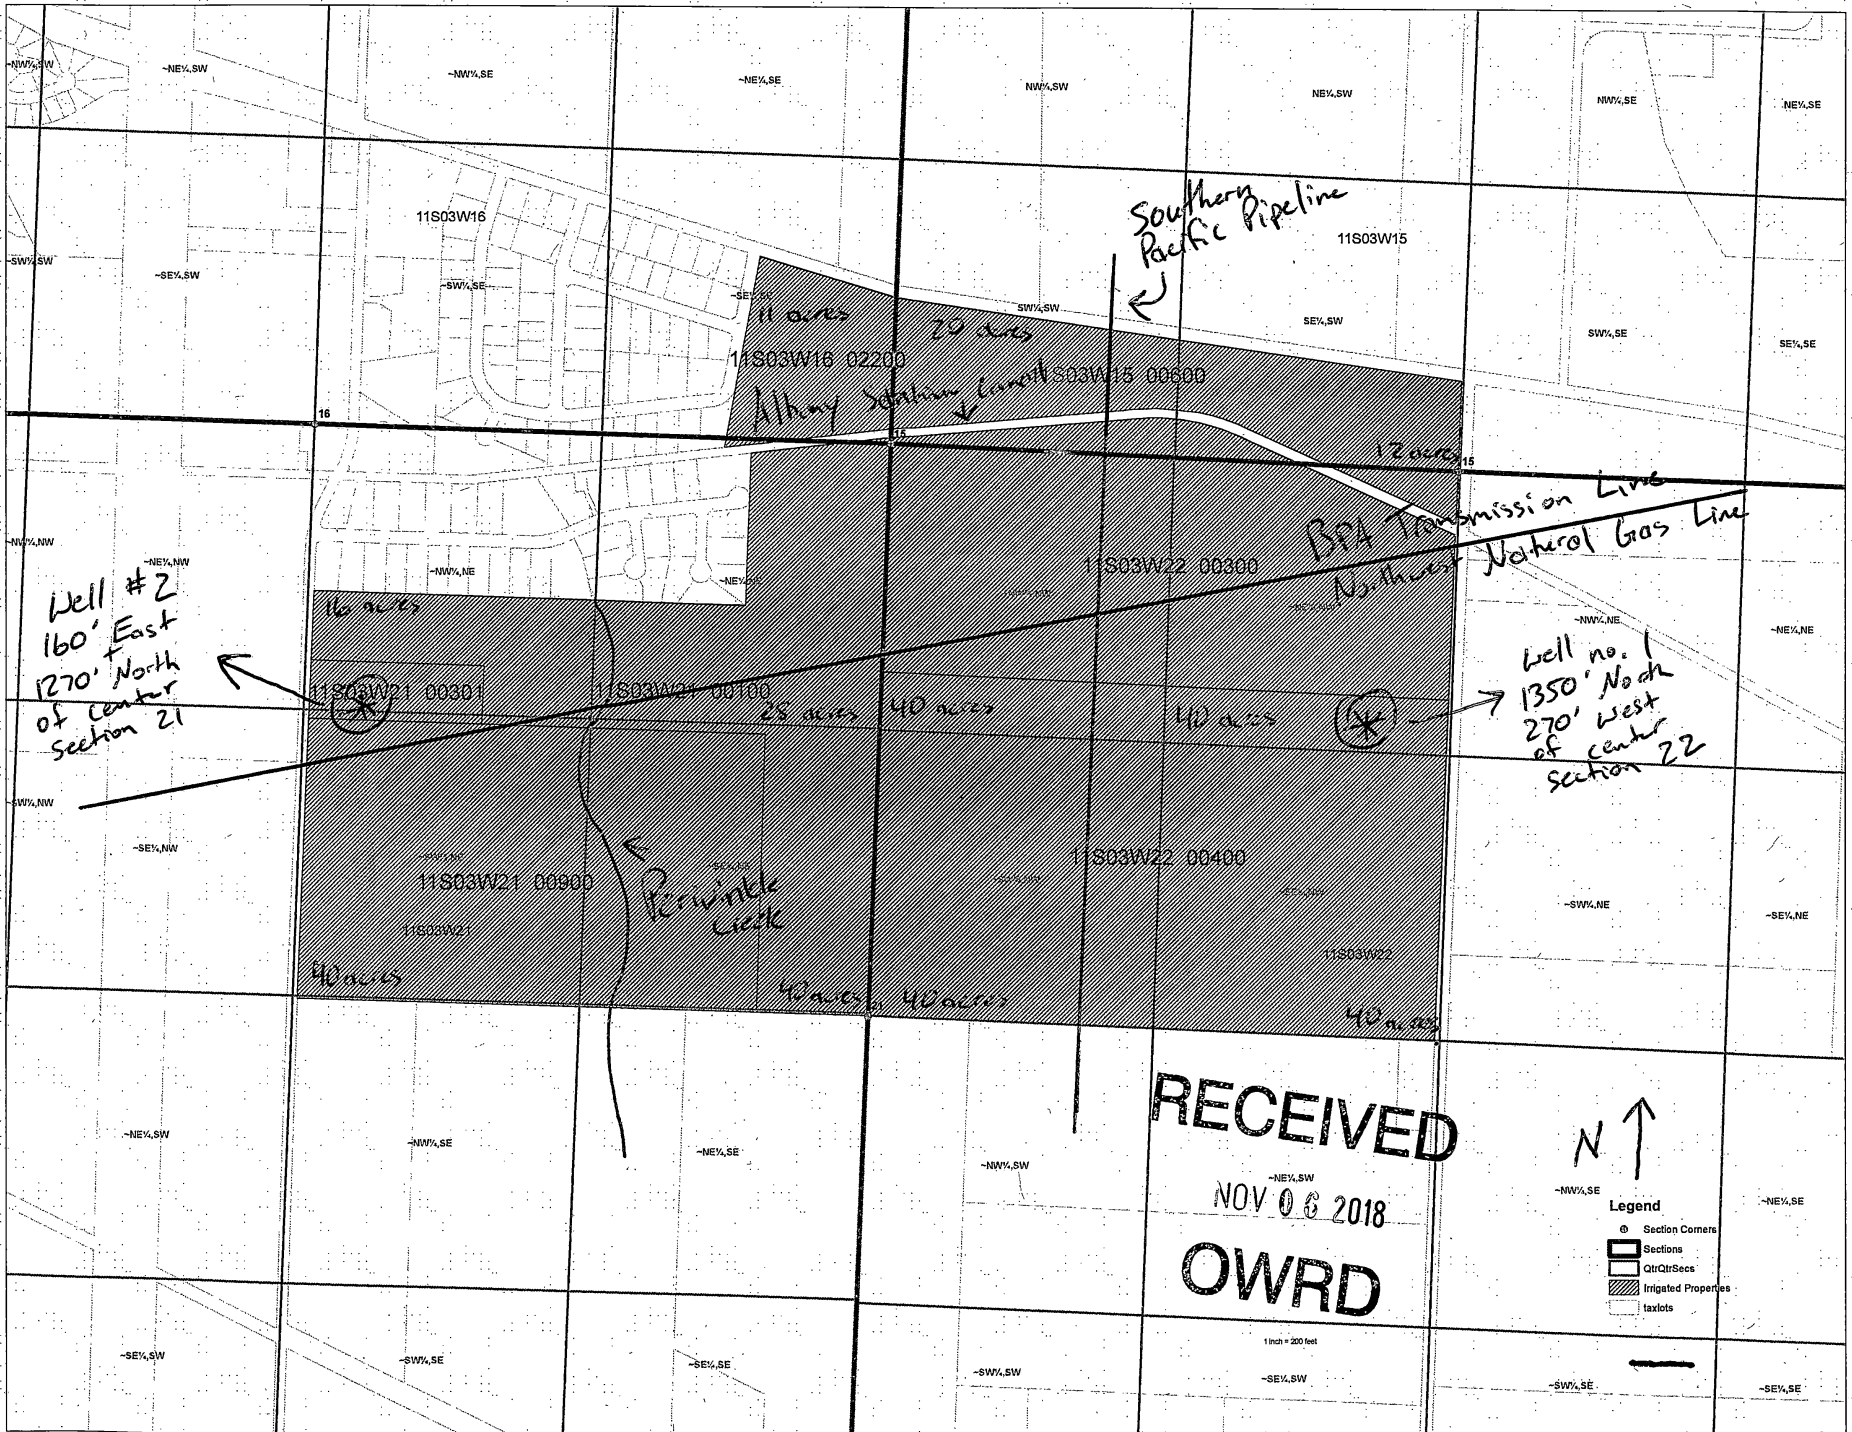

G-10752

1" = 880'