


T. 7 S., R. 2 W., WM

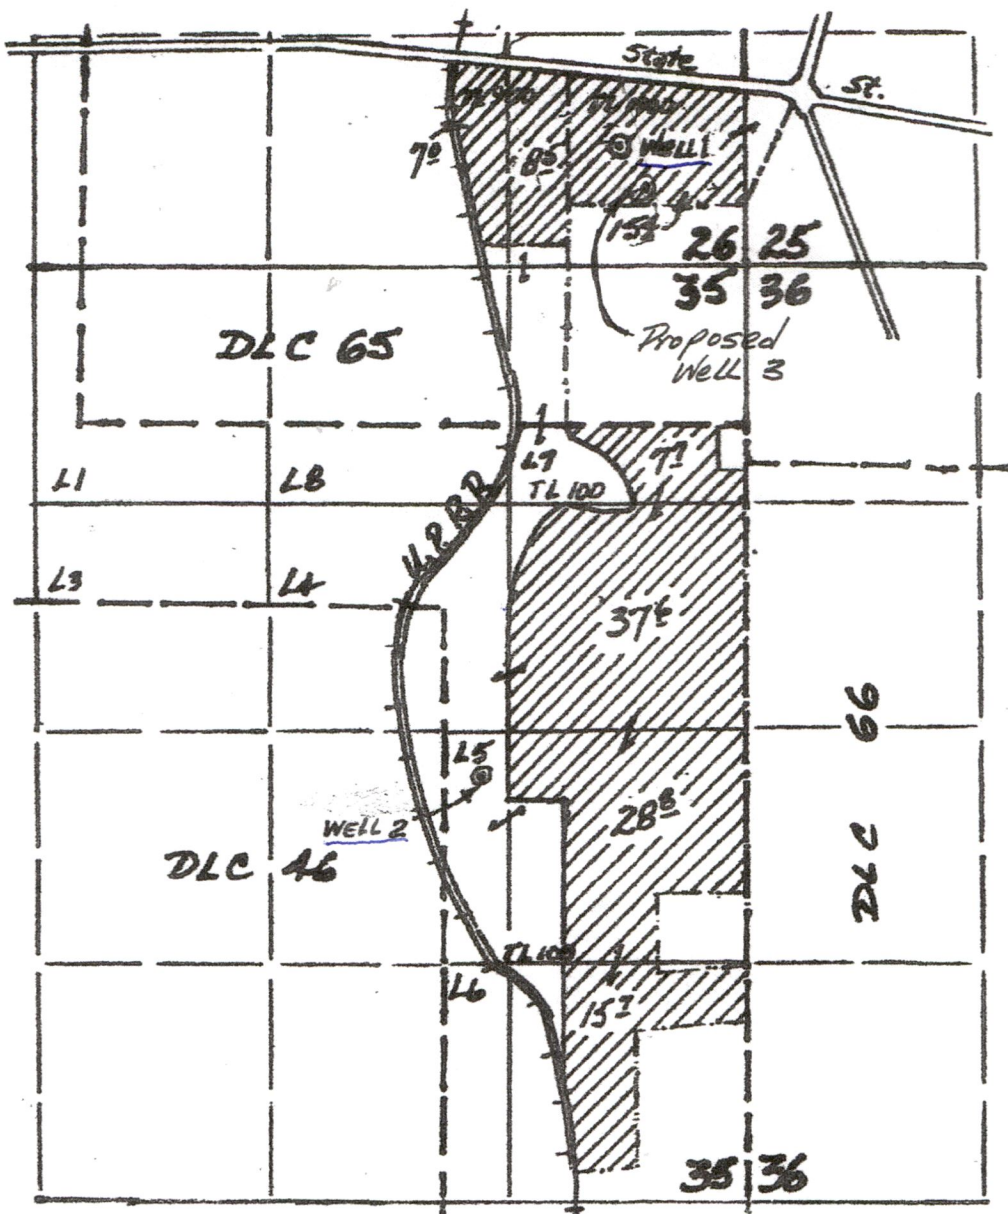

Map to Accompany Application
For Amendment of Permit G-17889,
In the Name of Richard Kraft

POD's Located: Well 1- 670' N & 700' W;
Well 2- 2880' S & 1480' W.; } All from the NE Cor. Sec. 35
Proposed well 3 - 450' N. & 580' W.