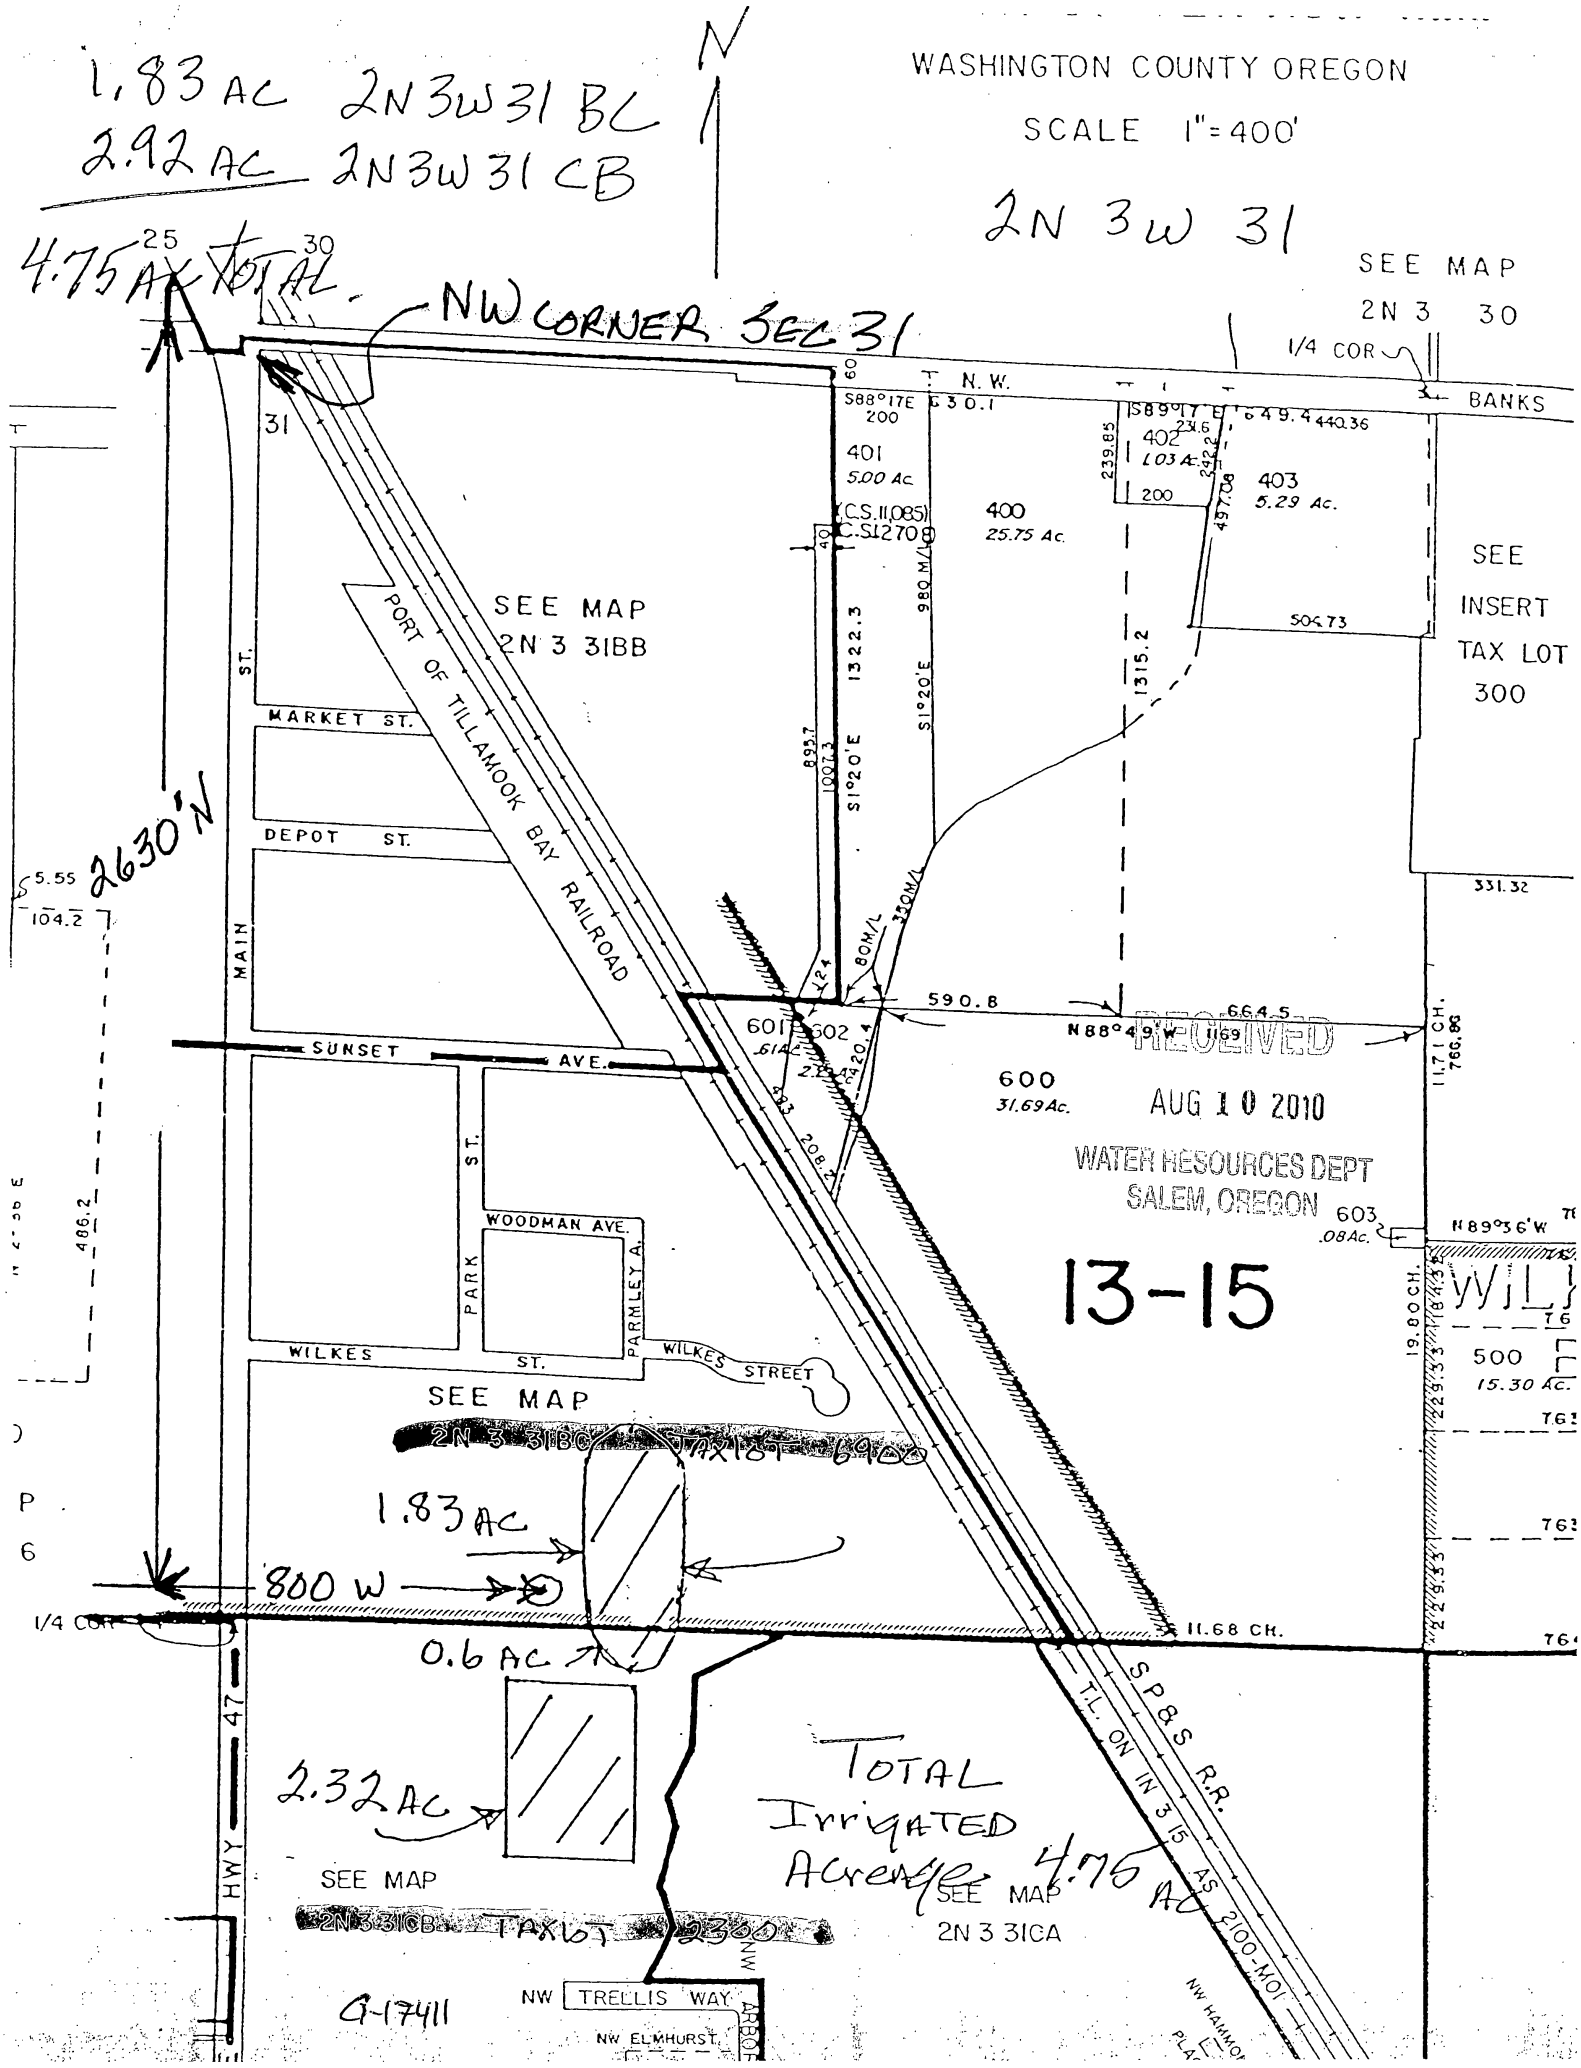

1.83 AC 2N3W31 BC
2.92 AC 2N3W31 CB
4.75 AC TOTAL
N
WASHINGTON COUNTY OREGON
SCALE 1"=400'
2N 3W 31
NW CORNER SEC 31
SEE MAP 2N 3 30
1/4 COR
BANKS
N.W.
401 5.00 Ac.
400 25.75 Ac.
402 1.03 Ac.
403 5.29 Ac.
SEE INSERT TAX LOT 300
SEE MAP 2N 3 31BB
PORT OF TILLAMOOK BAY RAILROAD
MARKET ST.
DEPOT ST.
MAIN ST.
SUNSET AVE.
WOODMAN AVE.
PARK ST.
PARMLEY A.
WILKES ST.
WILKES STREET
2630'N
601
602
600 31.69 Ac.
603 .08 Ac.
500 15.30 Ac.
RECEIVED
AUG 10 2010
WATER RESOURCES DEPT
SALEM, OREGON
13-15
SEE MAP 2N 3 31BC TAX LOT 6900
1.83 AC
800 W
0.6 AC
2.32 AC
TOTAL Irrigated Acreage 4.75 AC
SEE MAP 2N 3 31CB TAX LOT 2300
SEE MAP 2N 3 31CA
SP&S R.R.
T.L. ON IN 3 15 AS 2100-M01
HWY 47
NW TRELLIS WAY
NW ELMHURST
G-17411