


T. 37 S. R. 5 W. 11 A.

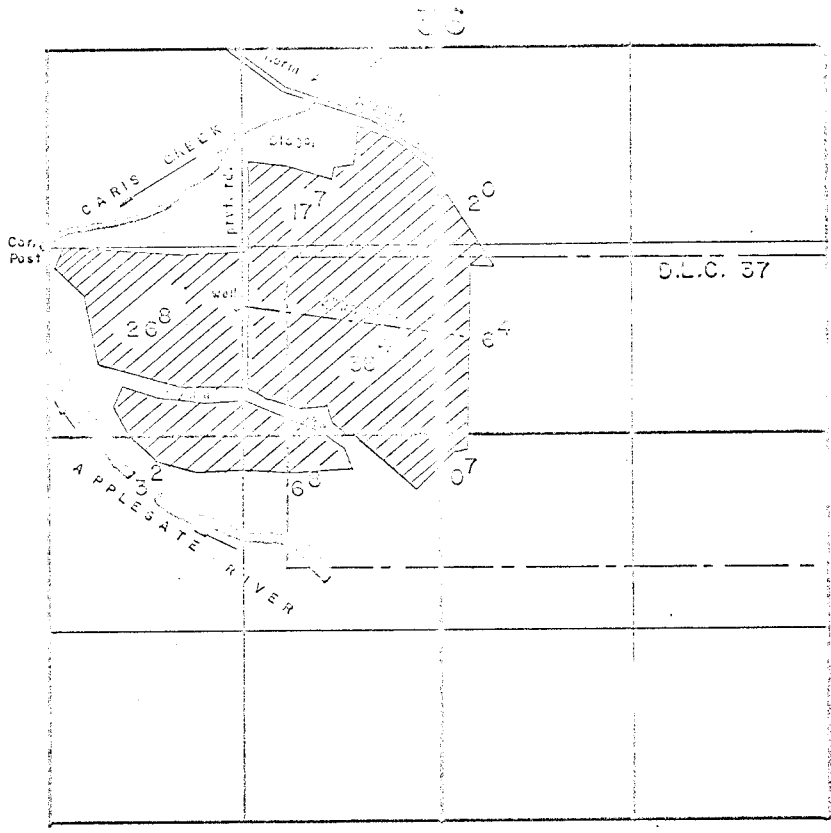

T. 38 S. R. 5 W. 11 A.

FINAL PROOF SURVEY
UNDER

Application No. 911220, Permit No. 2-1880
IN NAME OF

.....

Surveyed APRIL 20 1932, by R. L. GILMAN