

THIS MAP WAS PREPARED FOR ASSESSMENT PURPOSE ONLY

0 25 50 100 Feet

# N.E. 1/4 S.W. 1/4 SEC. 28 T.5N. R.1W. W.M. COLUMBIA COUNTY

1" = 100'


North

05 01 28 CA  
COLUMBIA CITY

Cancelled:  
4001

..... = Place of Use (Tax Lot 5000 not included)

--- = 4" Pipeline

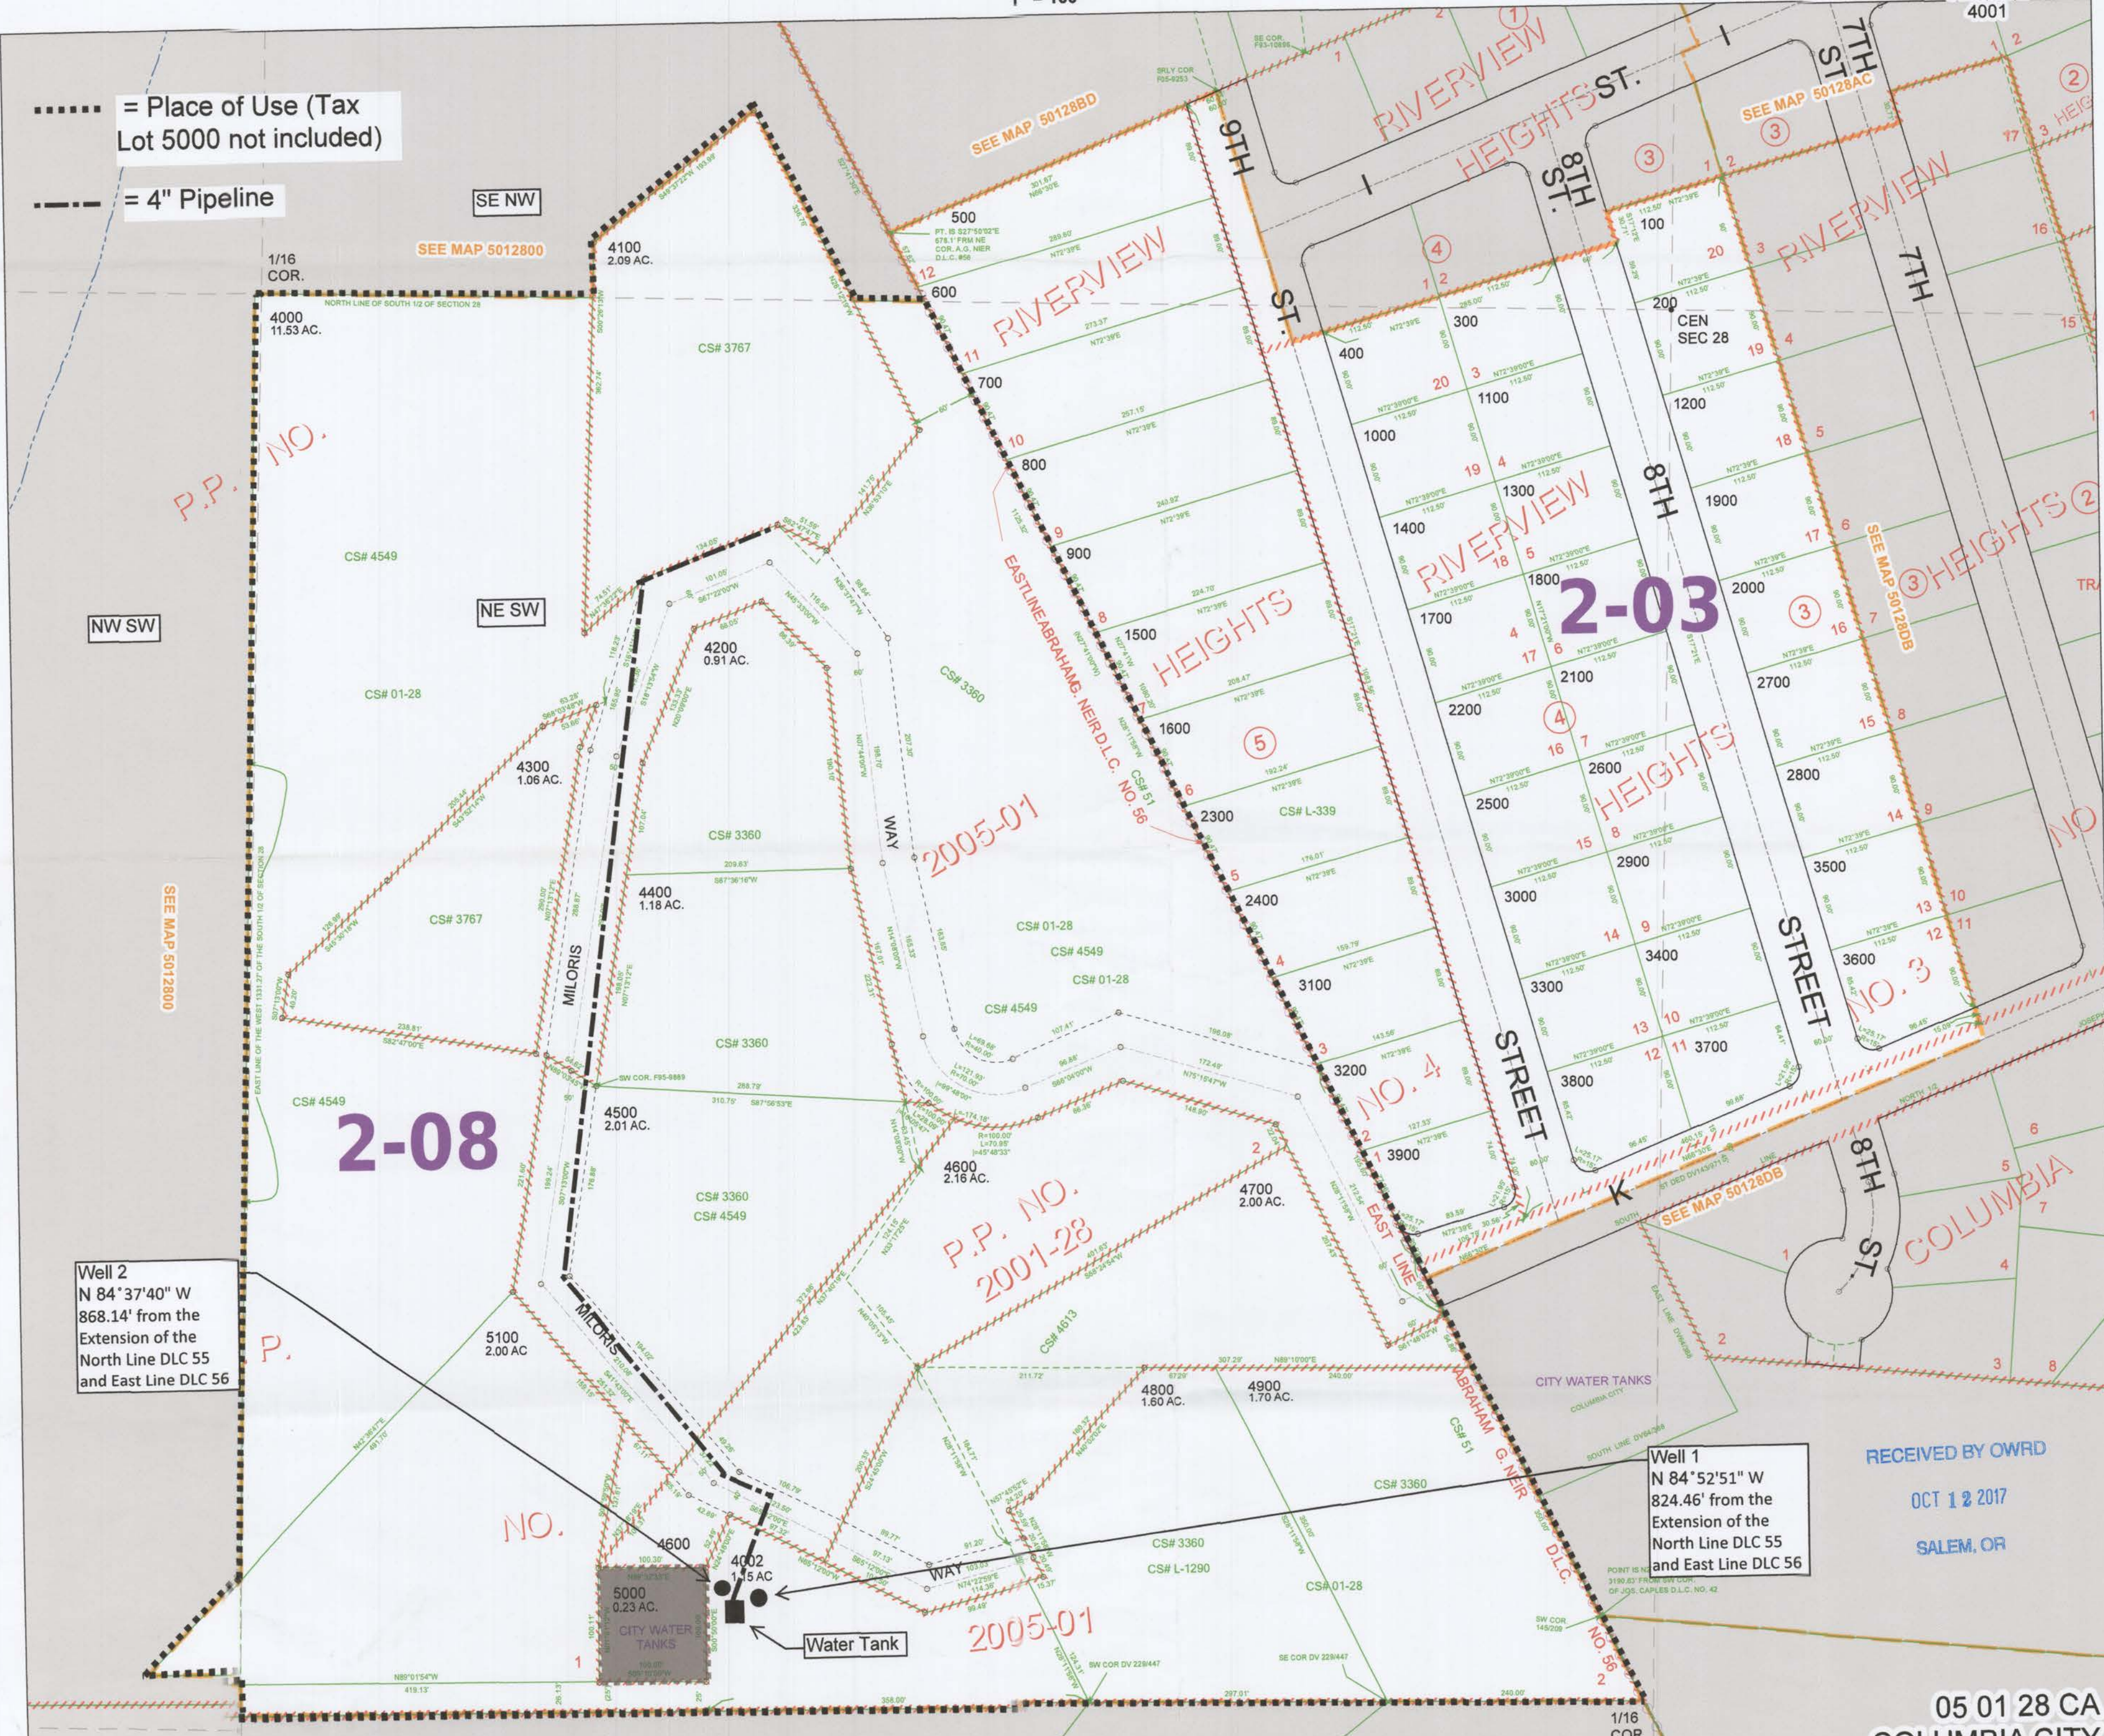

Well 2  
N 84° 37' 40" W  
868.14' from the  
North Line DLC 55  
and East Line DLC 56

Well 1  
N 84° 52' 51" W  
824.46' from the  
Extension of the  
North Line DLC 55  
and East Line DLC 56

RECEIVED BY OWRD  
OCT 12 2017  
SALEM, OR

Map Revised:  
10/28/2011

05 01 28 CA  
COLUMBIA CITY

G-18568

CEN SW 1/4

SEE MAP 5012800