


Application for a Permit Amendment (G-15505) A Permit in the Name of Bob Holding Co, LLC

Polk County, Oregon
Township 8 South, Range 4 West (W.M.)

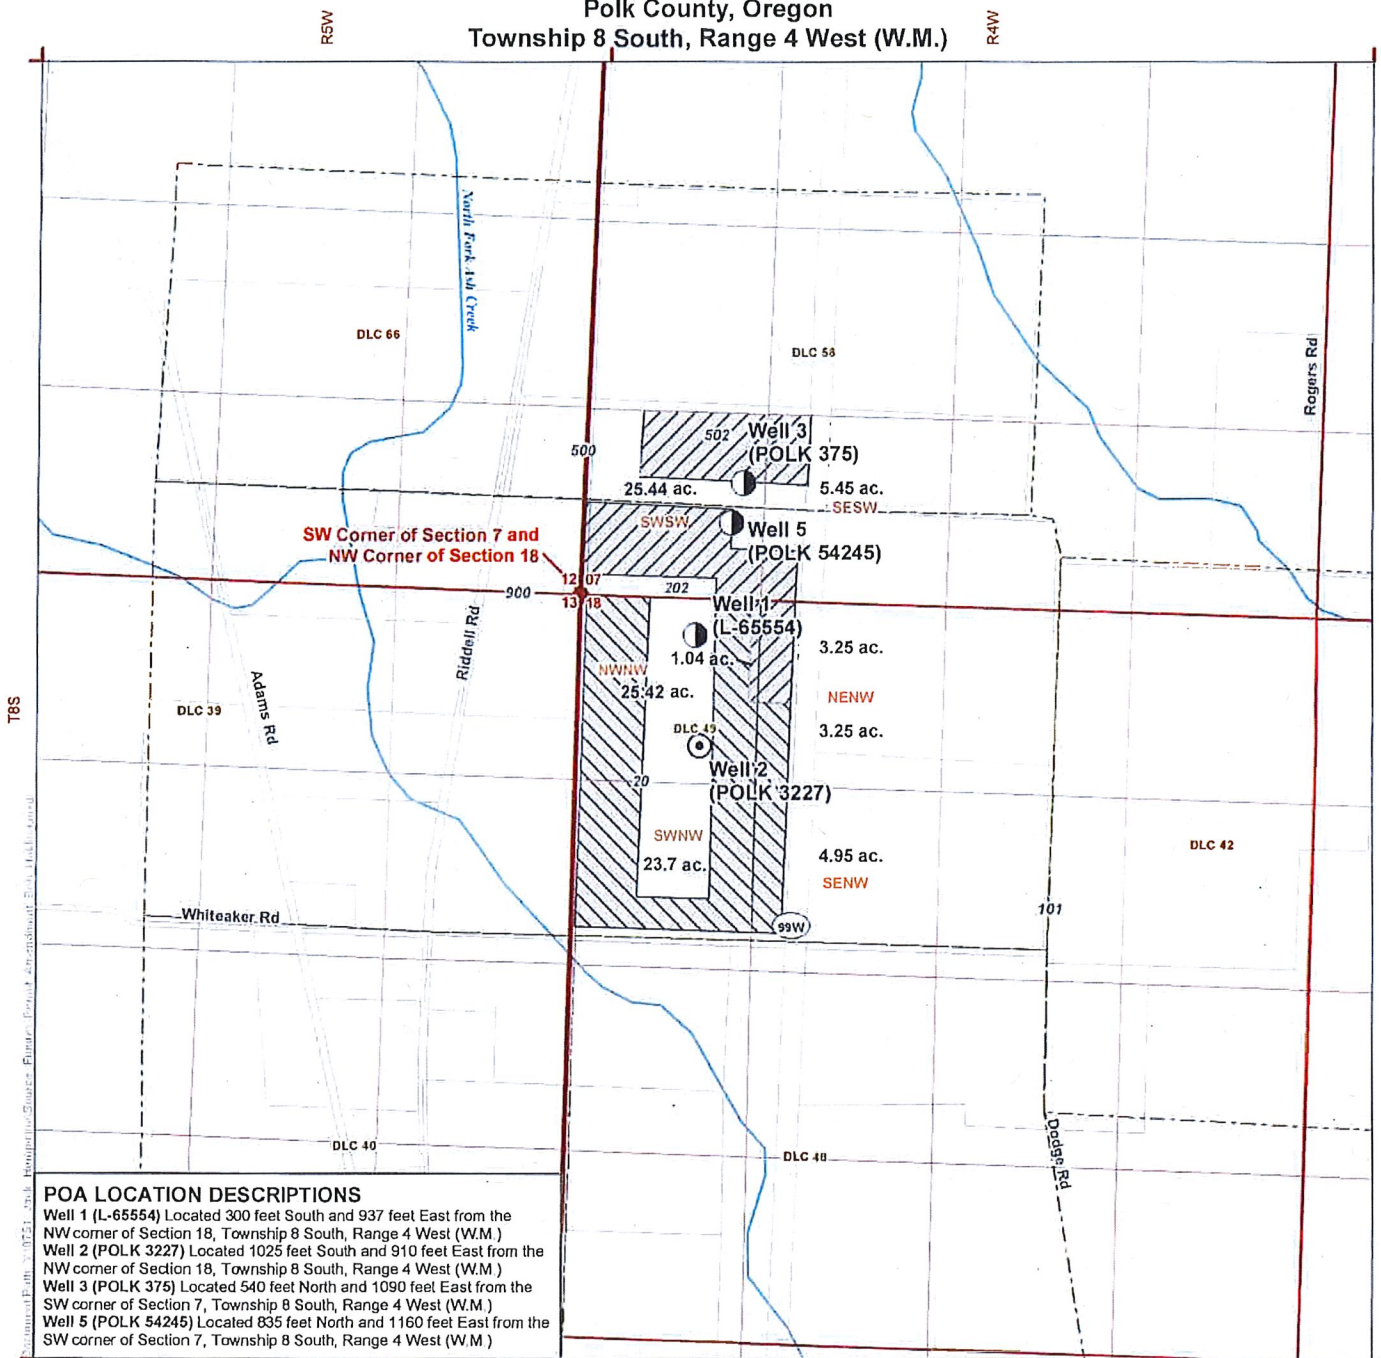

POA LOCATION DESCRIPTIONS
 Well 1 (L-65554) Located 300 feet South and 937 feet East from the NW corner of Section 18, Township 8 South, Range 4 West (W.M.)
 Well 2 (POLK 3227) Located 1025 feet South and 910 feet East from the NW corner of Section 18, Township 8 South, Range 4 West (W.M.)
 Well 3 (POLK 375) Located 540 feet North and 1090 feet East from the SW corner of Section 7, Township 8 South, Range 4 West (W.M.)
 Well 5 (POLK 54245) Located 835 feet North and 1160 feet East from the SW corner of Section 7, Township 8 South, Range 4 West (W.M.)

- LEGEND**
- Proposed Point of Appropriation (POA)
 - ⊙ Authorized Point of Appropriation (POA)
 - Place of Use (POU)**
 - ▨ No Change
 - ▨ Affected by Permit Amendment (addition of wells 1, 3, 5)
 - All Other Features**
 - ▭ Tax Lot
 - ▭ Donation Land Claim (DLC)
 - ~ Watercourse

DISCLAIMER
 This map was prepared for the purpose of identifying the location of a water right only and it is not intended to provide legal dimensions or location of property ownership lines.

MAP NOTES
 Date: September 4, 2019
 Data Sources: USGS, BLM, OWRD, ESRI

Revised
 Received by OWRD

SEP 06 2019
 Salem, OR

