


**Legend**

- Well #1: JACK 61873
  - ▨ Place of Use
  - ▭ TL 1200
- Well #1: JACK 61873  
1713 ft West and  
1882 ft North from SE Corner  
Section 13

N  
▲  
1 inch = 500 feet

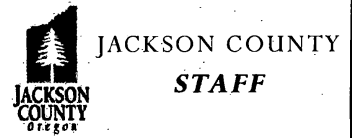

This map is based on a digital database compiled by Jackson County from a variety of sources. Jackson County cannot accept responsibility for errors, omissions, or positional accuracy. There are no warranties, expressed or implied.

Gi-18635