


PONDEROSA PINES WATER COMPANY
PERMIT AMENDMENT MAP
 LOCATED IN SECTIONS 1 & 12,
 T. 22 S., R. 9 E. AND SECTIONS
 6 & 7, T. 22 S., R. 10 E.

THE PREPARATION OF THIS MAP IS FOR THE PURPOSE OF IDENTIFYING THE LOCATION OF THE WATER RIGHT ONLY AND HAS NO INTENT TO PROVIDE DIMENSIONS OR LOCATIONS OF PROPERTY OWNERSHIP LINES.

BASIS OF BEARING - CENTRAL OREGON COORDINATE SYSTEM (NAD 83)

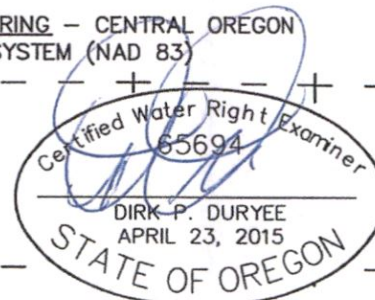

RENEWS: 12-31-19


WELL #2
 2106'S, 1211'E FROM
 NW C 06 NE 05 SEC. 7

WELL #1
 685'S, 35'E FROM
 NW CORNER
 OF SEC. 6

PROPOSED NEW WELL #3
 2108'S, 1161'E FROM
 NW CORNER OF SEC. 7

LEGEND

	PERMIT G-6799 BDRY (GROUP DOMESTIC)
	PERMIT G-8500 BDRY (GROUP DOMESTIC)
	PERMIT G-8502 BDRY (GROUP DOMESTIC)
	POA-WELL
	WATER MAIN
	SECTION LINE
	QTR-QTR LINE

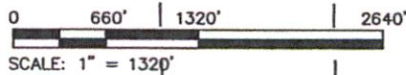

TYE ENGINEERING, INC.

725 NW HILL, BEND, OREGON 97703 (541) 389-6959

DATE: JULY 22, 2019

SCALE: 1"=1320'

DRAWN BY: B.V.W.

2076 PONDEROSA PINES

13234