


Bielenberg WR App

1" = 1320'

Tax Lot:




Township 5 South, Range 1 East, Section 25 & 36, Tax Lot 1600 & 300 + 100

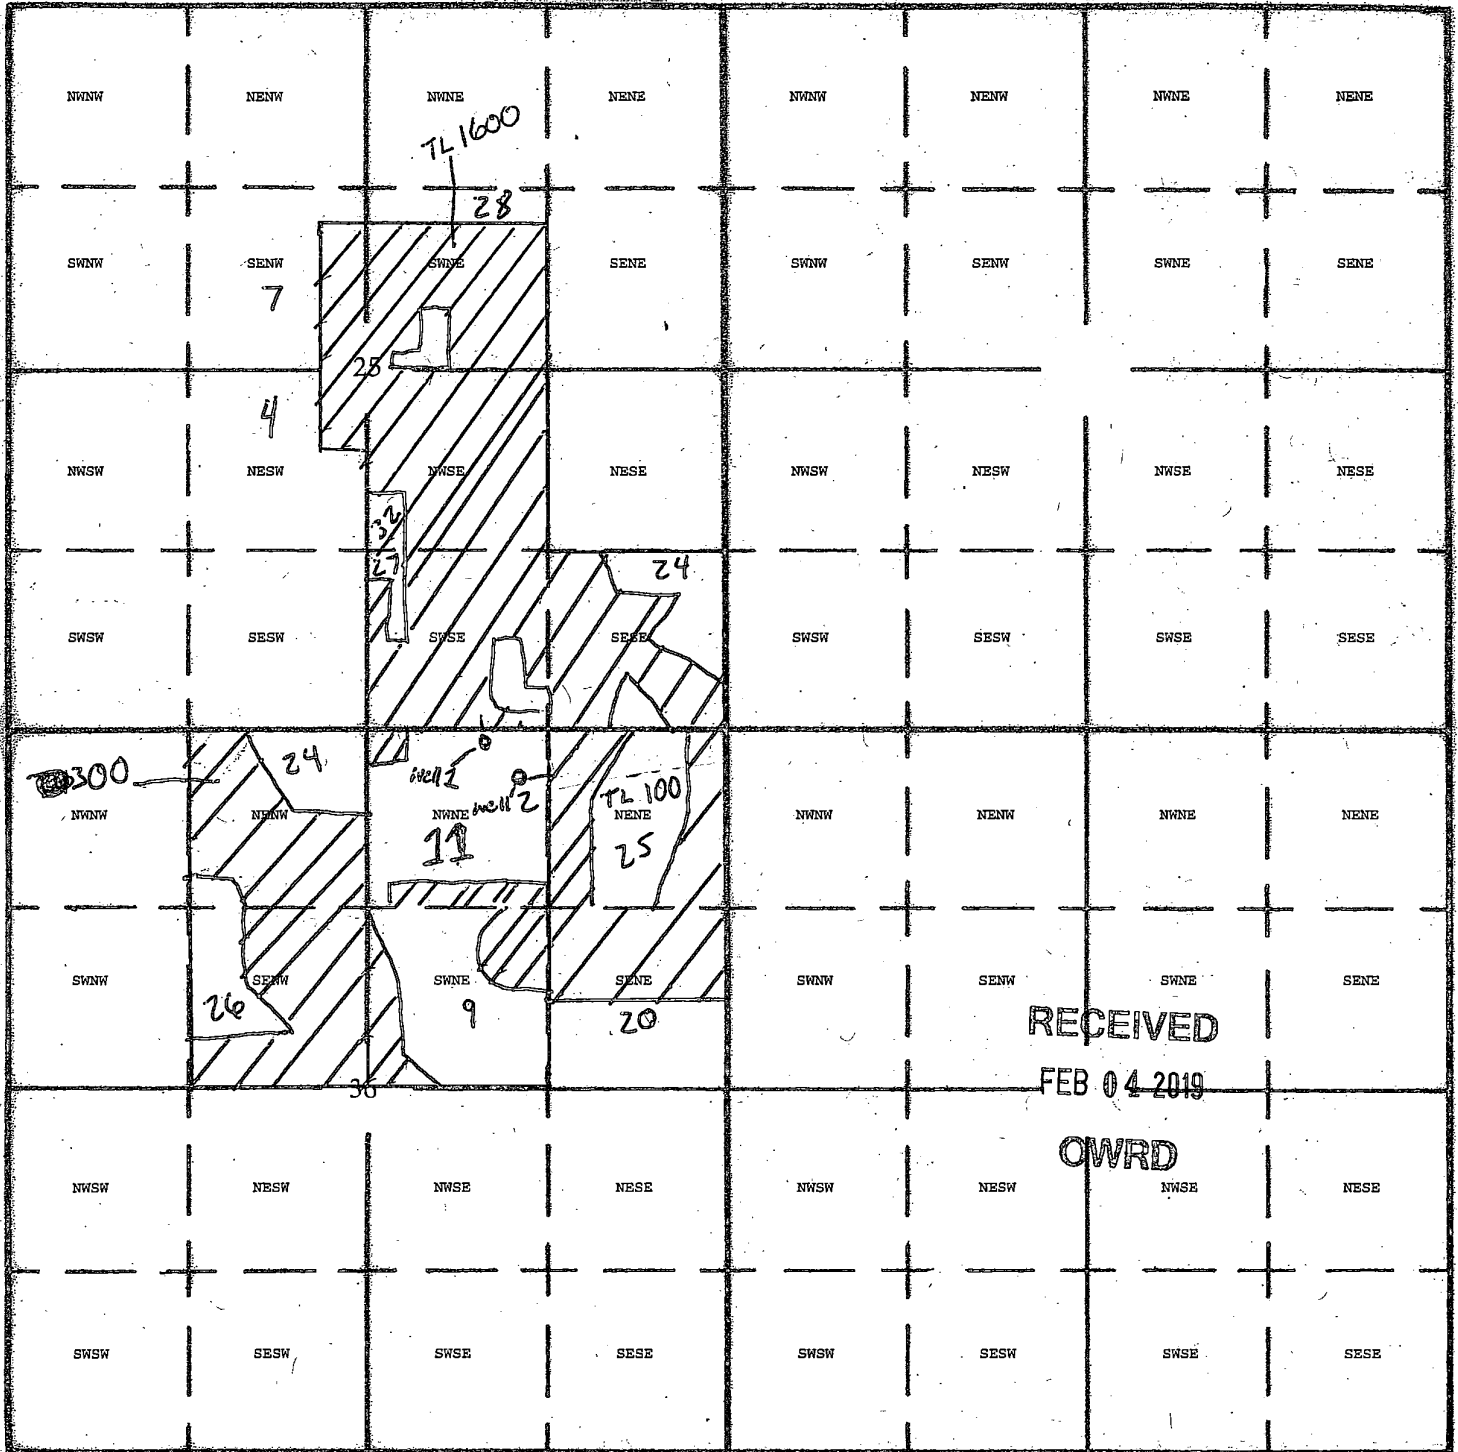

South

Well 1: 70' south + 1800' west NE corner sec 30
 Well 2: 340' south + 1500' west NE corner sec 30

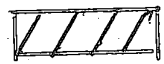 - 237 acres

David Bit 1/31/2019

G-18787