



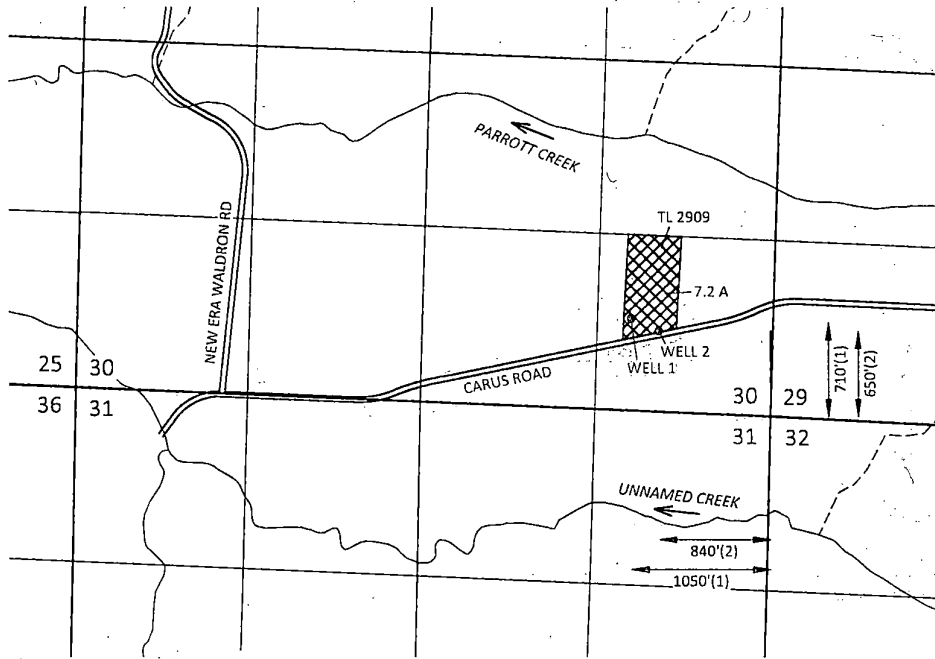

Section 30, T3S, R2E, W.M.,  
Clackamas County, Oregon


AMENDED GROUNDWATER APPLICATION MAP  
Application G-18749  
Richard Vasquez

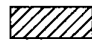

EXPLANATION

-  PROPOSED NURSERY PLACE OF USE  
7.2 ACRES
-  PROPOSED COMMERCIAL PLACE OF USE  
7.2 ACRES
-  PROPOSED WELL

NOTE: This map is amended due to  
change in Well 2 location

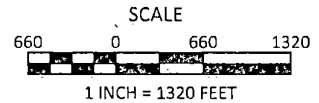

May 3, 2019

This map is not intended to provide legal  
dimensions or locations of property  
ownership lines

Figure 1

**SKOOKUM**  
WATER ASSOCIATES INC

1626 VICTORIAN WAY  
EUGENE, OR 97401  
(503) 319-8926

OWRD Rec'd May 6, 2019

G-18749