


T33S R6W Southwest Quarter Section 15

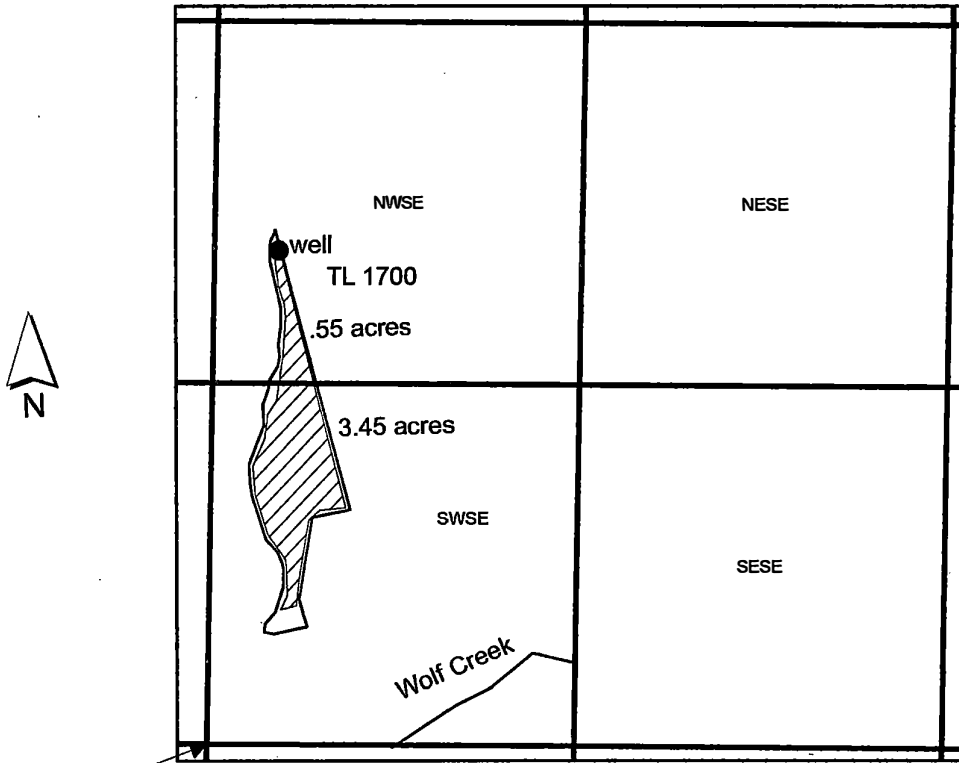

SW 1/4 Section Corner

1 inch = 660 feet

The well is located 228 ft east and 1804 ft north from the southwest 1/4 Section corner.

RECEIVED BY OWRD

OCT 06 2017

SALEM, OR

G-18566