

RECEIVED
 OCT 09 2015
 WATER RESOURCES DEPT
 SALEM, OREGON
 Project #1009.2
 Date Revised: 08/11/2015

ROGER N. SMITH ASSOCIATES, INC.
 Groundwater and Environmental Consultants

LEGEND	
	POU Boundary (City UGB)
	Original POU for Well 7, 9 & 11
	Storage Tanks • Groundwater Registered City Wells (POA)
	Permitted or Certified City Wells (POA)
	New POU for Municipality (City UGB)
	DLC Boundary

Scale: 1" = 2,640'

PERMIT AMENDMENT
MAP FOR WELLS
#7, 9 & 11 | 12181

**Permit Amendment
Permits G-17730 and G-17731
Points of Appropriation and
Authorized Place of Use**

**Marion County, Oregon
Township 5 South,
Range 1, 2 West (W.M.)**

LEGEND

- ⊙ Authorized Point of Appropriation (POA)
- Proposed Point of Appropriation (POA)
- Water Main
- Place of Use (POU) Within the City of Woodburn's Urban Growth Boundaries
- All Other Features
 - Tax Lot
 - Donation Land Claim (DLC)
 - Railroad
 - Major Road
 - Watercourse
 - Waterbody


RECEIVED
SEP 19 2019
OWRD

POA LOCATION DESCRIPTION

- Well 7 Located 2000 feet South and 540 feet East from the NW corner of Section 12, Township 5 South, Range 2 West (W.M.)
- Well 8 Located 2250 feet North and 1590 feet East from the SW corner of Section 8, Township 5 South, Range 1 West (W.M.)
- Well 9 Located 1200 feet South and 1980 feet East from the NW corner of Section 7, Township 5 South, Range 1 West (W.M.)
- Well 10 Located 1200 feet North and 1720 feet West from the E 1/4 corner of Section 8, Township 5 South, Range 1 West (W.M.)
- Well 11 Located 1840 feet South and 920 feet East from the NW corner of Section 7, Township 5 South, Range 1 West (W.M.)
- Well 12 Located 2466 feet North and 1835 feet West from the SE corner of Section 13, Township 5 South, Range 2 West (W.M.)
- Well 13 Located 1415 feet South and 1155 feet East from the NW corner of Section 18, Township 5 South, Range 1 West (W.M.)
- Well 14 Located 1117 feet North and 35 feet West from the SE corner of Section 5, Township 5 South, Range 1 West (W.M.)
- New Well Site Option A Located 942 feet North and 1892 feet West from the SE corner of Section 13, Township 5 South, Range 2 West (W.M.)
- New Well Site Option B Located 900 feet South and 260 feet West from the NE corner of Section 14, Township 5 South, Range 2 West (W.M.)
- New Well Site Option C Located 2715 feet South and 850 feet East from the NW corner of Section 13, Township 5 South, Range 2 West (W.M.)

DISCLAIMER

This map was prepared for the purpose of identifying the location of a water right only and it is not intended to provide legal dimensions or location of property ownership lines.

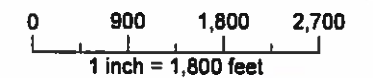

Date: September 16, 2019
Data Sources: BLM, Marion Co., USGS, ESRI

