


T6S, R4W, Section 22

1" = 400'

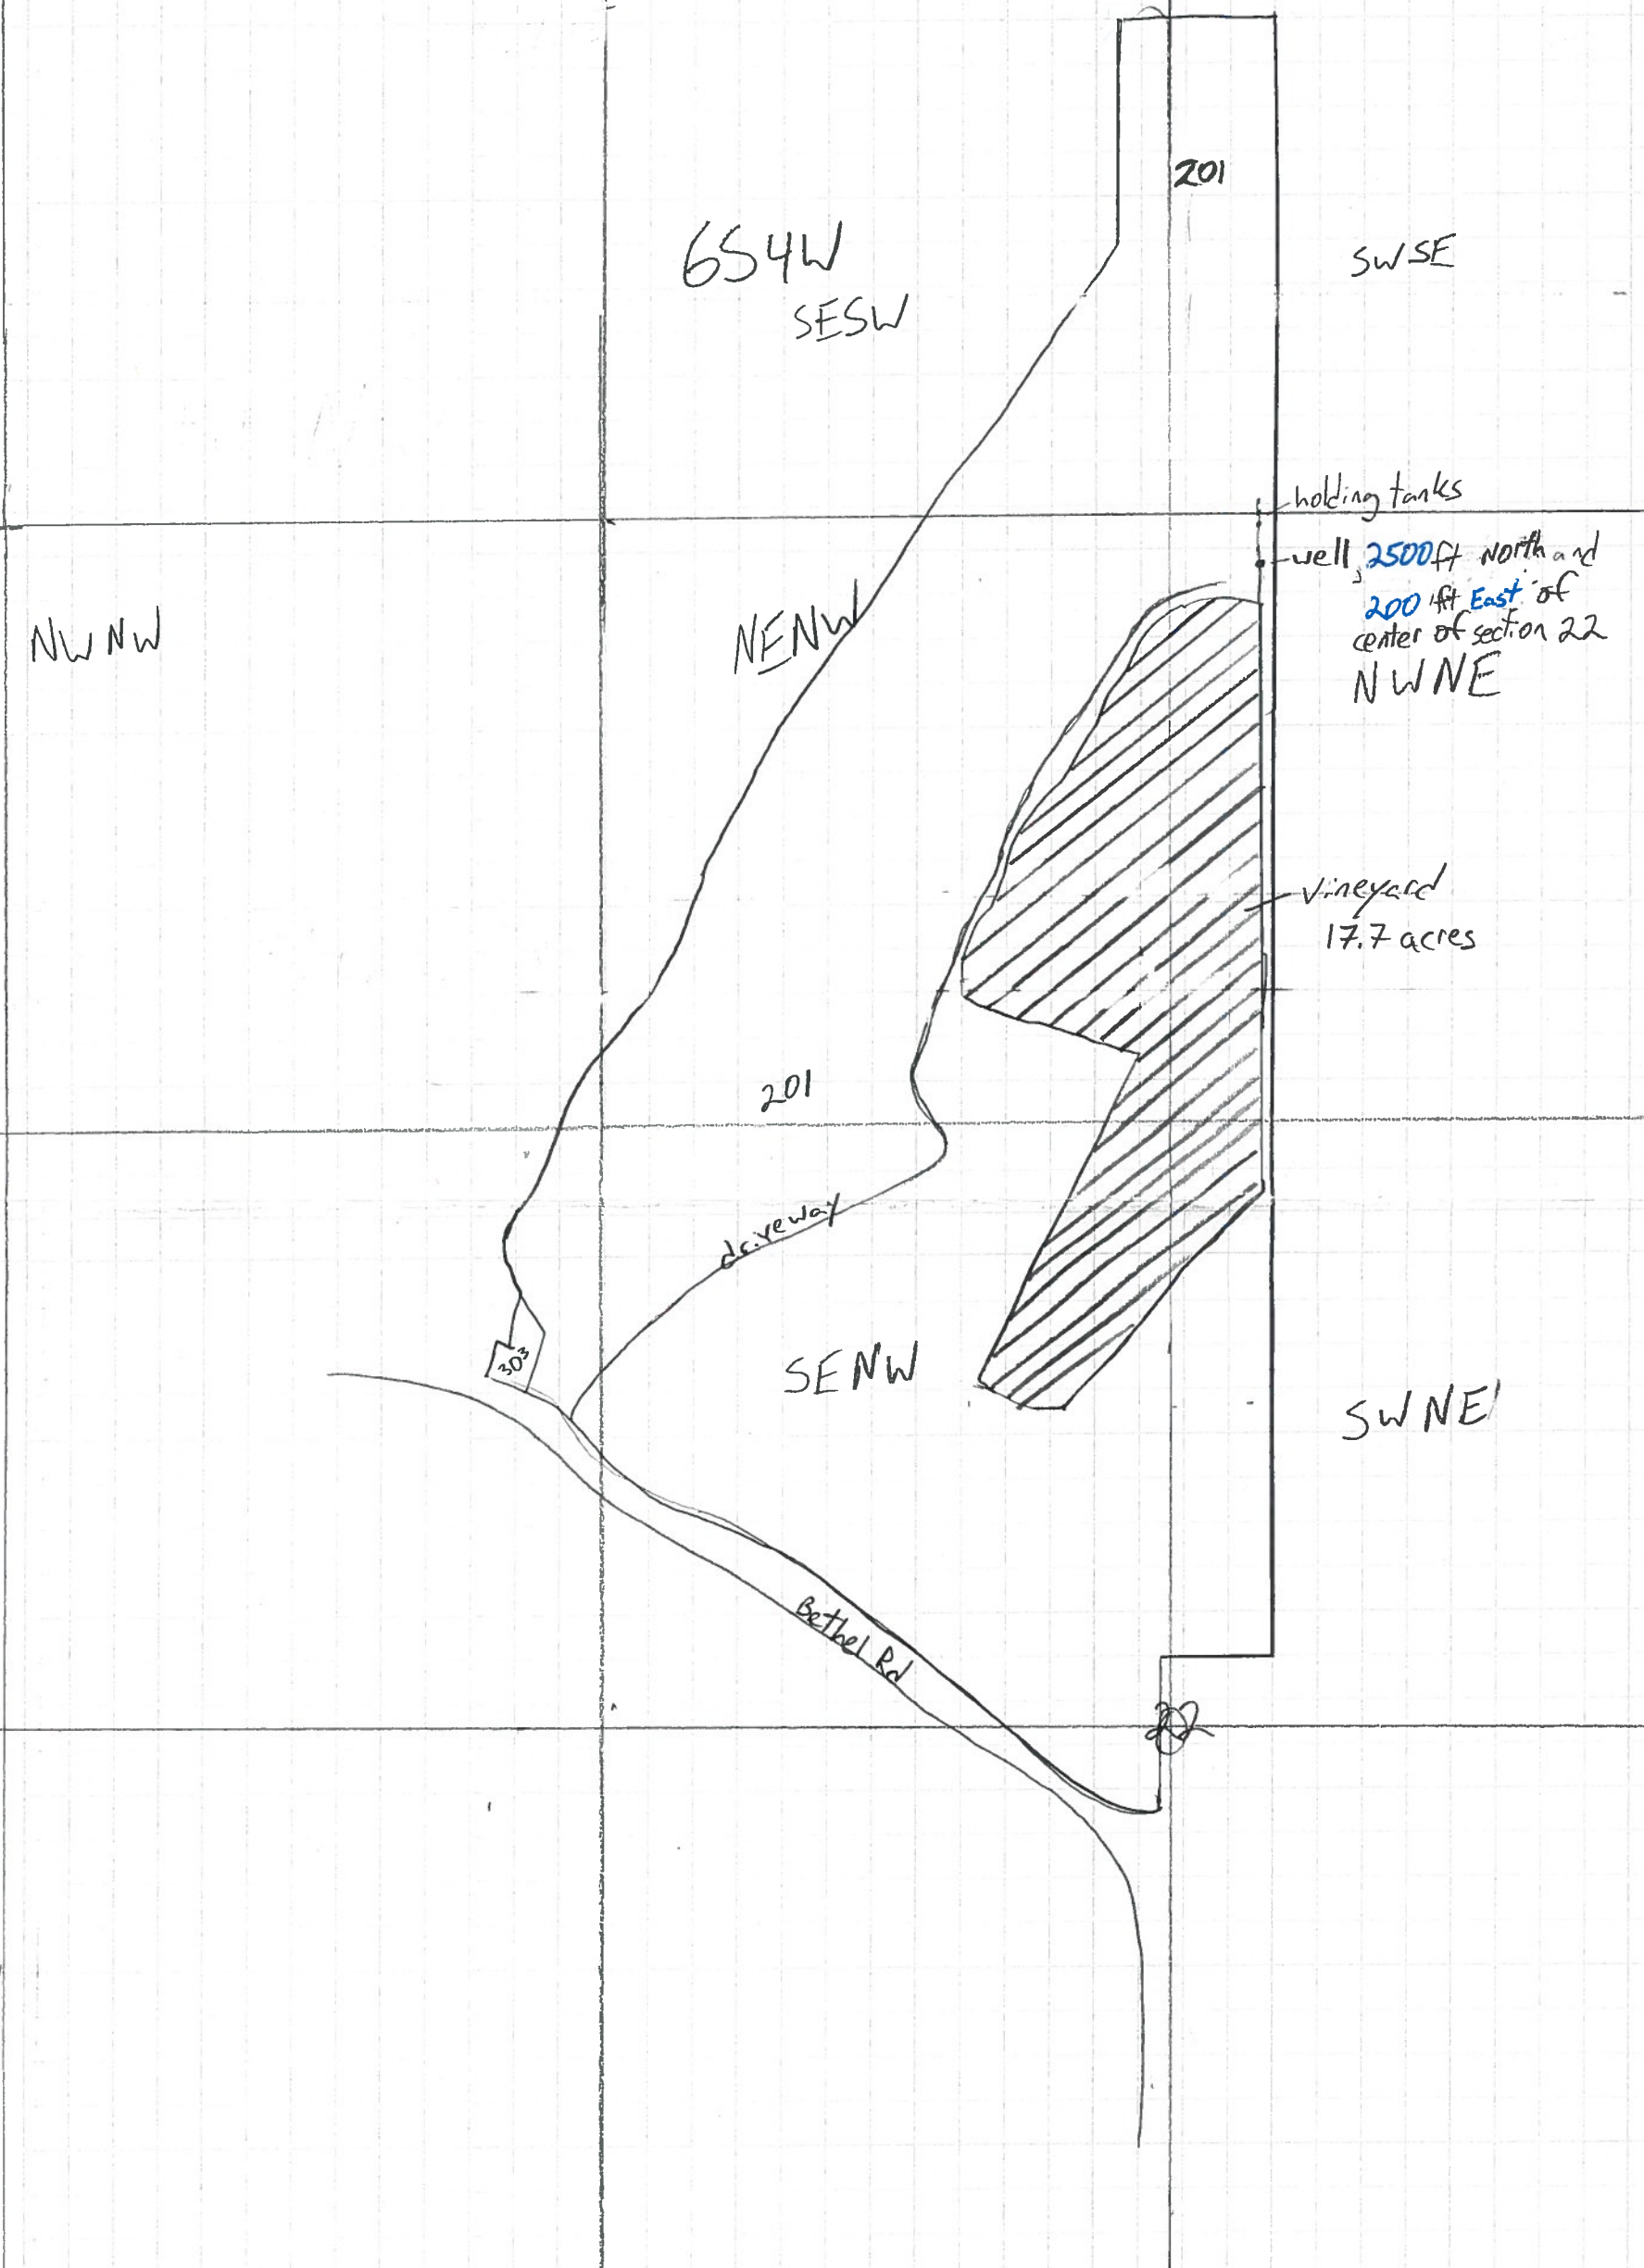

RECEIVED
MAY 15 2019
OWRD



	acres	q/q	section	township	range	W.M.
	6.2	NWNE	22	6S	4W	W.M.
	6.3	NENW	22	6S	4W	W.M.
	3.5	SENE	22	6S	4W	W.M.
	1.7	SWNE	22	6S	4W	W.M.
Total Acres	17.7					

Pearlstad Vineyard
6675 Bethel Rd
Rickreall, OR

G-18808