



# T.3S. R.1W. Sec. 32 & 33, W.M.

RECEIVED  
SEP 05 2019




OWRD

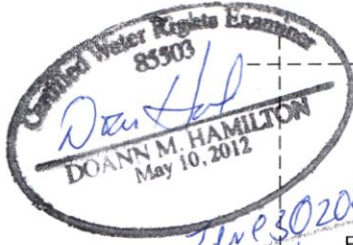

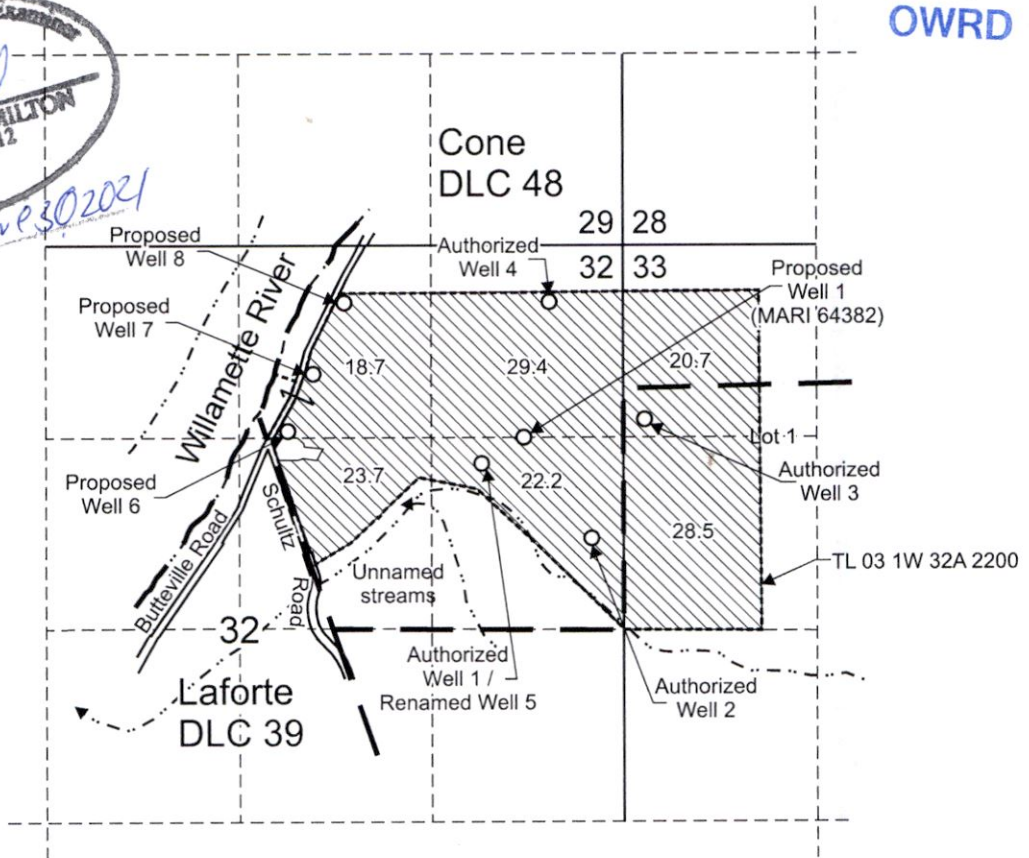*June 30 2021*



Authorized Well 1 (Renamed Well 5) is located 1,500 feet south and 970 feet west from the NE corner, Section 32.  
 Authorized Well 2 is located 2,020 feet south and 220 feet west from the NE corner, Section 32.  
 Authorized Well 3 is located 1,200 feet south and 150 feet east from the NW corner, Section 33.  
 Authorized Well 4 is located 390 feet south and 510 feet west from the NE corner, Section 32.  
 Proposed Well 1 is located 1,320 feet south and 683 feet west from the NE corner, Section 32  
 Proposed Well 6 is located 1,275 feet south and 2,305 feet west from the NE corner, Section 32  
 Proposed Well 7 is located 880 feet south and 2,130 feet west from the NE corner, Section 32  
 Proposed Well 8 is located 395 feet south and 1,915 feet west from the NE corner, Section 32

-  Area (133.2 Acres) to be irrigated.
-  Tax lot boundary
-  Donation Land Claim boundary

13245

Scale: 1" = 1,320'



This map was prepared for the purpose of identifying the location of a water right only and is not intended to provide legal dimensions or location of property ownership lines.



Permit Amendment Application Map  
Application G-16890, Permit G-16411

Pacific Hydro-Geology Inc.

Pacific Foods of Oregon, Inc.  
T.3S. R.1W. Sec. 32 & 33, W.M.


08/2019

# T.3S. R.1W. Sec. 32 & 33, W.M.


RECEIVED


JUN 29 2007


WATER RESOURCES DEPT  
SALEM, OREGON

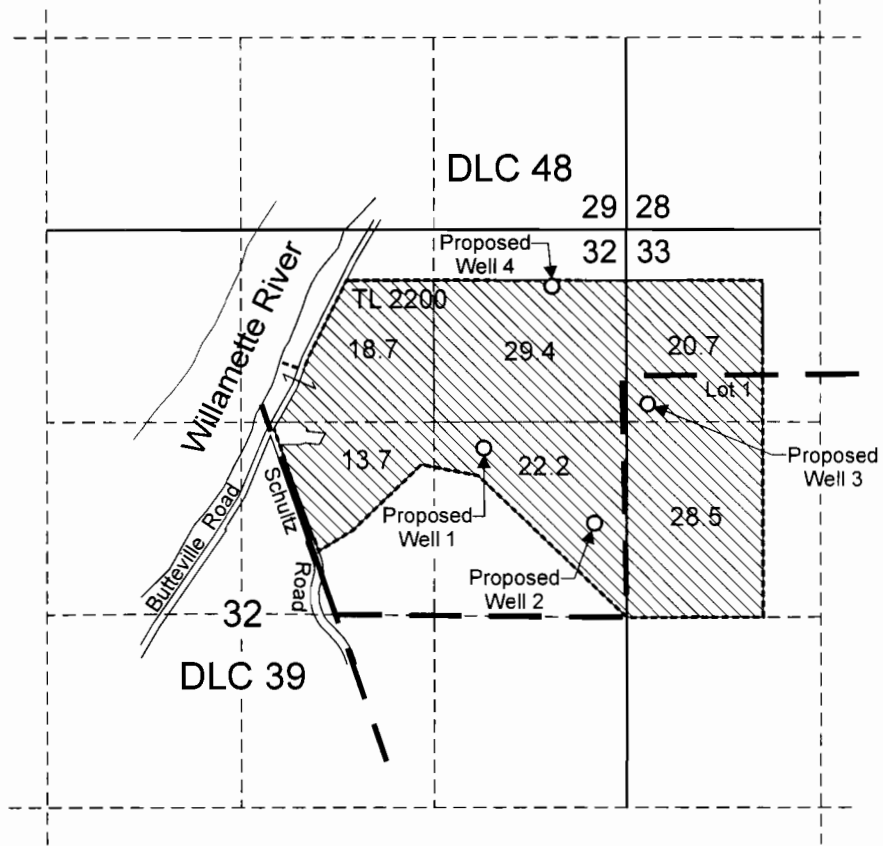

Proposed Well 1 is located 1,500 feet south and 970 feet west from the NE corner of Section 32.  
 Proposed Well 2 is located 2,020 feet south and 220 feet west from the NE corner of Section 32.  
 Proposed Well 3 is located 1,200 feet south and 150 feet east from the NW corner of Section 33.  
 Proposed Well 4 is located 390 feet south and 510 feet west from the NE corner of Section 32.

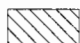 Area (133.2 Acres) to be irrigated.

 Tax lot boundary

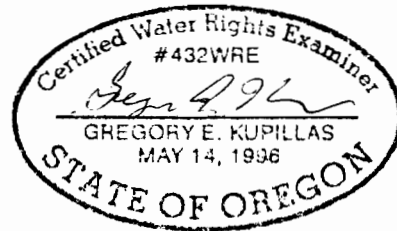

EXPIRATION DATE: 6/30/09

Scale: 1" = 1,320'



This map was prepared for the purpose of identifying the location of a water right only and is not intended to provide legal dimensions or location of property ownership lines.



## Water Right Application Map

Pacific Foods of Oregon, Inc.  
Tax Lot 3 1W 32A 2200

Pacific Hydro-Geology Inc.

6/2007

PacFoodsSistersGWAppMap1.cdr

App No G-16890