


MAP # 1 of 2

T-405, R12E, WM,
KLAMATH COUNTY

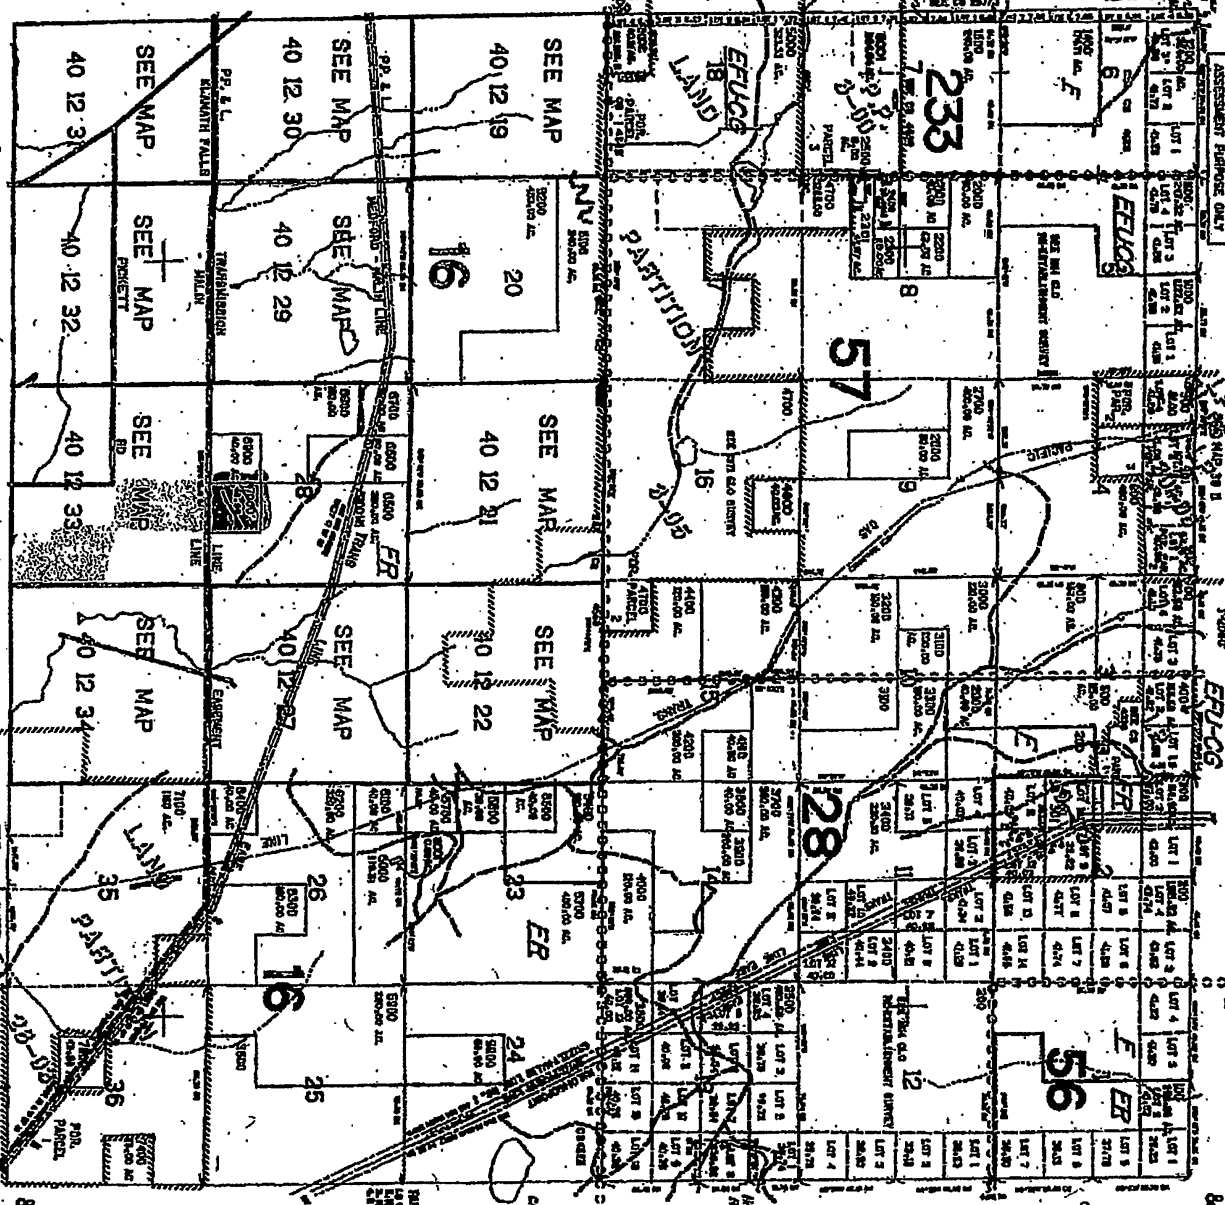

Scale
1" = 2000'

T-405
R12E
SEC 25
TL 7000
40 Ave

NORTH

40.12
& INDEX

RECEIVED

APR 02 2020

OWRD

40.12
& INDEX

THIS MAP WAS PREPARED FOR
ASSESSMENT PURPOSES ONLY

FIGURE

993921

40.12
& INDEX

MAP # 20 f 8

REVISED 5-20-12
THIS MAP WAS PREPARED FOR
ASSESSMENT PURPOSES ONLY

SECTION 33 T40S R12E WM.
KLAMATH COUNTY

40 12 33

NORTH


T40S R12E

SEC 33

TL 300

1100
1400

Scale
1" = 400'

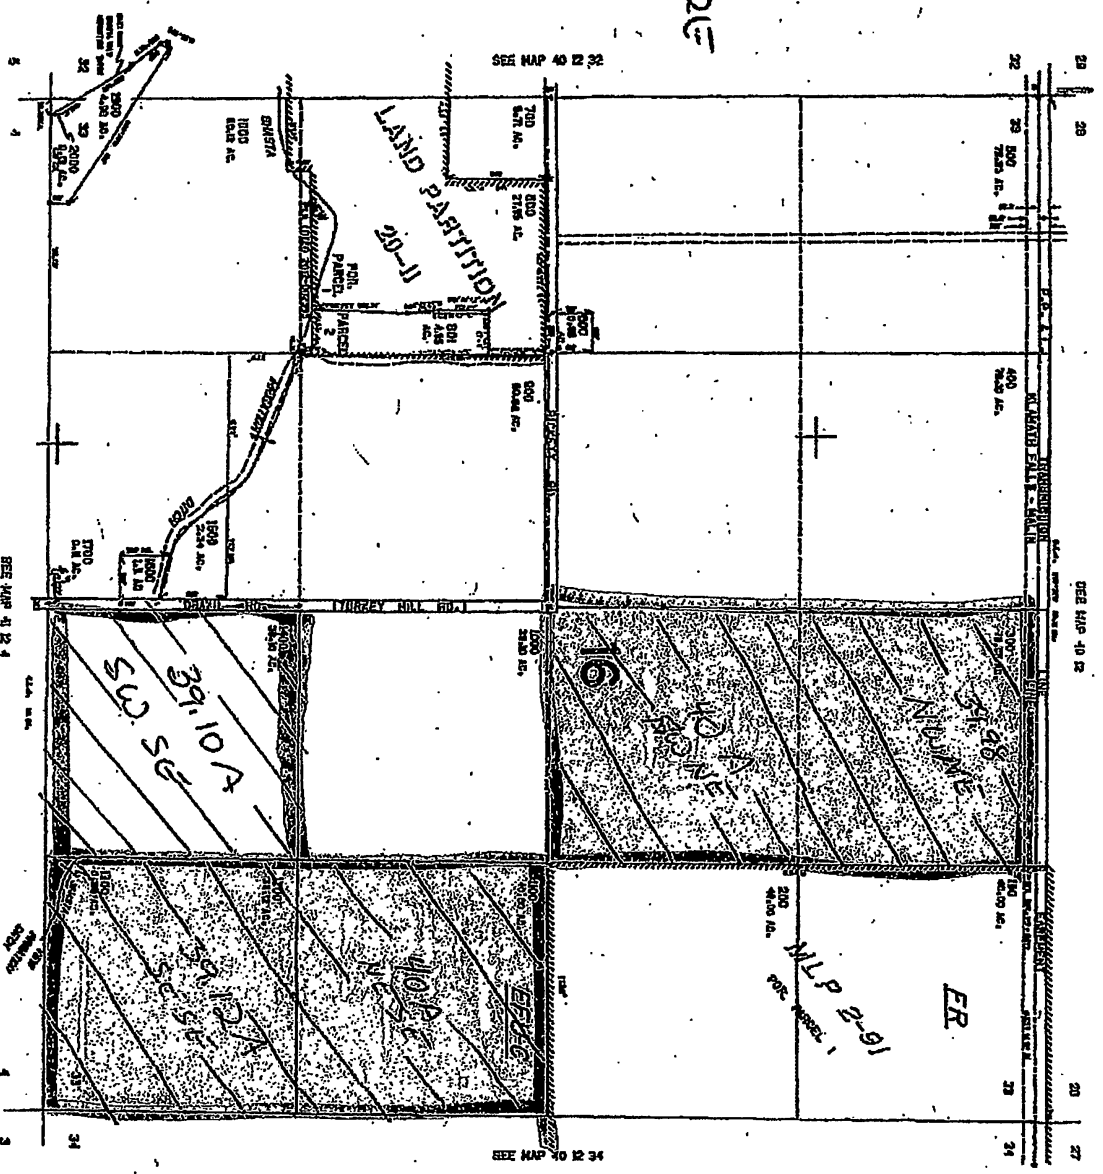

1750,000

SEE MAP # 12 4

40 12 33

RECEIVED
APR 02 2020
OWRD

MAP # 3028

REVISED 05-17-2016
THIS MAP WAS PREPARED FOR
ASSESSMENT PURPOSE ONLY

SECTION 01 T.41S. R11E. W.M.
KLAMATH COUNTY
1-400'

RECEIVED

APR 02 2020

OWRD


41 11 01

NORTH

T41S R11E
Sec 1

TL 6000

Scale
1" = 400'

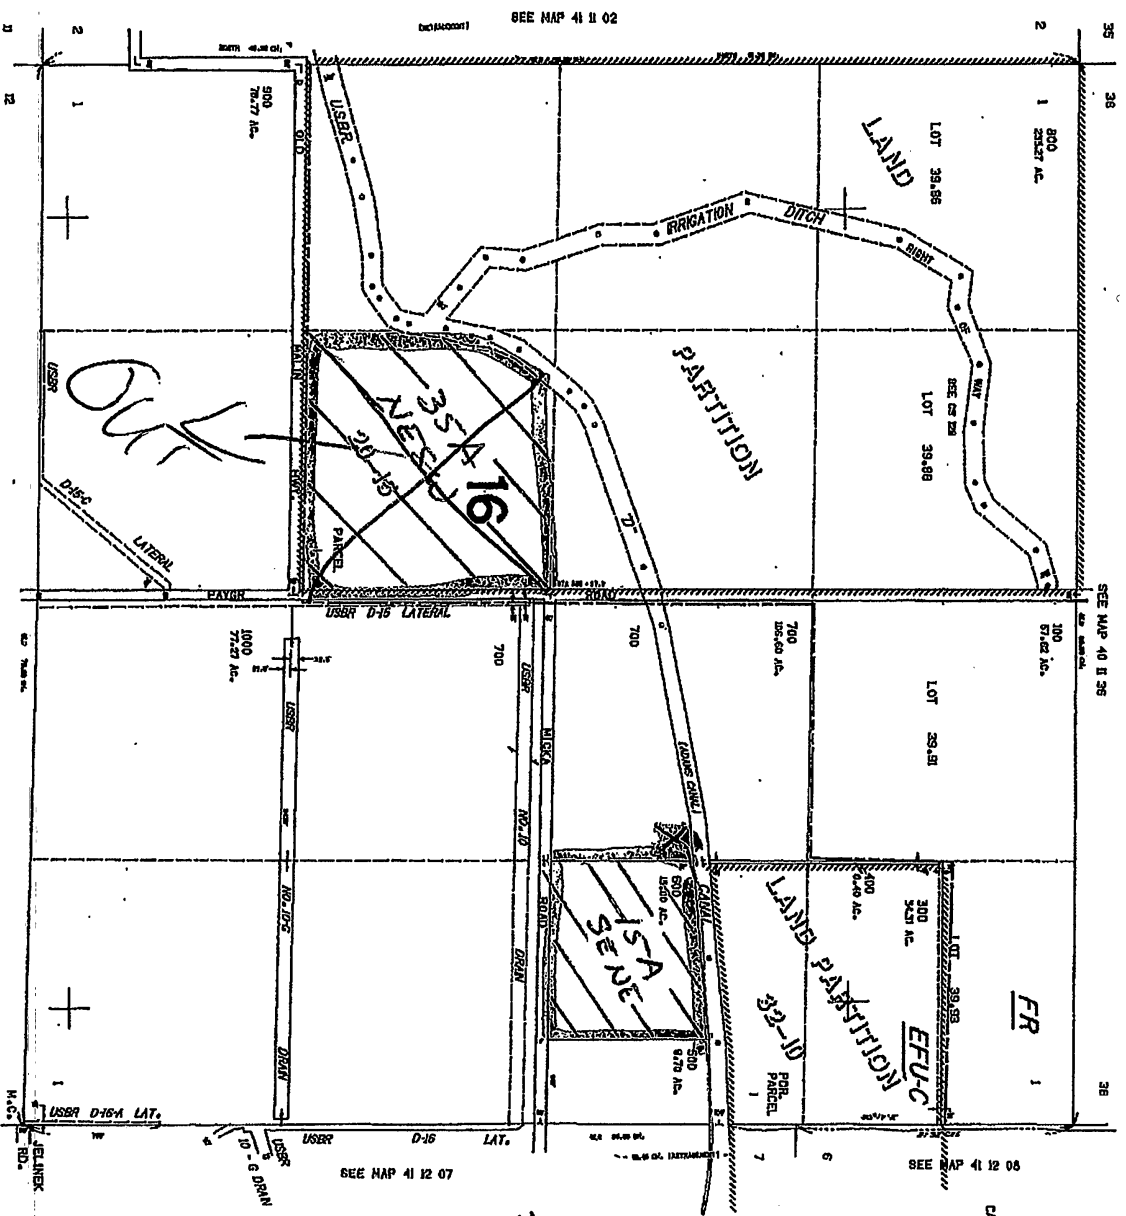

Well #2
600' N
of 1st 0' E
FROM c/4
CORNER Sec #1

734.000

SEE MAP 41 11 12

41 11 01

132.000

MAP # 4 of 8

TALS RILE

SEC 03

Tl 700

800

NORTH

1" = 400'
SCALE

G... ..



SECTION 03 TALS, RILE, WA.
KLAMATH COUNTY

OWRD

APR 02 2020

RECEIVED

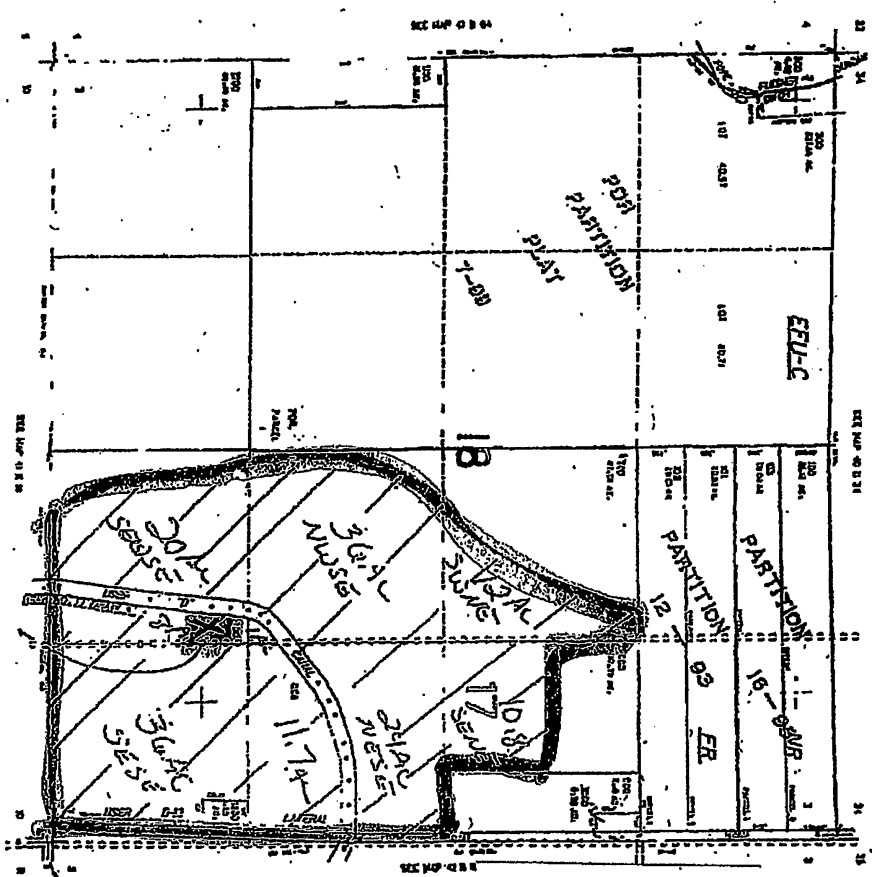

Well #1

1100' North
1380' West
SE corner
Sec 3

41 11 03

41 11 03

MAP # 508

THIS MAP WAS PREPARED FOR
ASSESSMENT PURPOSE ONLY

SECTION 05 T.41S. R12E. W.M.
KLAMATH COUNTY
1'-00"

RECEIVED

APR 02 2020

41 12 05


OWRD

NORTH

T41S R12E
Sec 5

TL 1000

Scale
1" = 400'

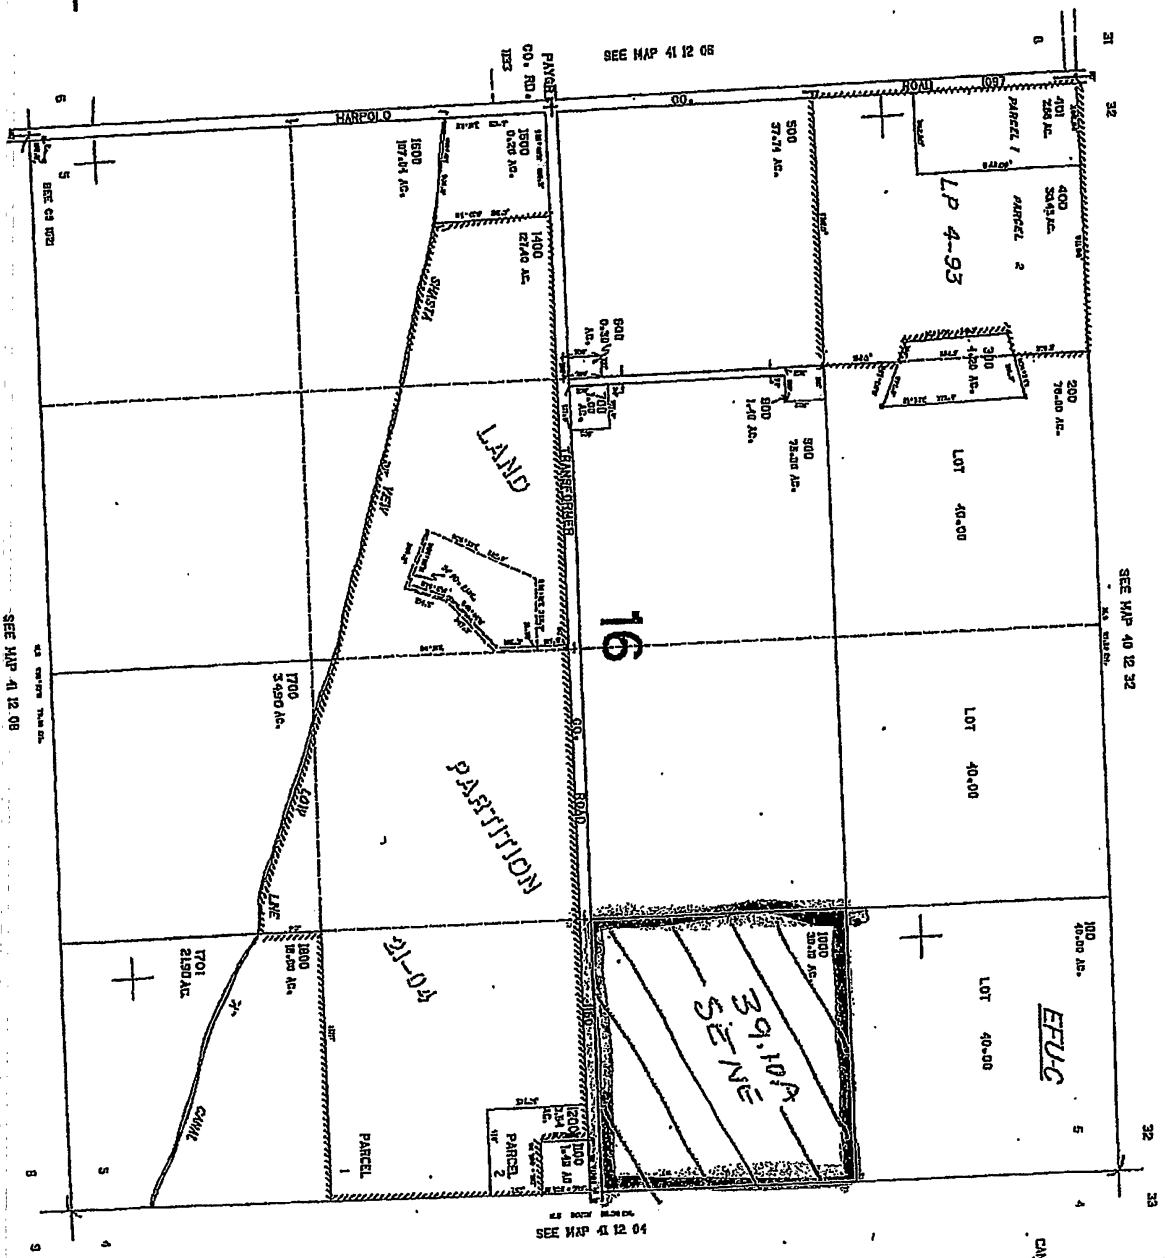

13,000

41 12 05

280,000

MAP #6 of 8

THIS MAP WAS PREPARED FOR ASSESSMENT PURPOSE ONLY.

SECTION 04 T41S, R12E, W.M.
KLAMATH COUNTY
T-400'

RECEIVED

APR 02 2020


OWPRD

41 12 04

NORTH

T41S R12E
SEC 4
TL 800

Scale
1" = 400'

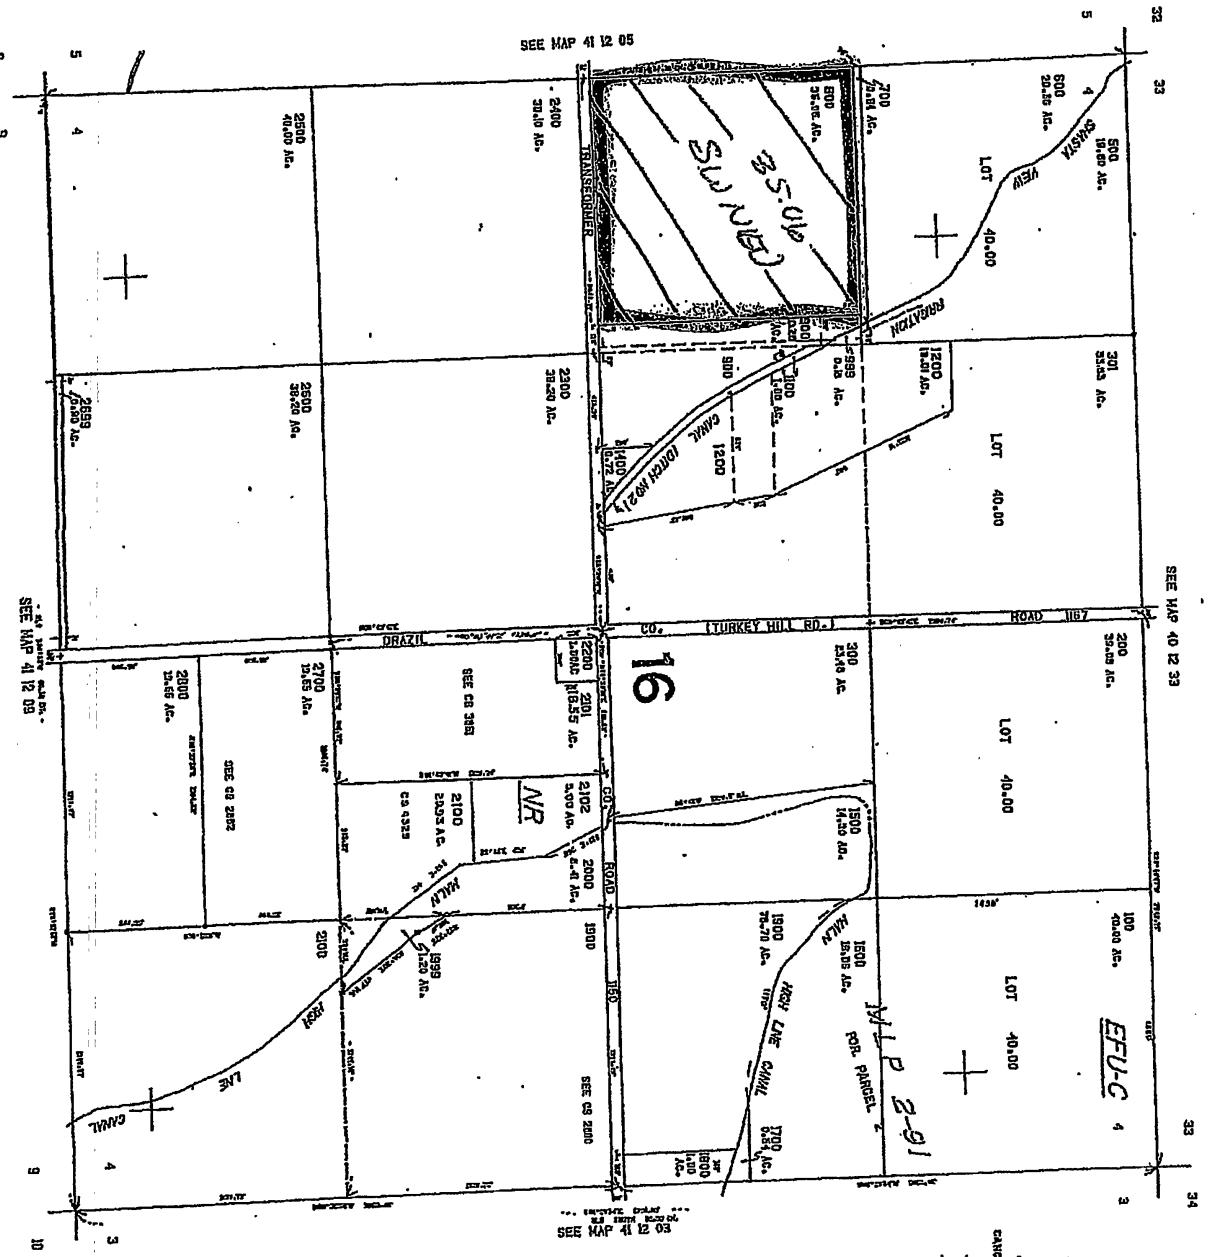

1749.000

128.000

41 12 04


MAP # 2 of 8

REVISED 4-7-11
THIS MAP WAS PREPARED FOR
ASSESSMENT PURPOSE ONLY

SECTION 06 T.41S. R.12E. W.M.
KLAMATH COUNTY
1"-400'

RECEIVED
APR 02 2020
OWNRD

41 12 06

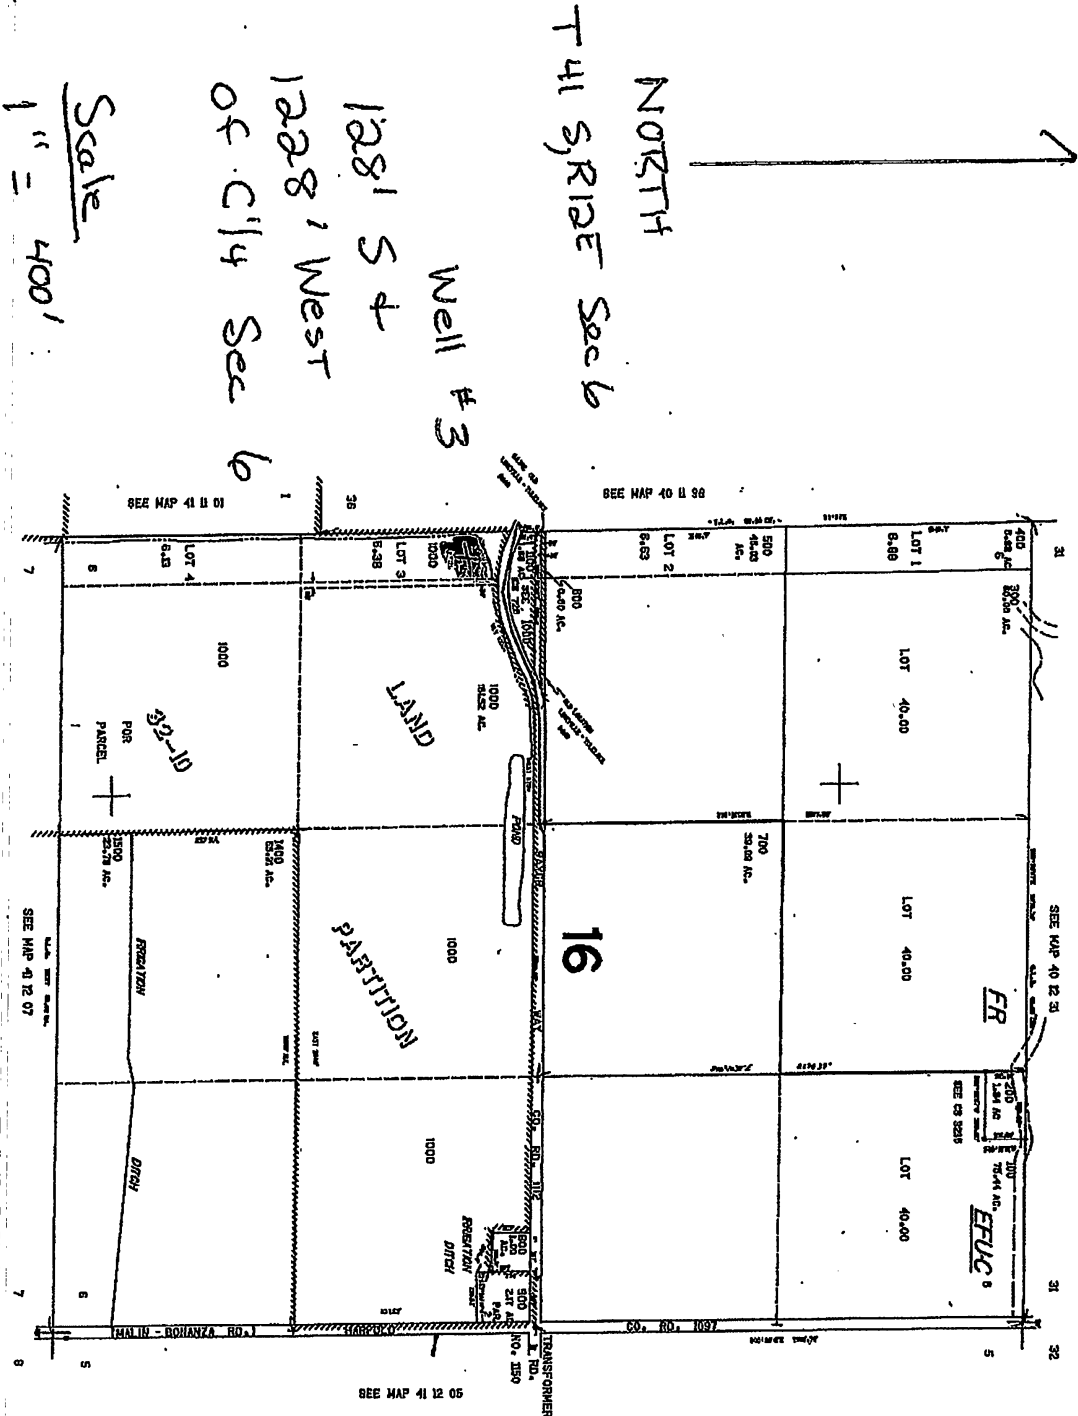

Scale
1" = 400'

1281 S +
1228' West
of C114 Sec 6

10,000'

41 12 06

MAP 8 of 8

REVISED 07-19-13
THIS MAP WAS PREPARED FOR
ASSESSMENT PURPOSE ONLY

SECTION 08 T.41S. R.12E. W.M.
KLAMATH COUNTY
1"-400'

RECEIVED
APR 02 2020
OWRD

41 12 08


NORTH

T41S R12E

SE 8

TL 1300

Scale
1" = 400'

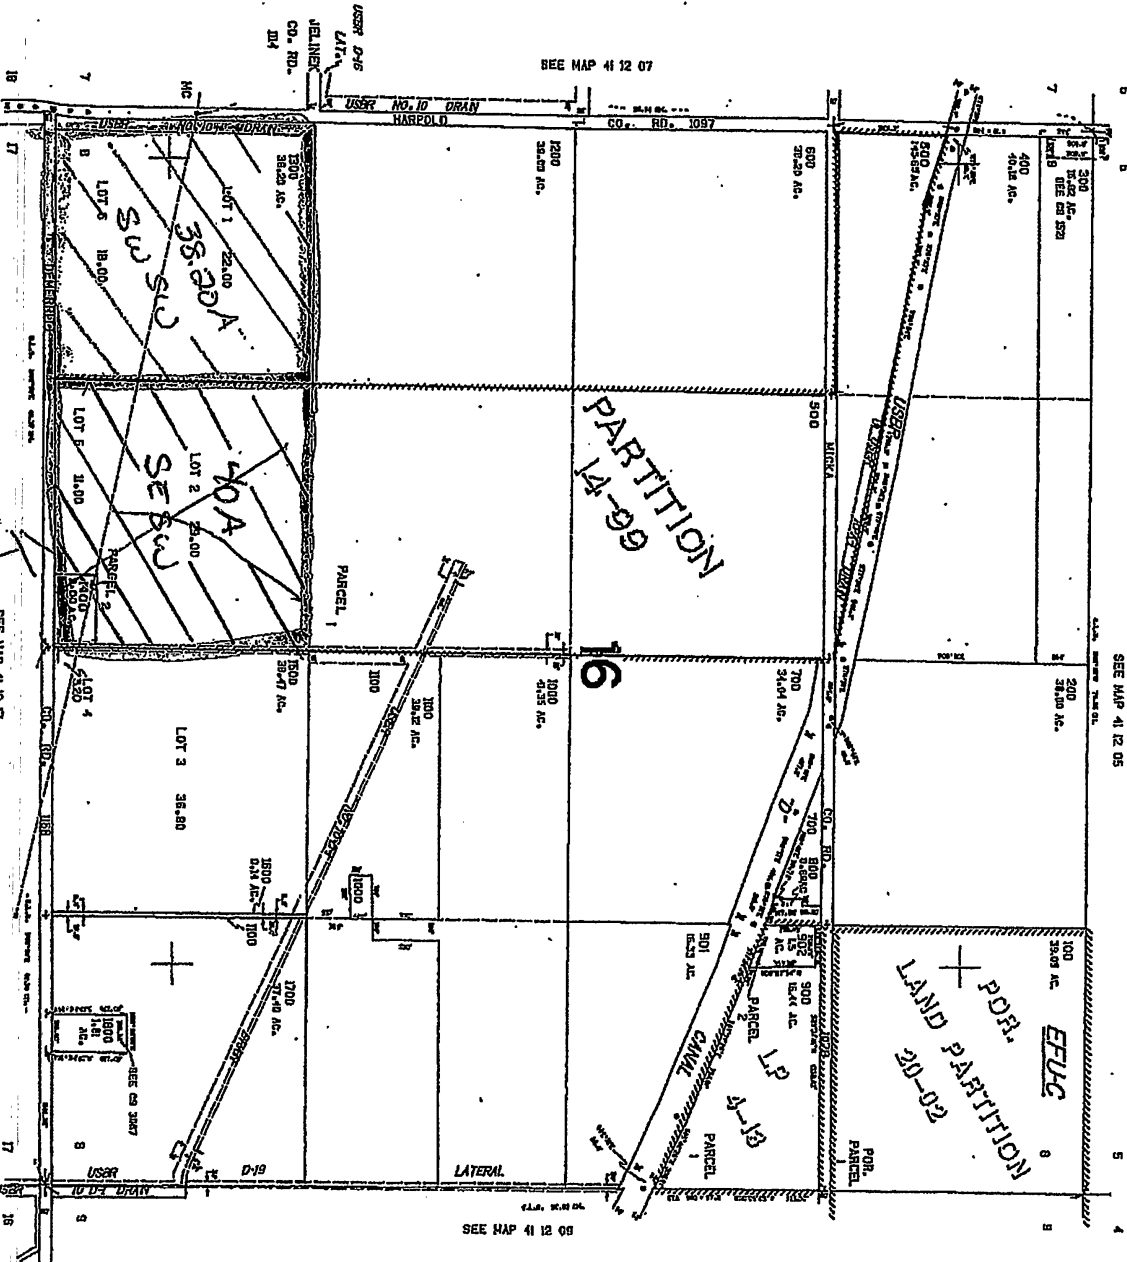

1749.000

41 12 08