

MAR 14 2019

↑ North

SECTION

1" = 1320'


TAX lots

200, 100

800

TOWNSHIP T7S, RANGE R1W, OWRD W. M.

North

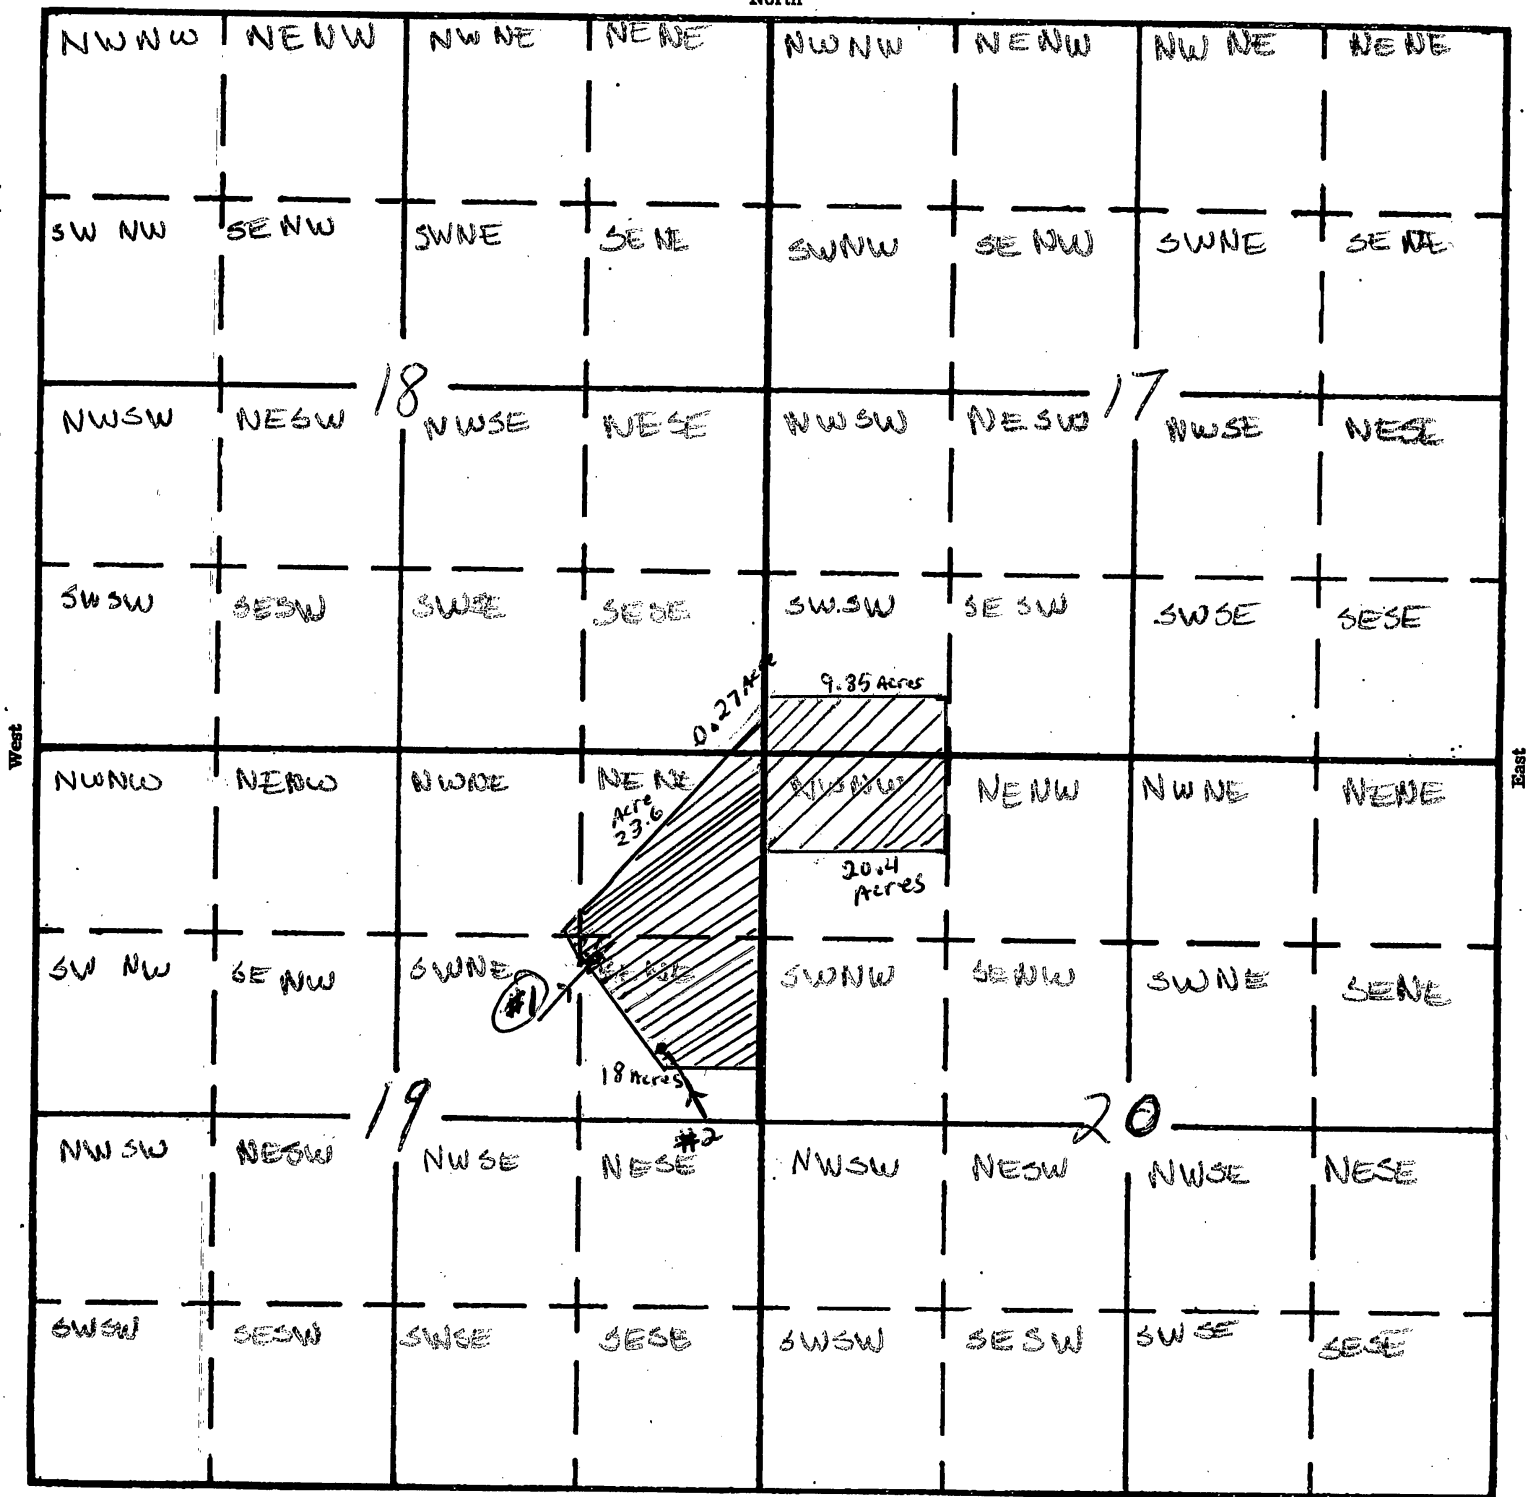

Well #1 150' south <sup>From the</sup> center of the NE corner of S 19

Well #2 581' South + 420ft east from the center of the NE corner of S 19