


**NOTES**

1. Place of Use and Points of Diversion and Appropriation locations are based on Certificates, Permits and Applications and were not field verified by Cascade GeoEngineering personnel.
2. The acreages indicated are not exact and were not surveyed.
3. Different hatch patterns are associated with specific water rights as indicated by number.
4. This map was prepared for the purpose of identifying the location of water rights only and is not intended to provide legal dimensions or locations of property ownership lines.

Permit Amendment Application  
 Tax Lot 600  
 Sections 5, 7, 8, 17, 18, 20, 21 & 29  
 T.16S., R.23E., W.M.  
 Crook County, Oregon

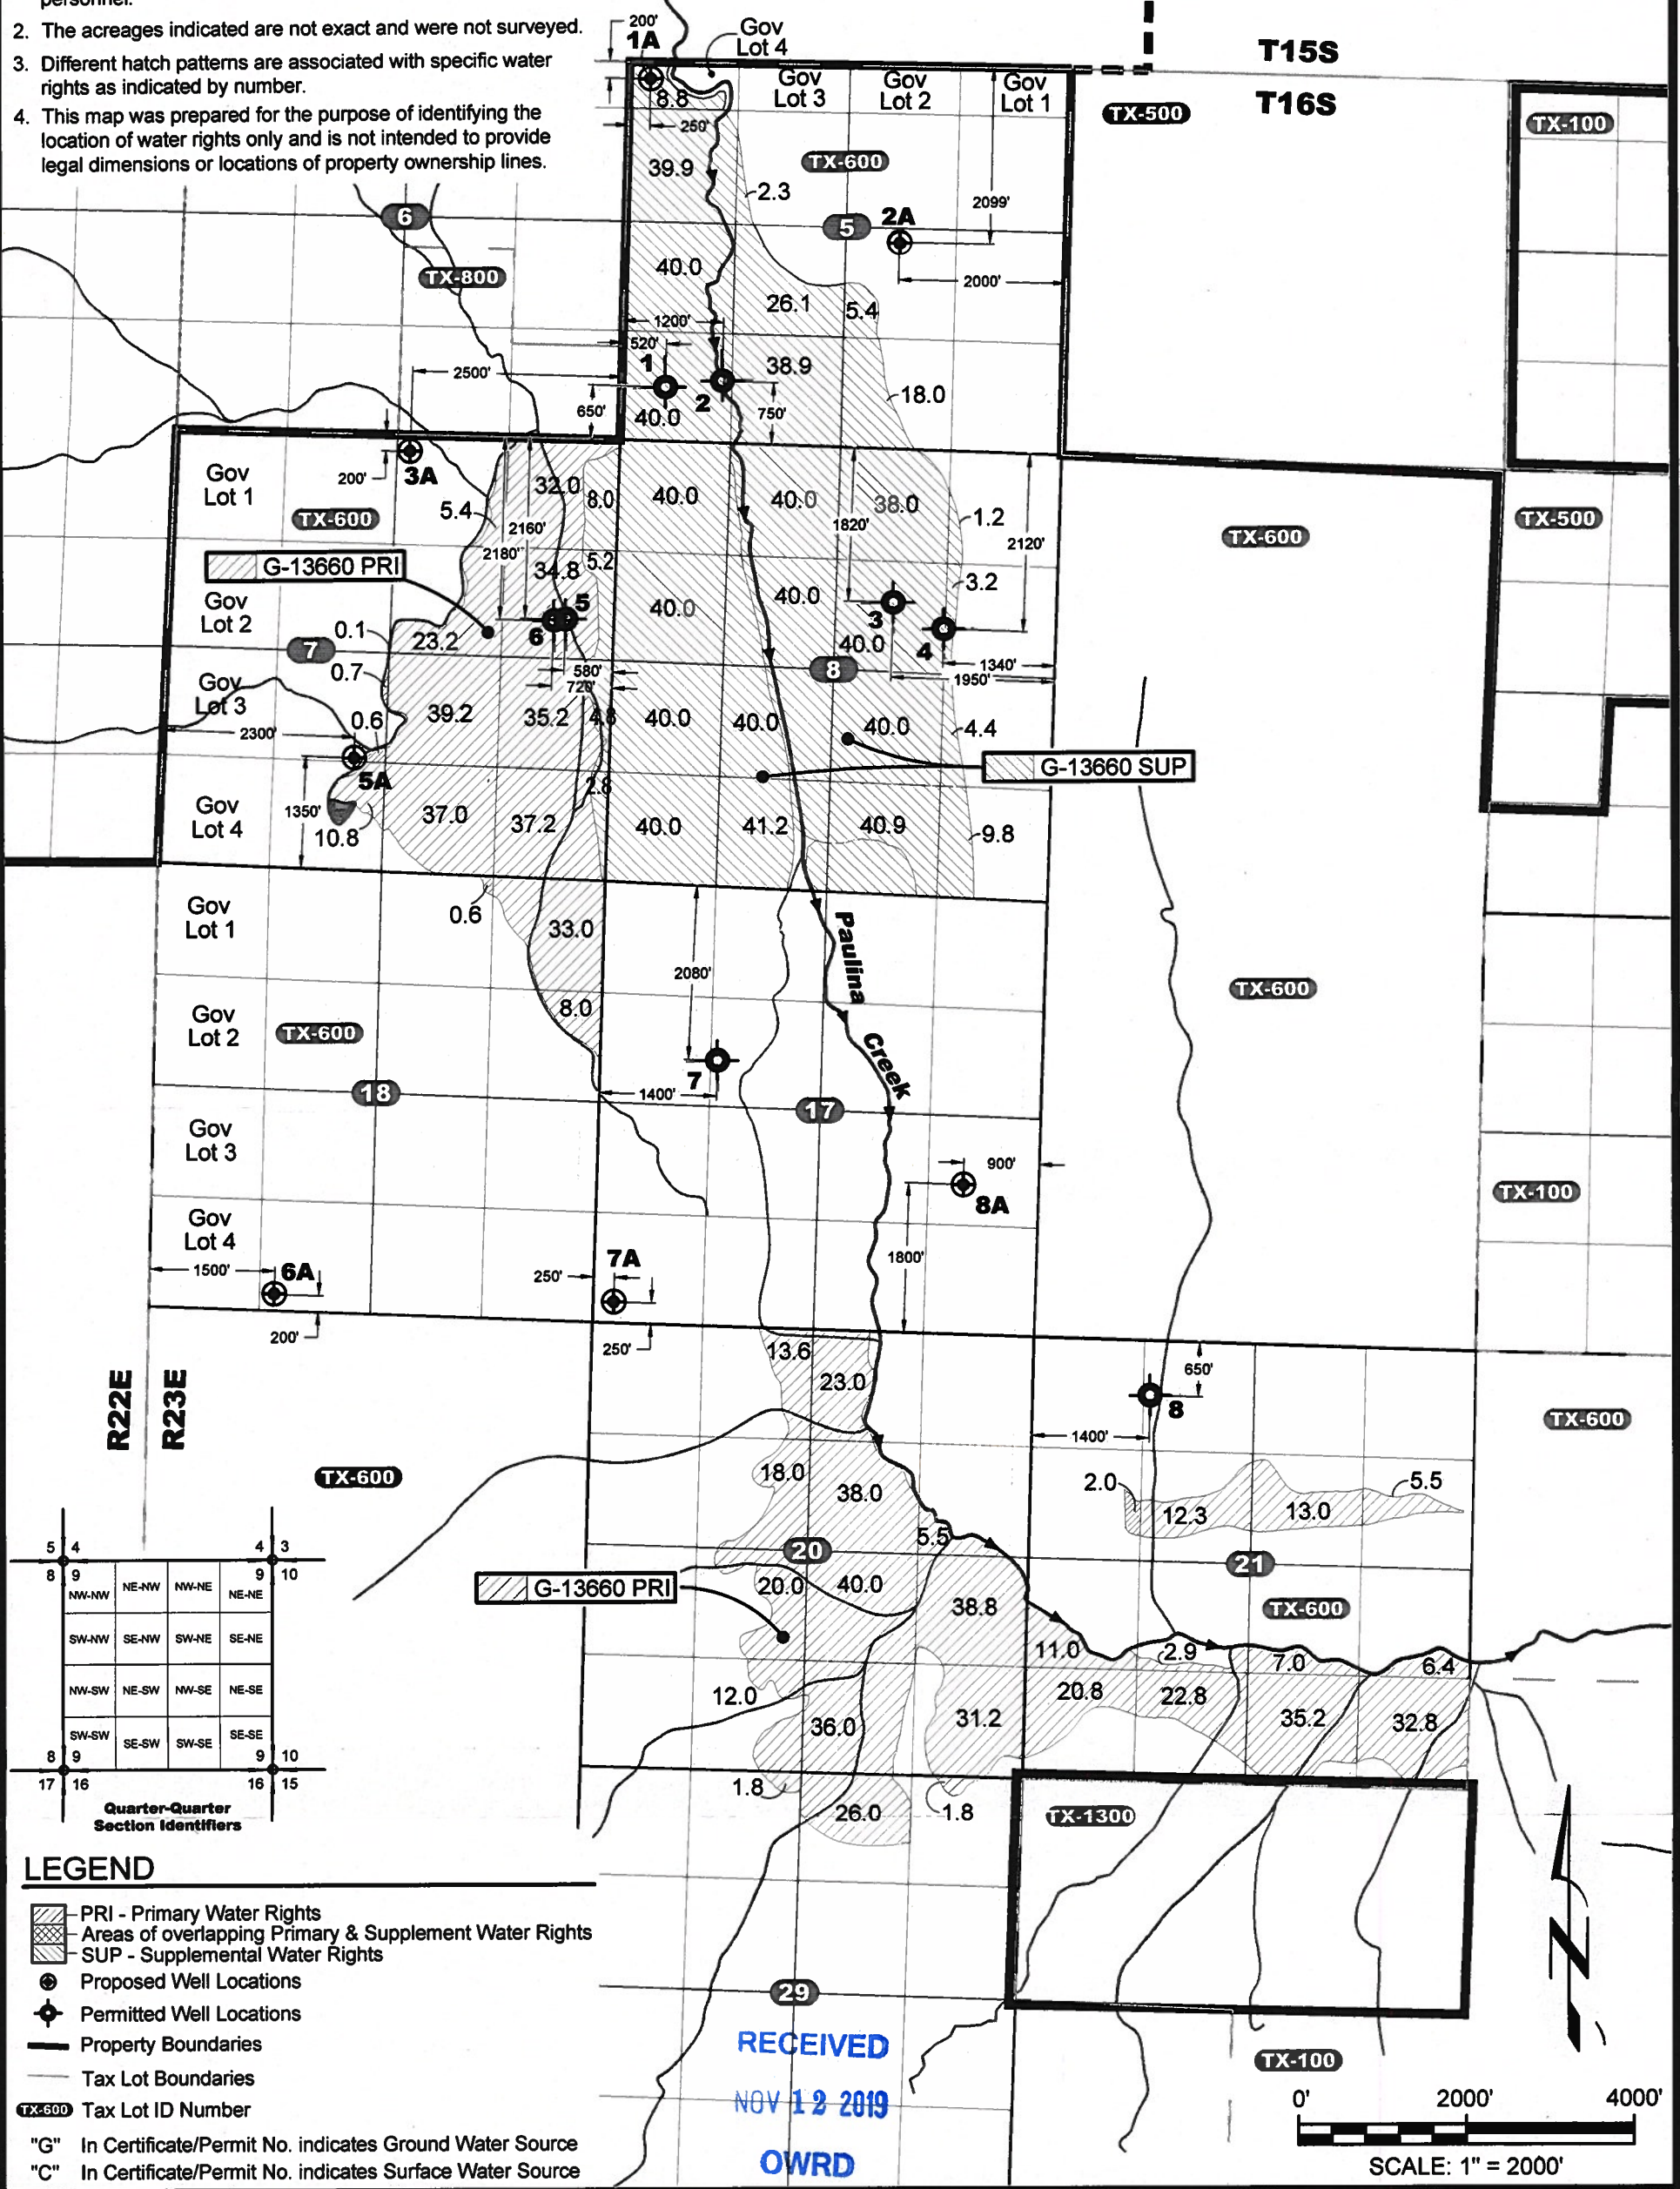

5	4	4	3
8	9	9	10
NW-NW	NE-NW	NW-NE	NE-NE
SW-NW	SE-NW	SW-NE	SE-NE
NW-SW	NE-SW	NW-SE	NE-SE
SW-SW	SE-SW	SW-SE	SE-SE
8	9	9	10
17	16	16	15

Quarter-Quarter Section Identifiers

**LEGEND**

- PRI - Primary Water Rights
- Areas of overlapping Primary & Supplement Water Rights
- SUP - Supplemental Water Rights
- Proposed Well Locations
- Permitted Well Locations
- Property Boundaries
- Tax Lot Boundaries
- Tax Lot ID Number
- "G" In Certificate/Permit No. indicates Ground Water Source
- "C" In Certificate/Permit No. indicates Surface Water Source

Permit Amendment Application - Permit G-13660  
 Blue Mountain Ranch  
 Paulina Creek Basin, Crook County, Oregon

10287