


Salmon Valley Water Company - Permit Amendment to G-11534/ T-10240

T. 2S., R. 7E., W.M. Sections 32 and 33 and T. 3S., R. 7E., W.M. Sections 4, 5 and 9

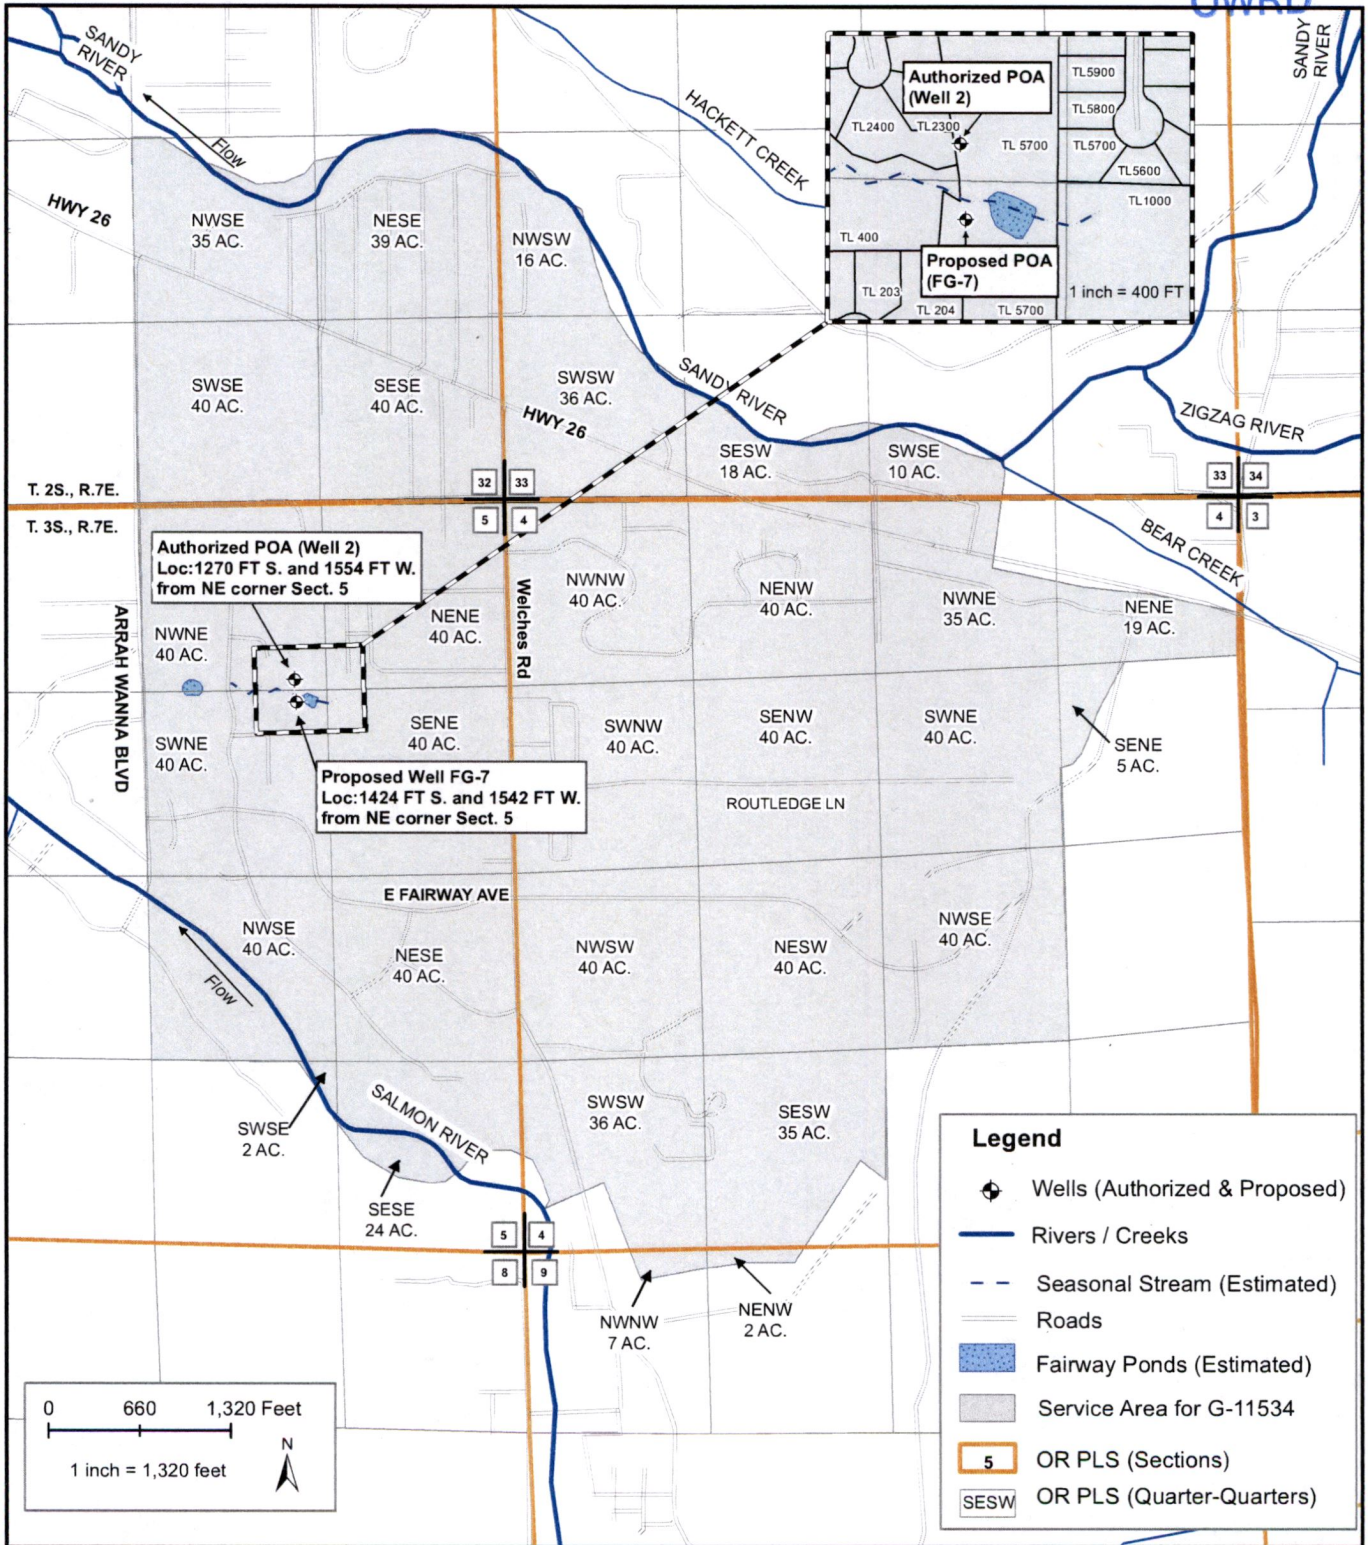

C:\01 Projects\1811002 SVWC FG7 WellPermit Amendment\SVPermAmd_G11531_Map_18May2020.pdf

Permit Amendment to G-11534/ T-10240
Change location of Authorized POA from Well 2 to Proposed Well FG-7

Maps not intended to provide legal dimensions or property ownership lines.



Proj # 1811001
Salmon Valley Water Company
2425 E Welches Rd.
Welches, OR 97067



1319 SE MLK Jr. Blvd, # 204
Portland, Oregon 97214
(503) 954-1326