


Sections 3, 4, 9 & 10, T17S, R20E, W.M.,  
Crook County, Oregon

RECEIVED





JUN 12 2020

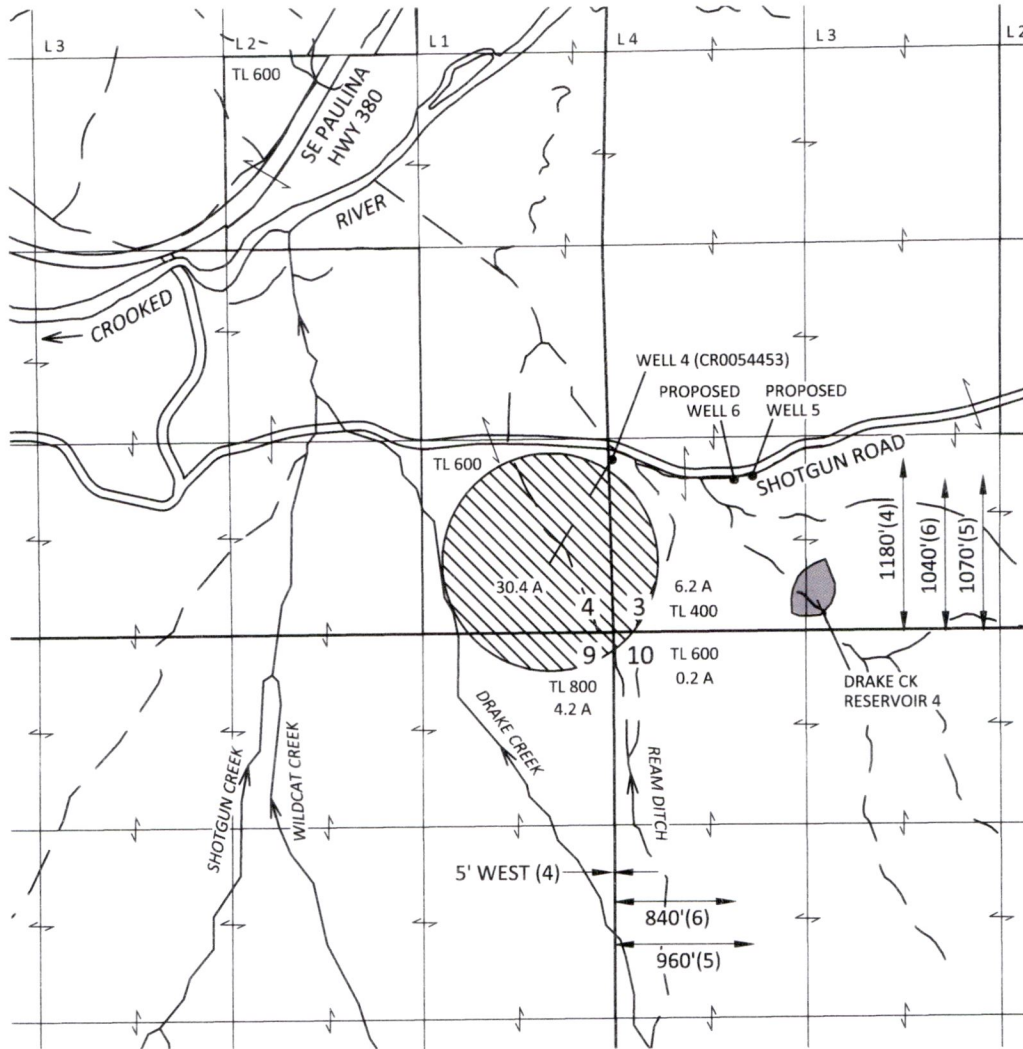
PERMIT AMENDMENT MAP  
Application G-18604, Permit G-18245  
Shotgun Ranch LLC

OWRD



EXPLANATION

-  SUPPLEMENTAL IRRIGATION  
41.0 ACRES  
PRIORITY: 1/31/2018
-  STORAGE  
PRIORITY: 1/31/2018
-  WELL
-  PIPE

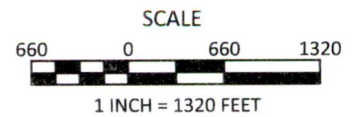

June 3, 2020

This map is not intended to provide legal  
dimensions or locations of property  
ownership lines

Figure 2

**SKOOKUM**  
WATER ASSOCIATES INC

1626 VICTORIAN WAY  
EUGENE, OR 97401  
(503) 319-8926