


S.E. 1/4 SEC. 4 T.8S. R.4W. WM.

Township 8 S
Range 4 W
Section 4 D
1/4 1/4 SWSE
Tax Lot 1900

4.75 acres on tax lot
1900
in 1/4 1/4 SWSE

Two wells as marked with ★

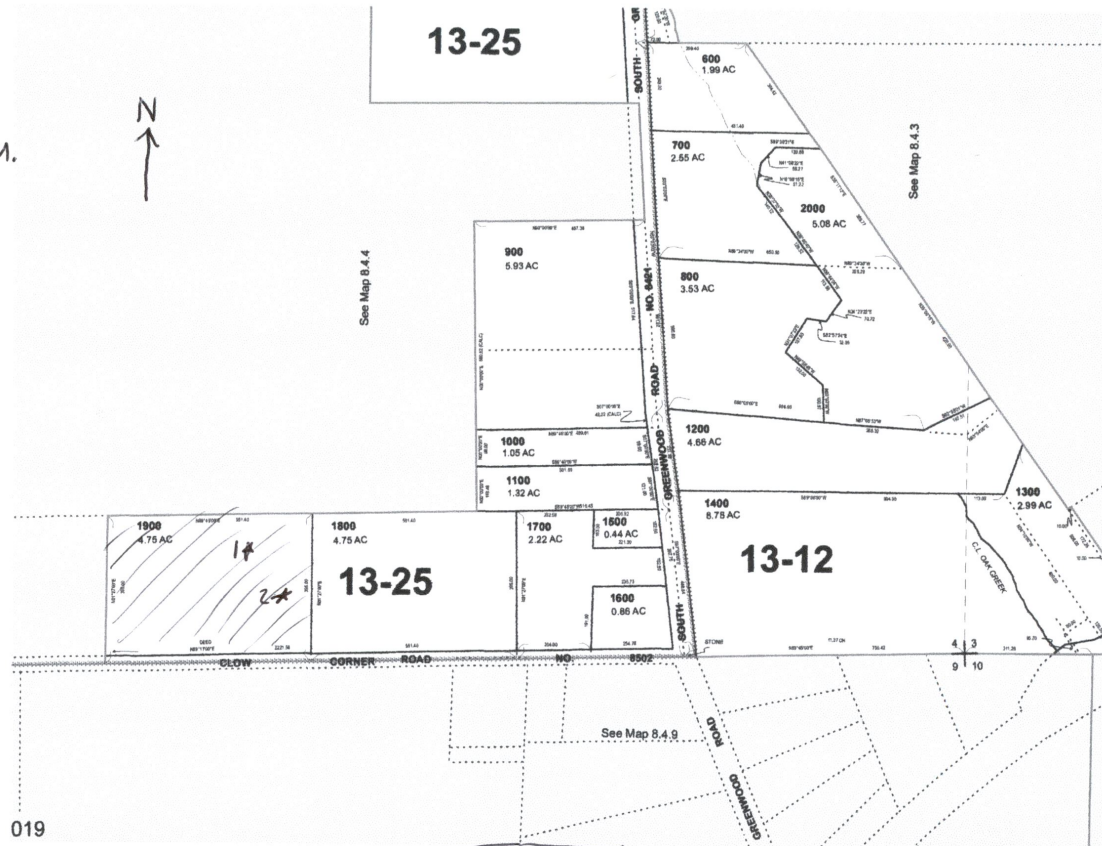

RECEIVED
MAY 31 2019
OWRD

G-18826

Well #1 1,900' west of SE corner of section 4 and 200' North of SE corner of Section 4
Well #2 1,860' west of SE corner of Section 4 and 110' North of SE corner of Section 4.