


04 1W 05B  
CLACKAMAS  
COUNTY

04 1W 05B

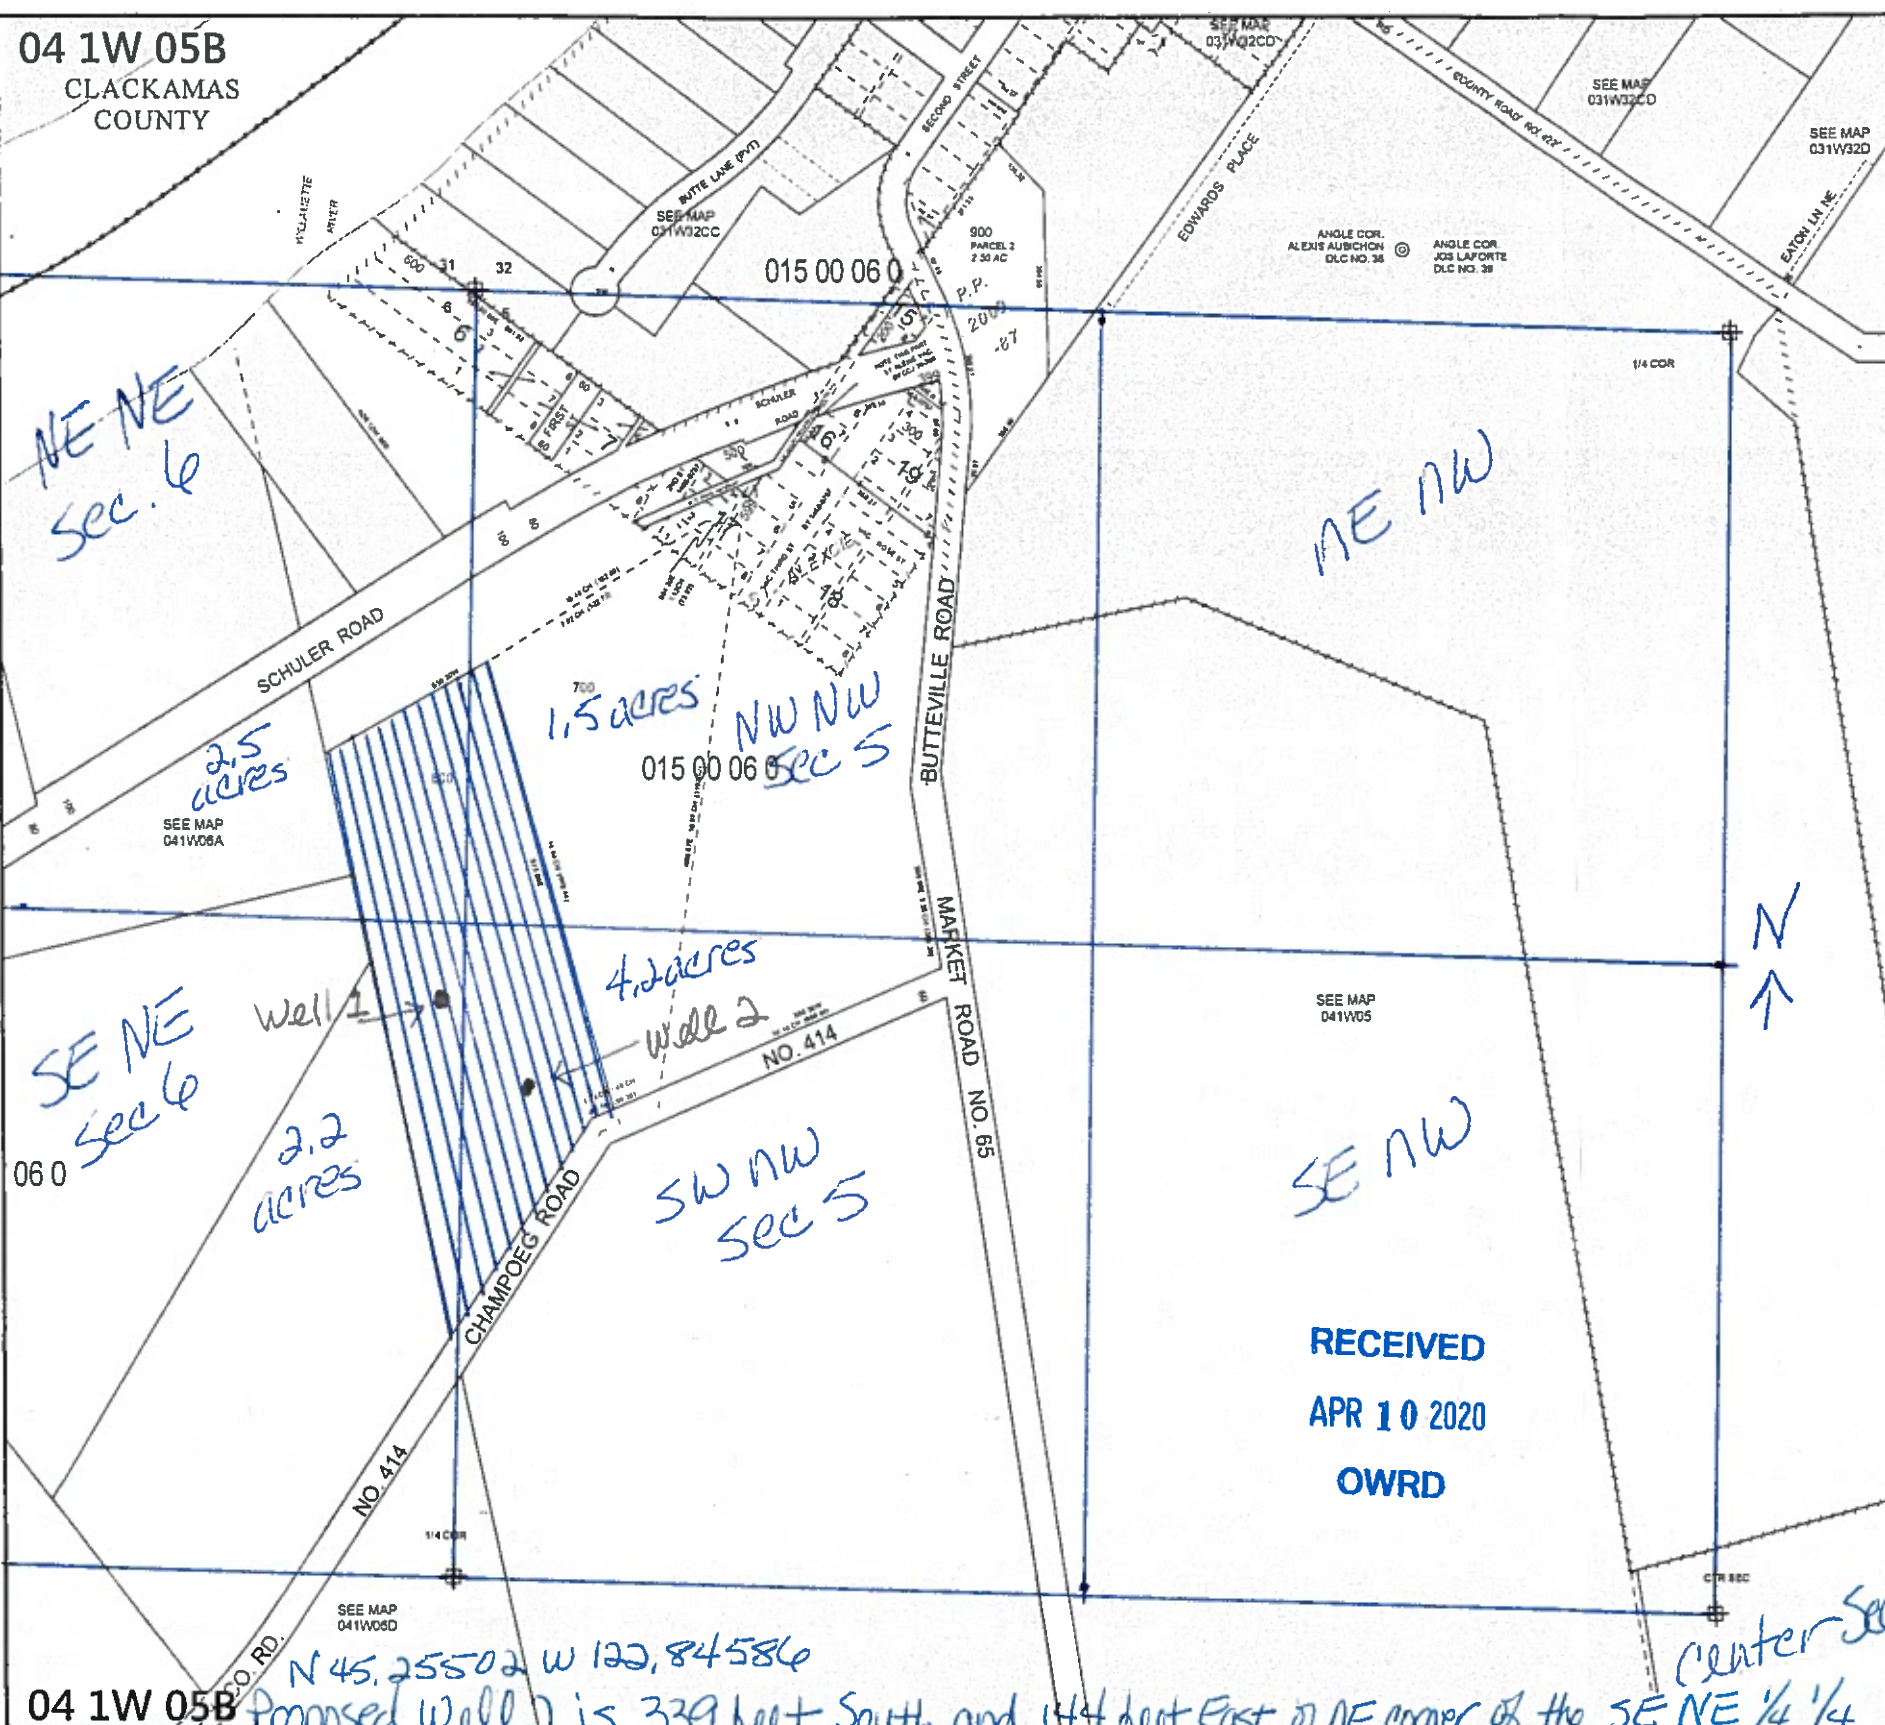

MARION COUNTY, OREGON  
 NW1/4 SEC5 T4S R1W W.M.  
 SCALE

**LEGEND**

LINE TYPES	
Taxlot Boundary	Historical Boundary
Road Right-of-Way	Easement
Railroad Right-of-Way	Railroad Centerline
Private Road ROW	Taxcode Line
Subdivision/Plat Bndry	Map Boundary
Waterline - Taxlot Bndry	Waterline - Non Bndry

**CORNER TYPES**

+ 1/16TH Section Cor.	⊕ 1/4 Section Cor
⊙ DIC Corner	16, 15 ⊕ Section Corner 21, 22

**NUMBERS**  
 Tax Code Number  
 000 00 00 0  
 Acreage 0.23 AC All acres listed are Net Acres, excluding any portions of the taxlot within public ROWs

**NOTES**  
 Tick Marks: A tick mark in the road indicates that the labeled dimension extends into the public ROW

**CANCELLED NUMBERS**

400			
-----	--	--	--

DISCLAIMER: THIS MAP WAS PREPARED FOR ASSESSMENT PURPOSES ONLY



FOR ADDITIONAL MAPS VISIT OUR WEBSITE AT [www.co.marion.or.us](http://www.co.marion.or.us)

PLOT DATE: 1/23/2018

04 1W 05B

04 1W 05B Proposed Well 2 is 339 feet South and 144 feet East of NE corner of the SE NE 1/4 1/4  
 Well 1 is 147 feet South and 54 feet West of the NE corner of the SE NE 1/4 1/4 - N 45.25557 W 122.84669

Scale 1" = 400'

RECEIVED  
 APR 10 2020  
 OWRD

Center Section 5