


**T29S R31E, WM,
HARNEY COUNTY, OR**



0 1,320 Feet

1" = 1320'

- APOA Well
- Observation Well
- Authorized Well
- POU IR
- Section
- Quarter Quarter
- Tax Lot

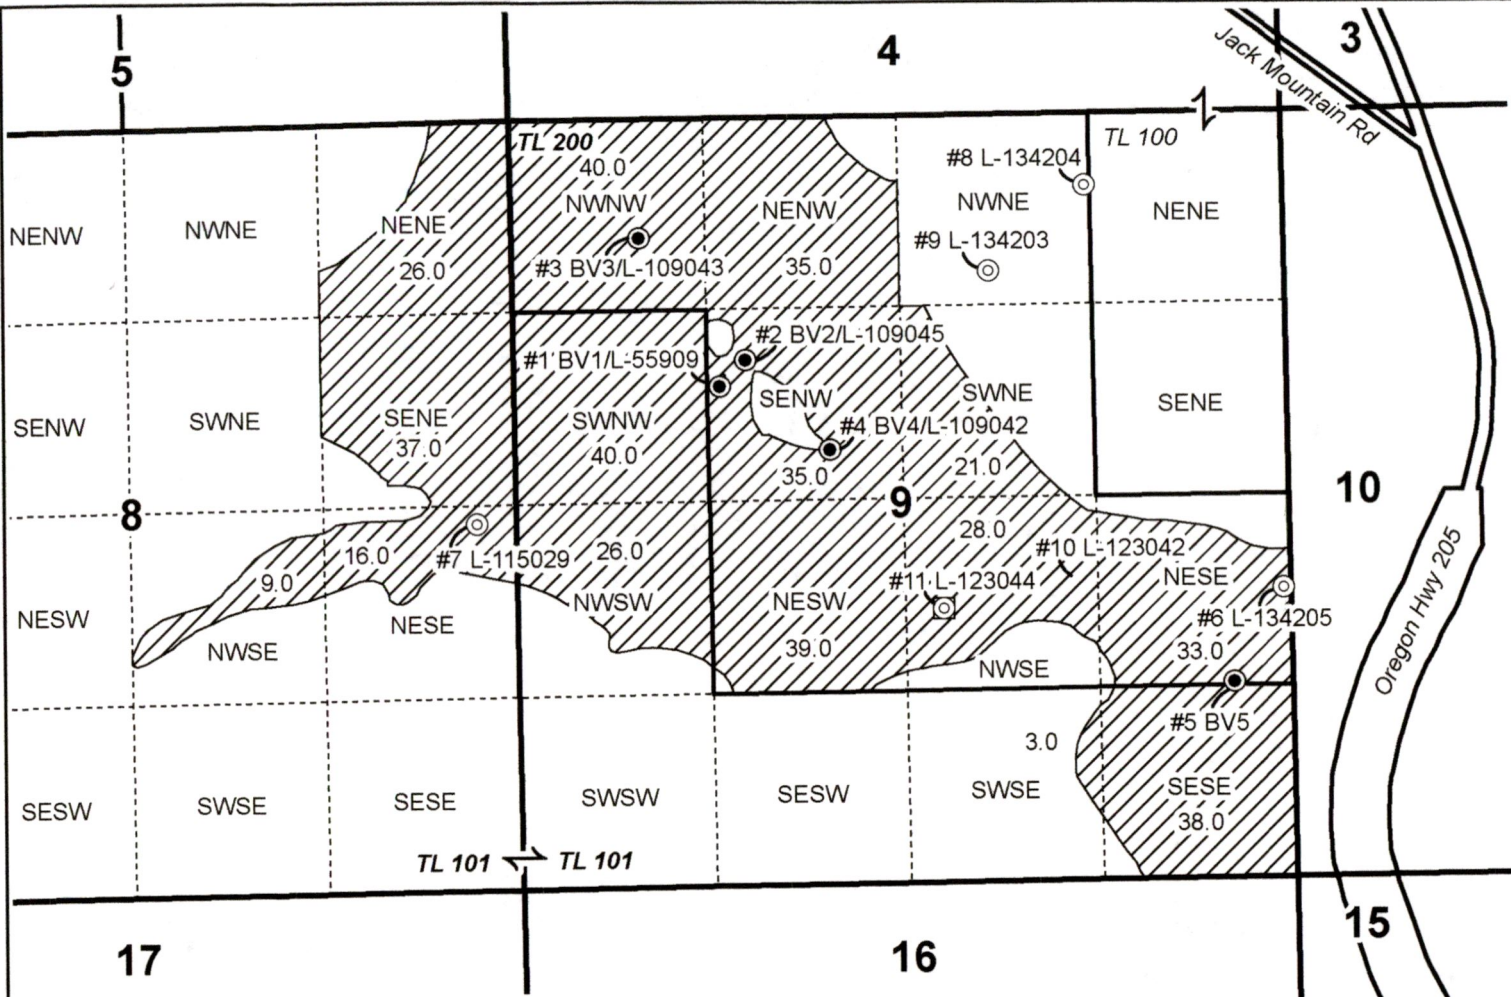

Well Locations:

- #1 (BV1/L-55909): 1828' S, 1429' E of NW Cor Sec 9
- #2 (BV2/L-109045): 1657' S, 1608' E of NW Cor Sec 9
- #3 (BV3/L-109043): 805' S, 891' E of NW Cor Sec 9
- #4 (BV4/L-109042): 2271' S, 2184' E of NW Cor Sec 9
- #5 (BV5): 3920' S, 4937' E of NW Cor Sec 9
- #6 (L-134205): 3320' S, 5280' E of NW Cor Sec 9
- #7 (L-115029): 2770' S, 230' W of NW Cor Sec 9
- #8 (L-134204): 460' S, 3930' E of NW Cor Sec 9
- #9 (L-134203): 1050' S, 3270' E of NW Cor Sec 9
- #10 (L-123042): 3180' S, 3900' E of NW Cor Sec 9
- #11 (Observation Well L-123044): 3360' S, 2960' E of NW Cor Sec 9

Received by OWRD

MAY 03 2021

Salem, OR



**APOA PERMIT AMENDMENT MAP
Otley Brothers Inc.**

This map is not intended to provide legal dimensions or locations of property ownership lines.

WATER RIGHT SERVICES, LLC
PO BOX 1830, BEND, OR 97709
WWW.OREGONWATER.US CCB # 197121
johnshort@usa.com 541-389-2837