


THIS MAP WAS PREPARED FOR ASSESSMENT PURPOSE ONLY.

T-400

70  
~~XXXXXXXXXX~~

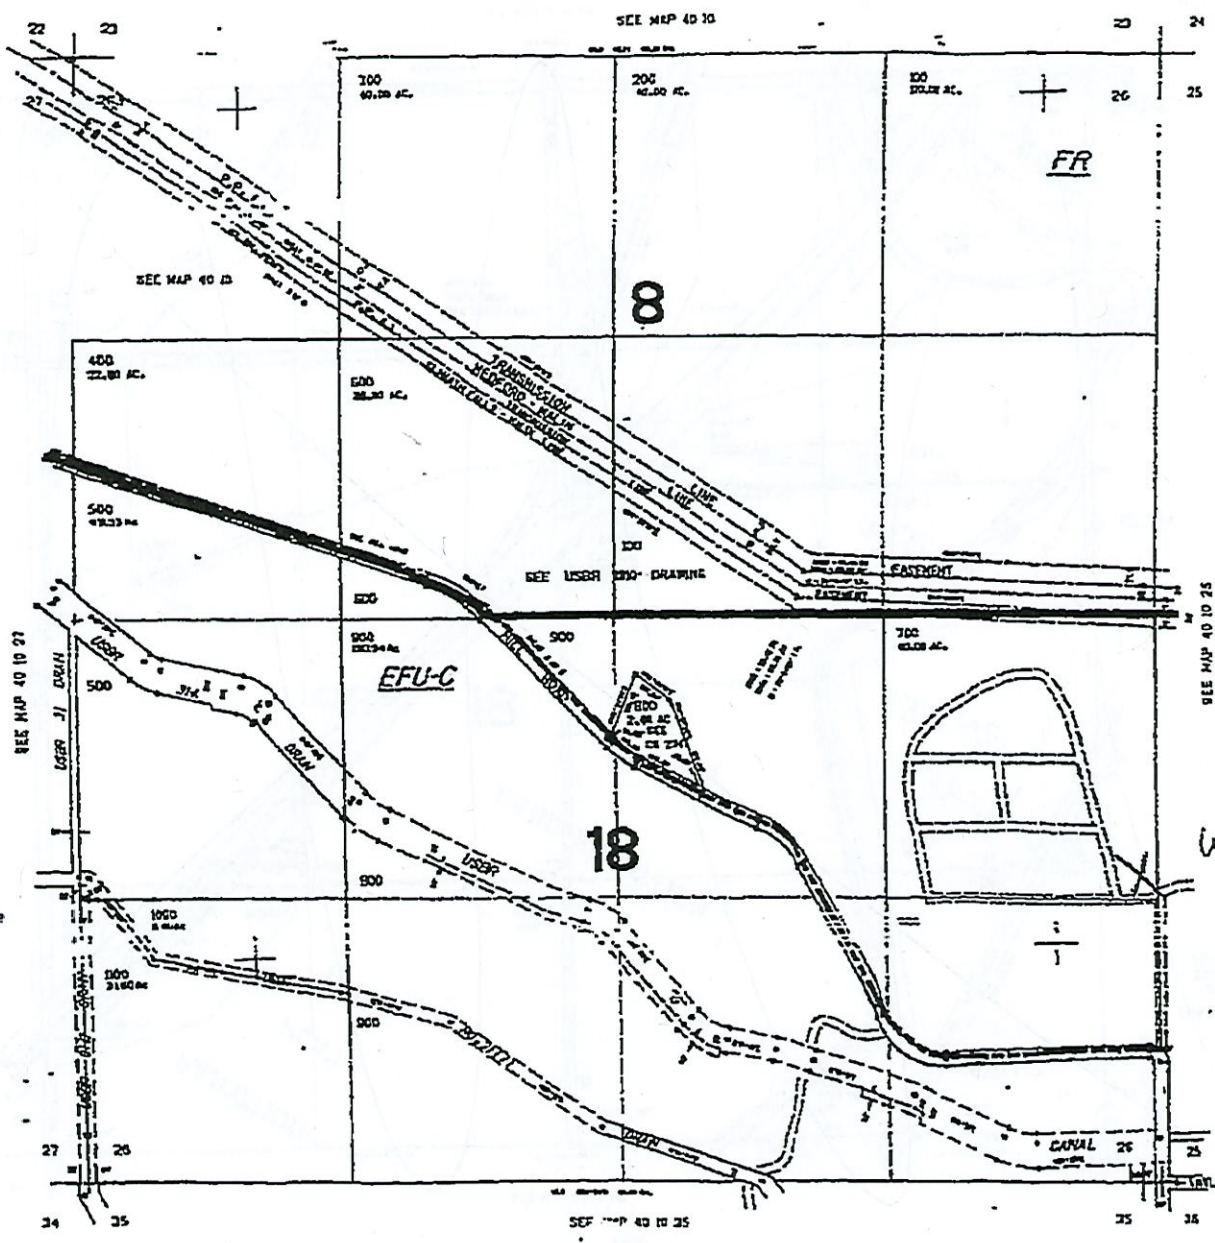

Map 1 of 7

RECEIVED  
MAY 28 2020  
OWRD

NORTH  
T. 40 S. R. 1 E  
Sec. 26

Well location  
1380' NORTH of  
80' West of  
SE corner  
Sec. 26

superseded

Map 1 of  
40 10 26

Map created  
02/05/2021


Hill  
Hickey  
Carleton

REVISED 04-14-15  
THIS MAP WAS PREPARED FOR  
ASSESSMENT PURPOSE ONLY

SECTION 26 T.40S. R.10E. W.M.  
KLAMATH COUNTY  
T-400°

NORTH  
↑

T40S R10E  
SEC. 26

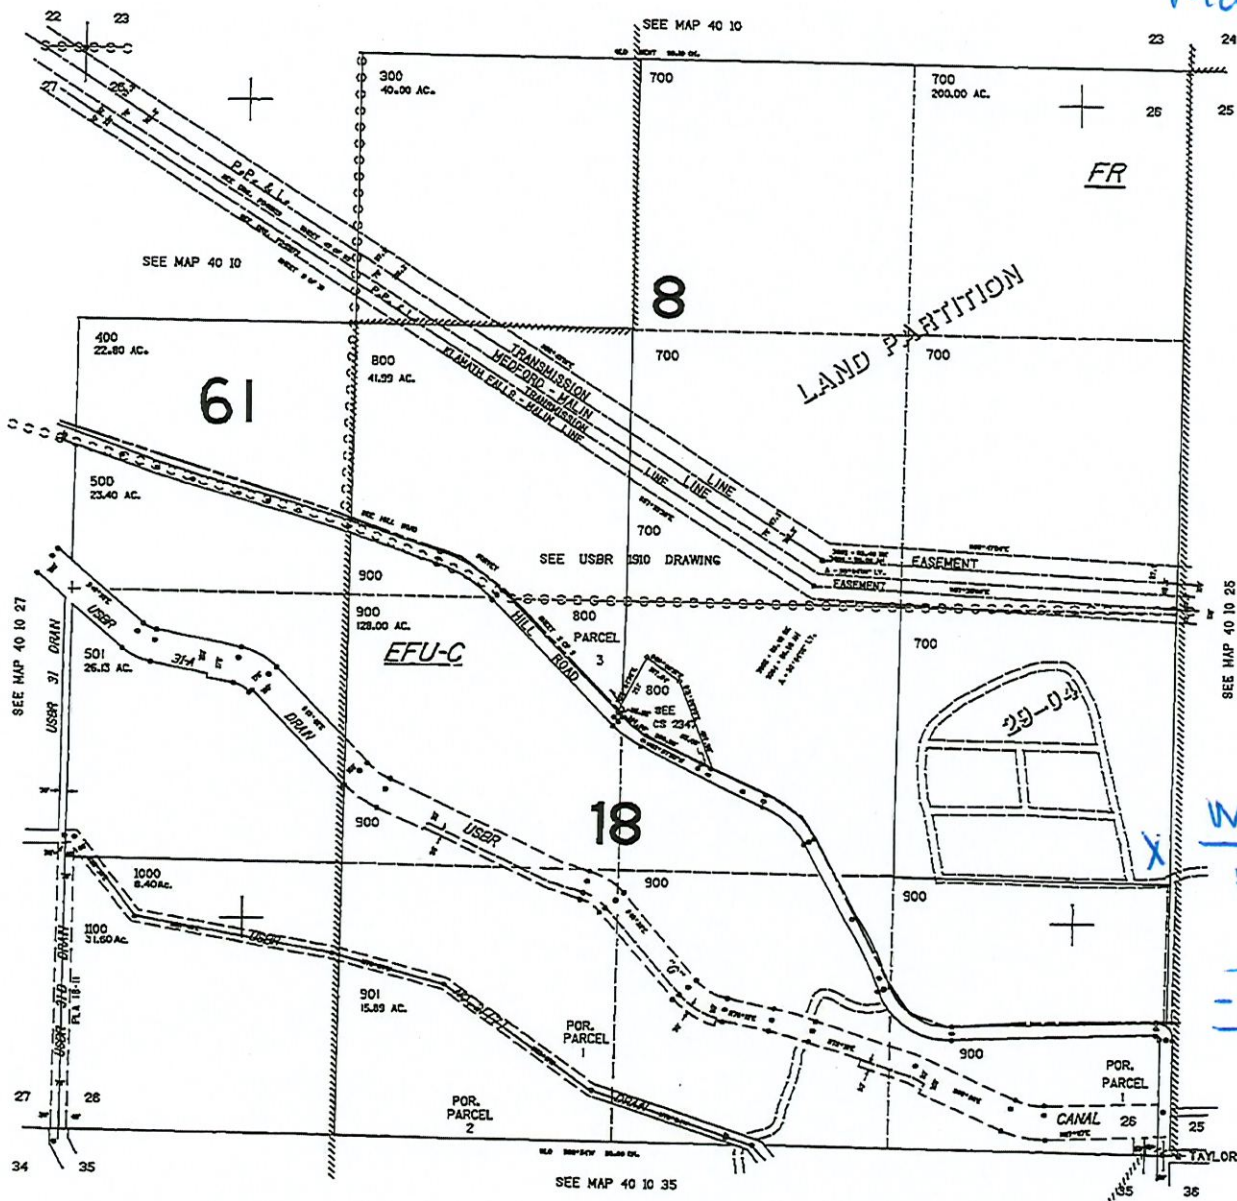

CANCELLED NO.  
100  
200  
600

Well Location  
KLAM 52932  
144.000  
42.0570  
-121.6005

Scale  
1" = 880'

RECEIVED  
APR 01 2021

40 10 26 OWRD

1697000



REVISED 10-22-2019  
THIS MAP WAS PREPARED FOR  
ASSESSMENT PURPOSE ONLY

SECTION 08 T.40S. R.10E. W.M.  
KLAMATH COUNTY  
1" = 400'


Map of  
40 10 08

Map created  
02/23/2021

RECEIVED  
APR 01 2021  
OWRD

NORTH  
T40 S R10E  
SEC 8  
Tax lot  
1001-SESW 25.66  
1101 SWSW 30.11

Scale  
1" = 880'

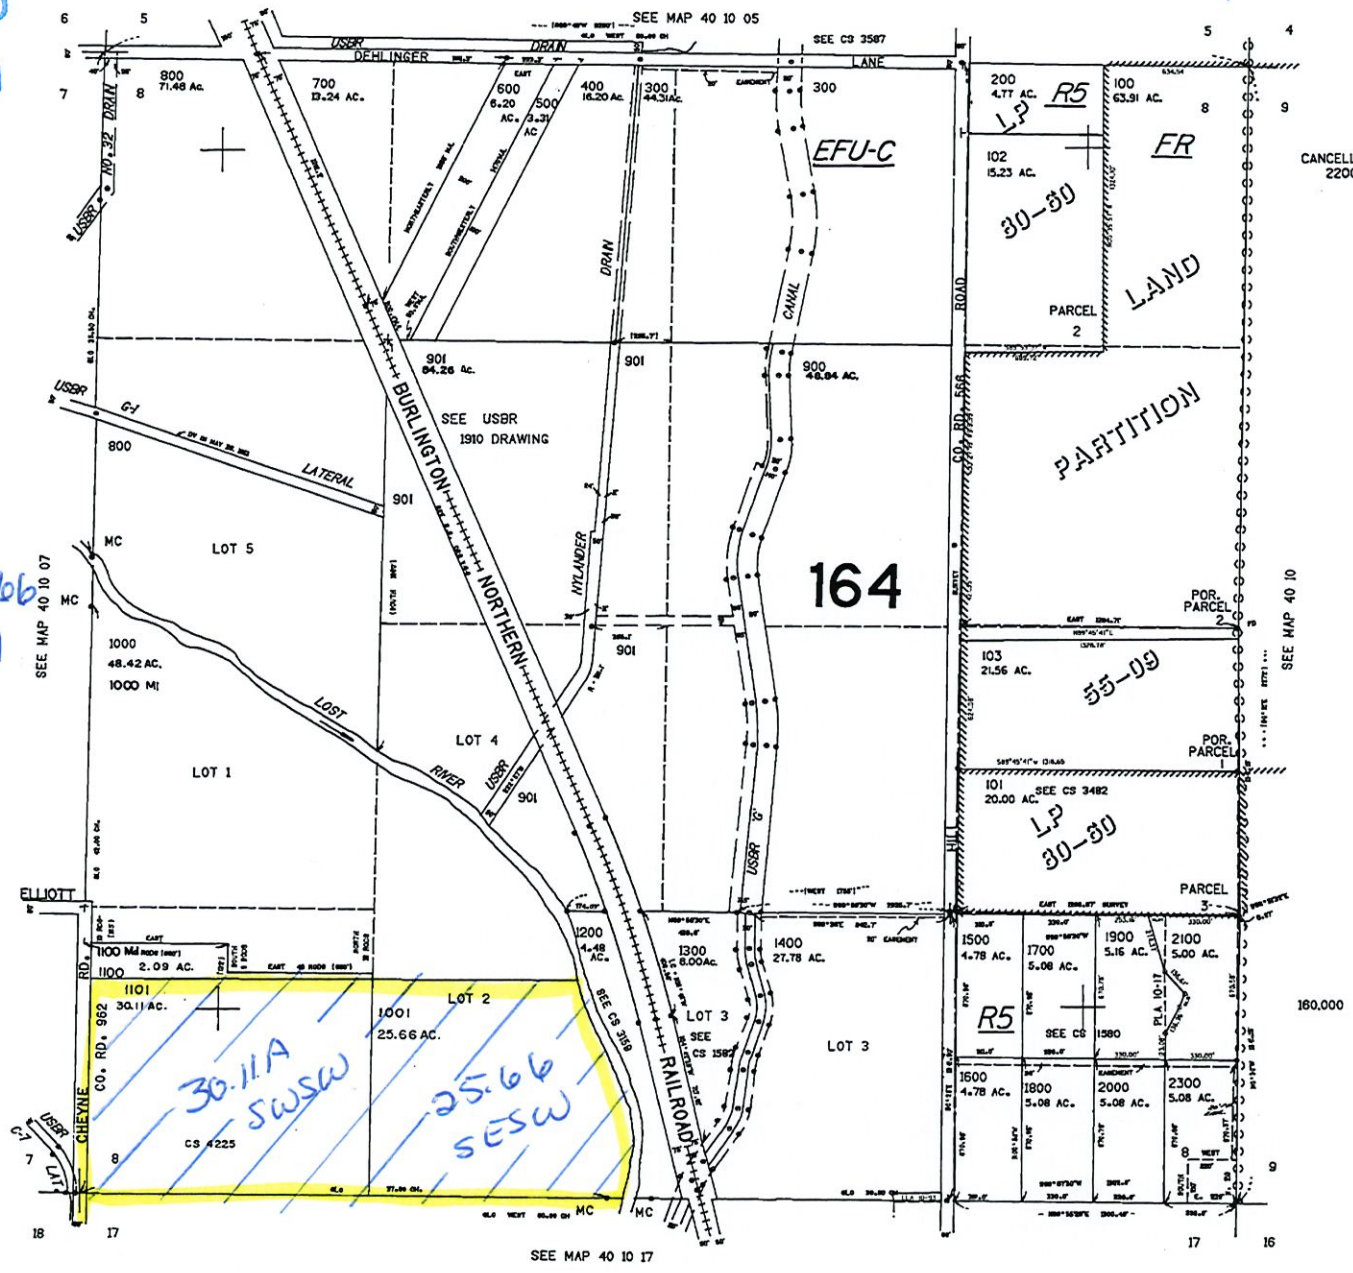

CANCELLED NO.  
2200

164

30.11A  
SWSW

25.66  
SESW

SEE MAP 40 10 10

180.000

SEE MAP 40 10 17

Map of

40 10 26


Map created  
02/23/2021

REVISED 04-14-15  
THIS MAP WAS PREPARED FOR  
ASSESSMENT PURPOSE ONLY

SECTION 26 T.40S. R.10E. W.M.  
KLAMATH COUNTY

1"=400'

CANCELLED NO.  
100  
200  
600

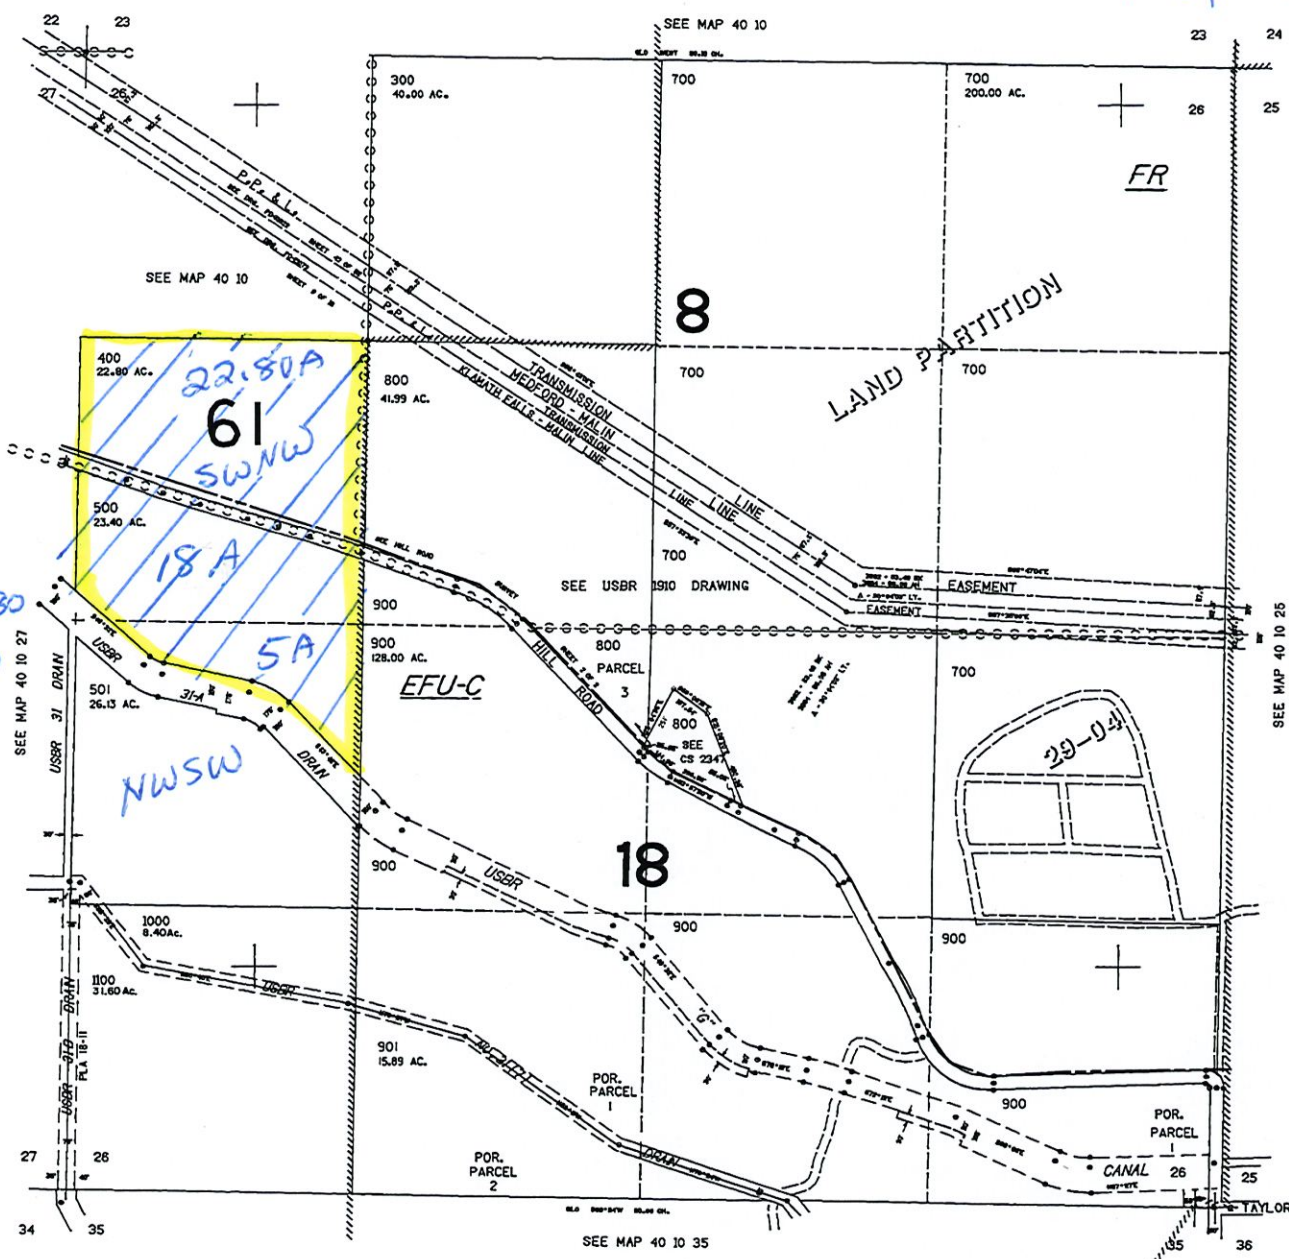

RECEIVED

APR 01 2021

OWRD

NORTH

T40S R10E  
SEC 26

Tax  
400 - SWNW 22.80  
500 SWNW 18.0  
NWSW 5.A

Scale  
1" = 880'

1697,000

40 10 26




REVISED 02-12-15  
THIS MAP WAS PREPARED FOR  
ASSESSMENT PURPOSE ONLY

SECTION 34 T.40S. R.10E. W.M.  
KLAMATH COUNTY

Map of  
40 10 34  
Map created  
02/23/2021

RECEIVED  
APR 01 2021  
OWRD  
NORTH  
T40S R10E  
SEC 34  
Tax lot  
700 - SENE 38.00  
NESE 5.00

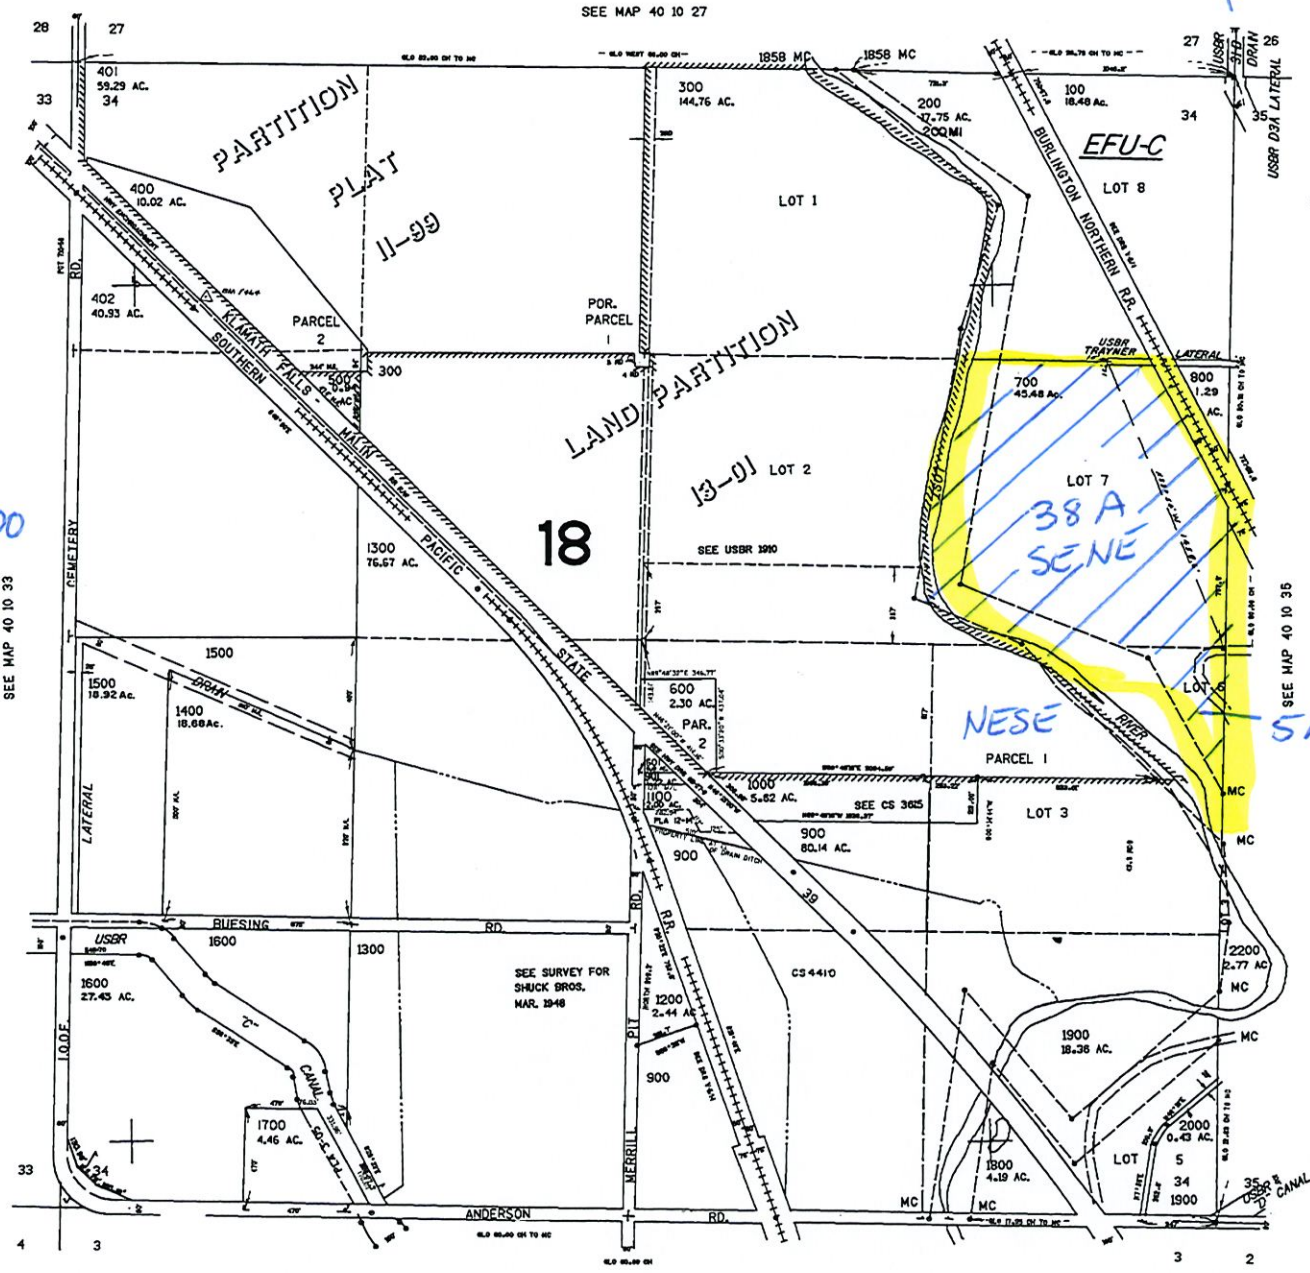

CANCELLED NO.  
301  
2100 A1  
2300A1

Scale  
1" = 880'

SEE MAP 41 10 03

40 10 34

Map of  
40 10 35  
Map created  
02/23/2021


REVISED 9-15-08  
THIS MAP WAS PREPARED FOR  
ASSESSMENT PURPOSE ONLY

SECTION 35 T.40S. R.10E. W.M.  
KLAMATH COUNTY  
1"=400'

RECEIVED  
APR 01 2021  
OWRD  
NORTH

T40 S R10E  
SEC. 35  
Tax lot

700	SWNW	2.00
800	NWSW	15.74
800	NWSW	5.14
1000	SWSW	35.57
1100	SESW	4.12
1200	NESW	0.79
1200	SESW	31.00
1300	NESE	38.0
1300	NWSE	12.00

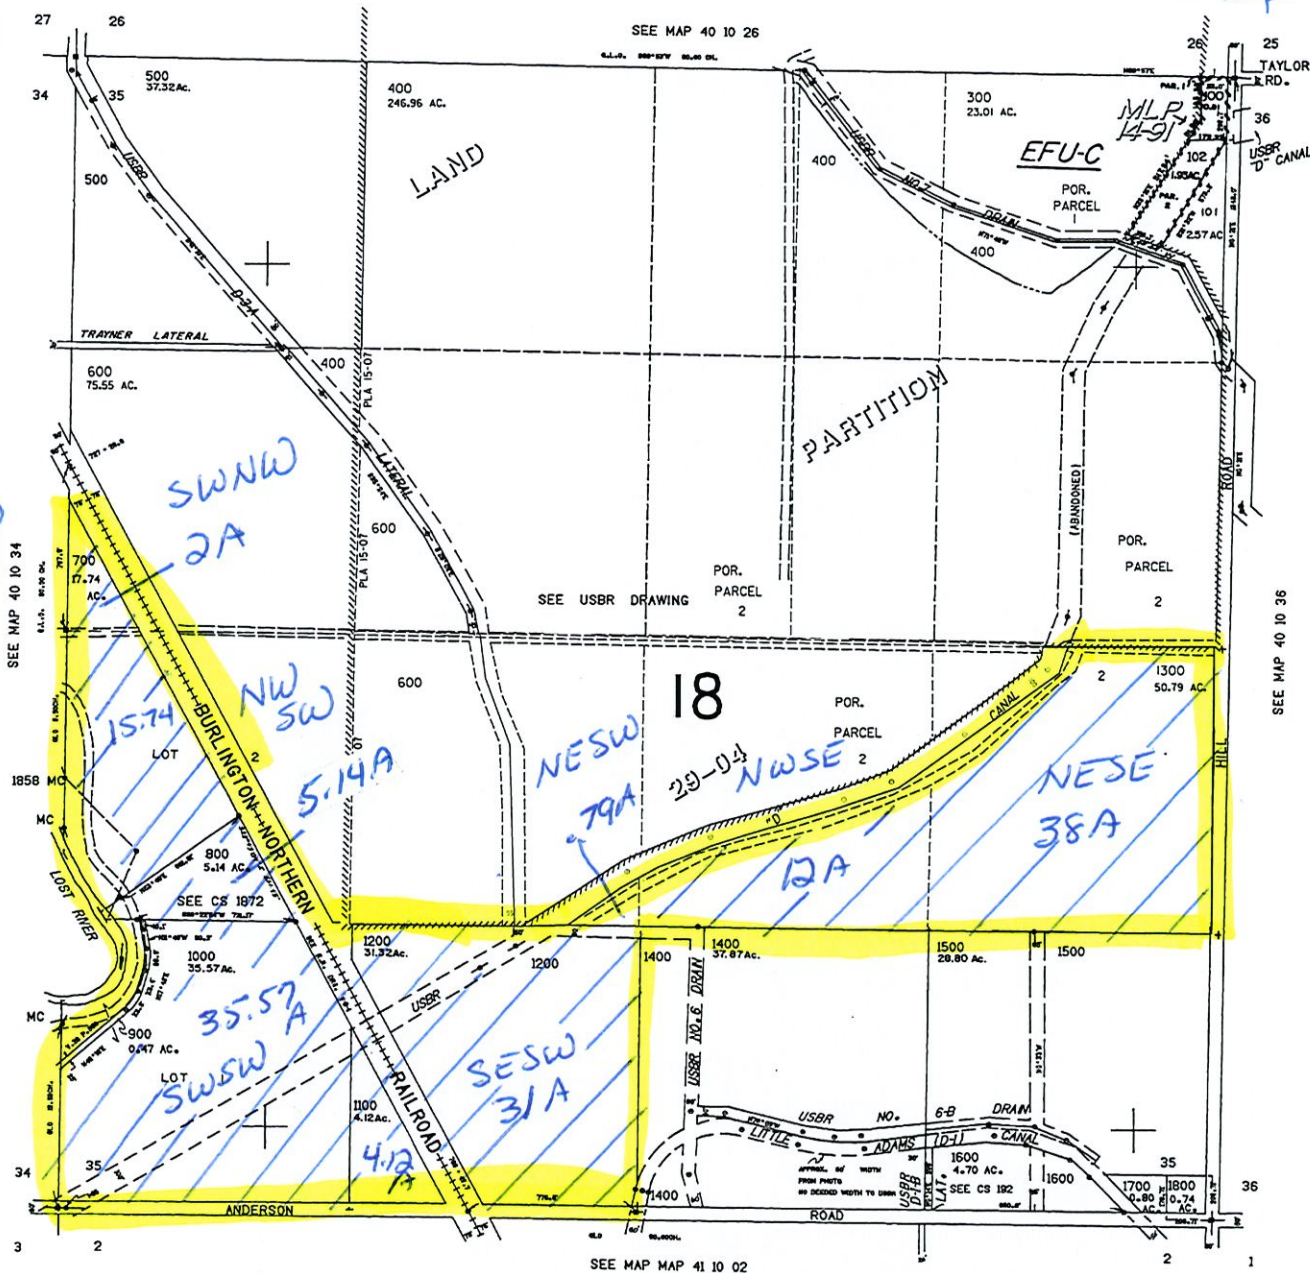

CANCELLED NO.  
200  
1301

138.000

1667,000

40 10 35



RECEIVED

APR 01 2021

OWRD

Map of

40 10 36


Map created  
02/23/2021

SECTION 36 T.40S. R.10E. W.M.  
KLAMATH COUNTY

1"=400'

SEE MAP 40 10 25

THIS MAP WAS PREPARED FOR  
ASSESSMENT PURPOSE ONLY.

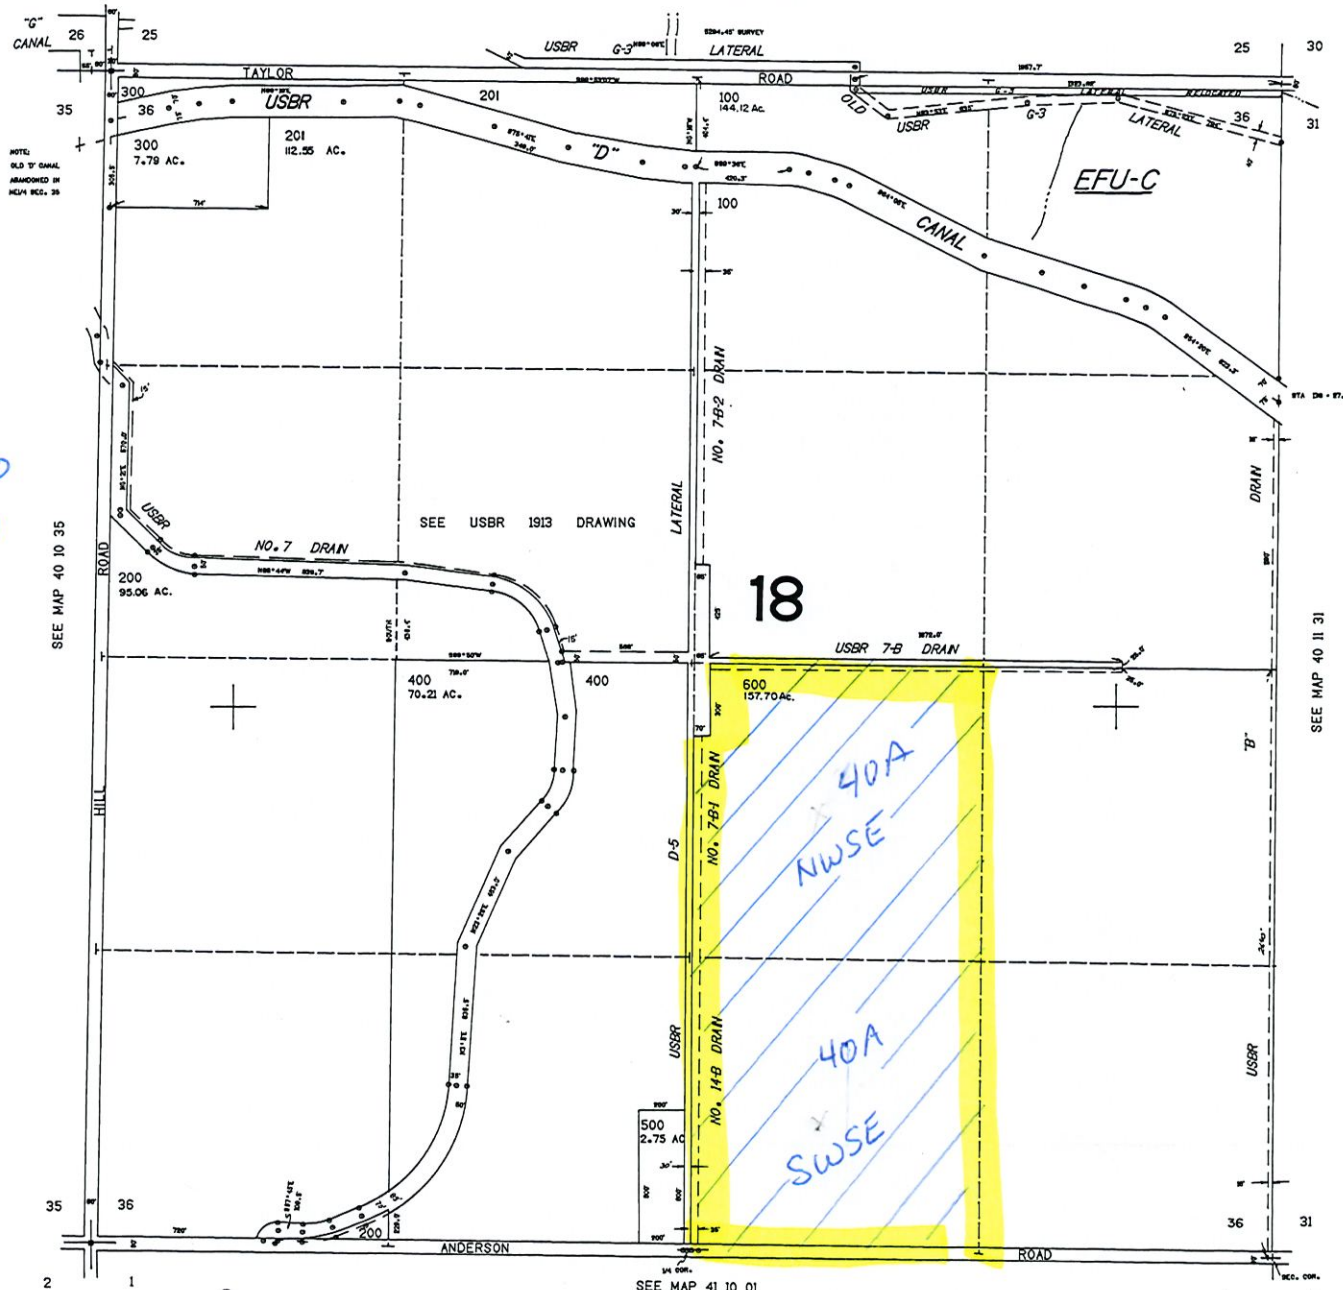

NORTH

T40S R10E  
SEC. 36

Tax lot  
600 NWSW 40.0  
SWSE 40.0

Scale

1"=880'

SEE MAP 40 11 31

140,000

SEE MAP 41 10 01

40 10 36

RECEIVED

APR 01 2021

OWRD

NORTH

T40S R11E

SEC 31

Tax lot

100 NENE 40.0

NWNE 40.0

SWNE 35.0

SENE 38.0

NWSE 25.0

600 NESE 40.0

SESE 35.40

Scale

1" = 880'

Map of


40 11 31

Map created 02/23/2021

SECTION 31 T.40S. R.11E. W.M.  
KLAMATH COUNTY

1"=400'

THIS MAP WAS PREPARED FOR  
ASSESSMENT PURPOSE ONLY.

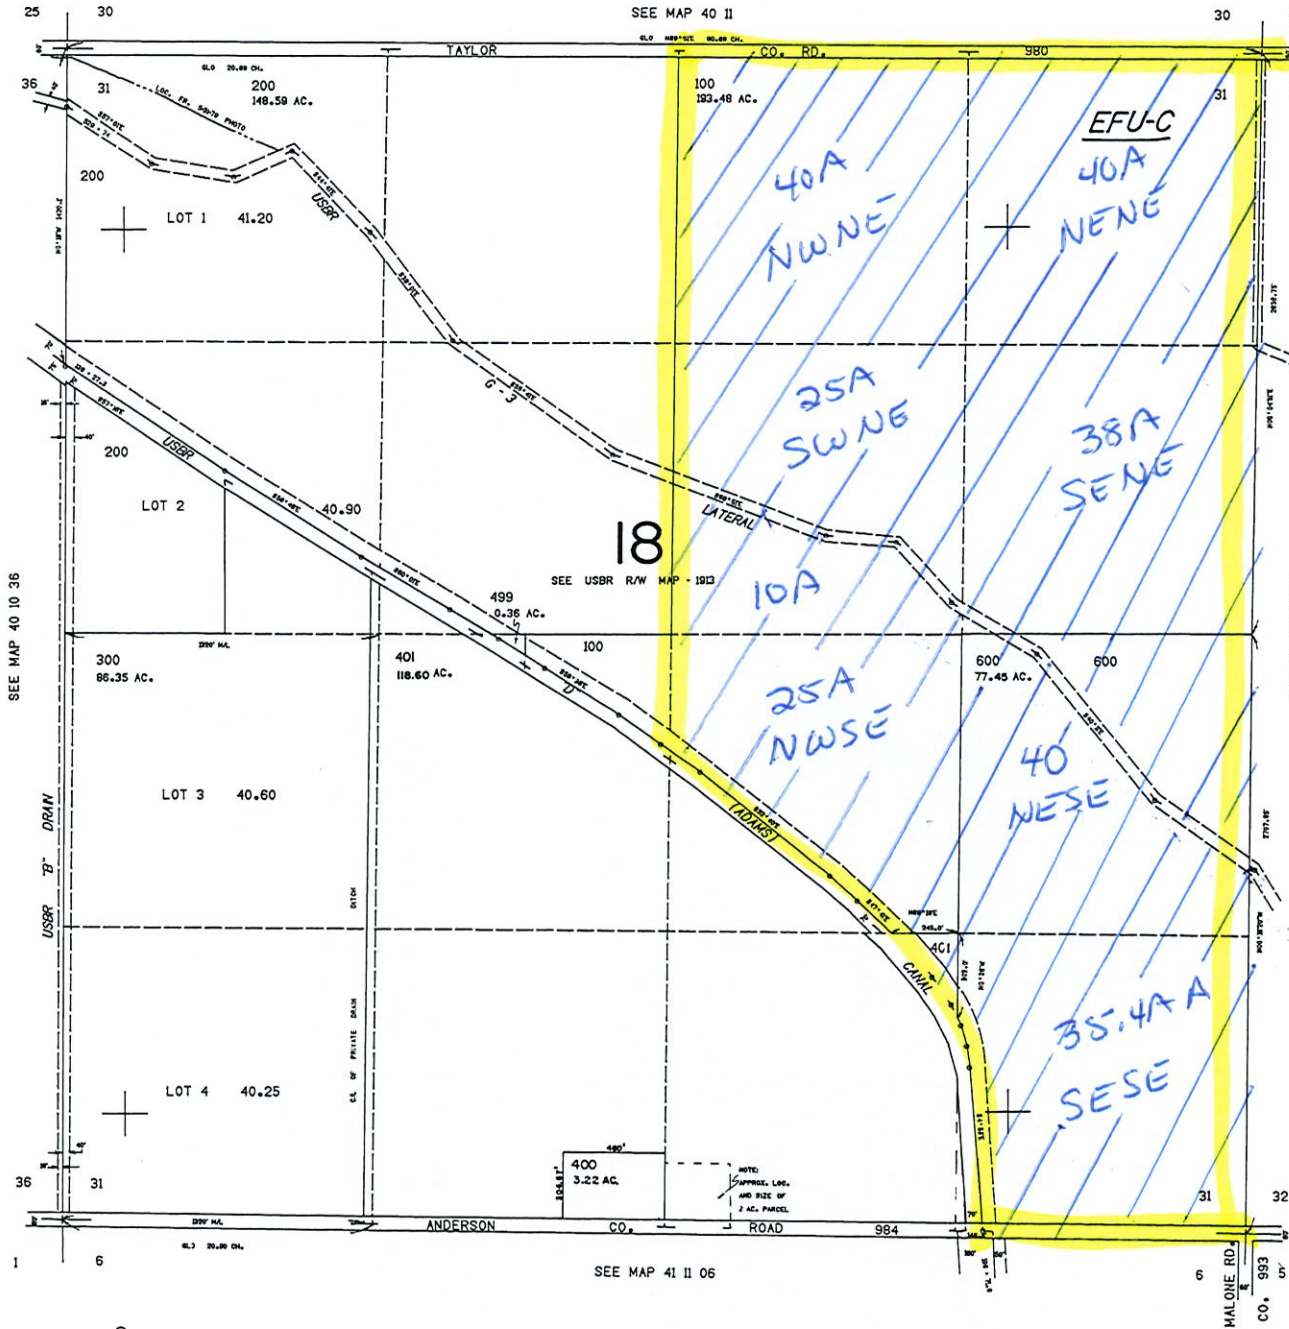

138,000

40 11 31



REVISED 05-03-2017  
THIS MAP WAS PREPARED FOR  
ASSESSMENT PURPOSE ONLY

SECTION 32 T.40S. R.11E. W.M.  
KLAMATH COUNTY  
1" = 400'

40 11 32


Map of  
Map created  
02/23/2021

RECEIVED  
APR 01 2021  
OWRD

NORTH

T40S R11E  
SEC. 32  
Tax lot  
1300 NWSW  
15.00

Scale  
1" = 880'

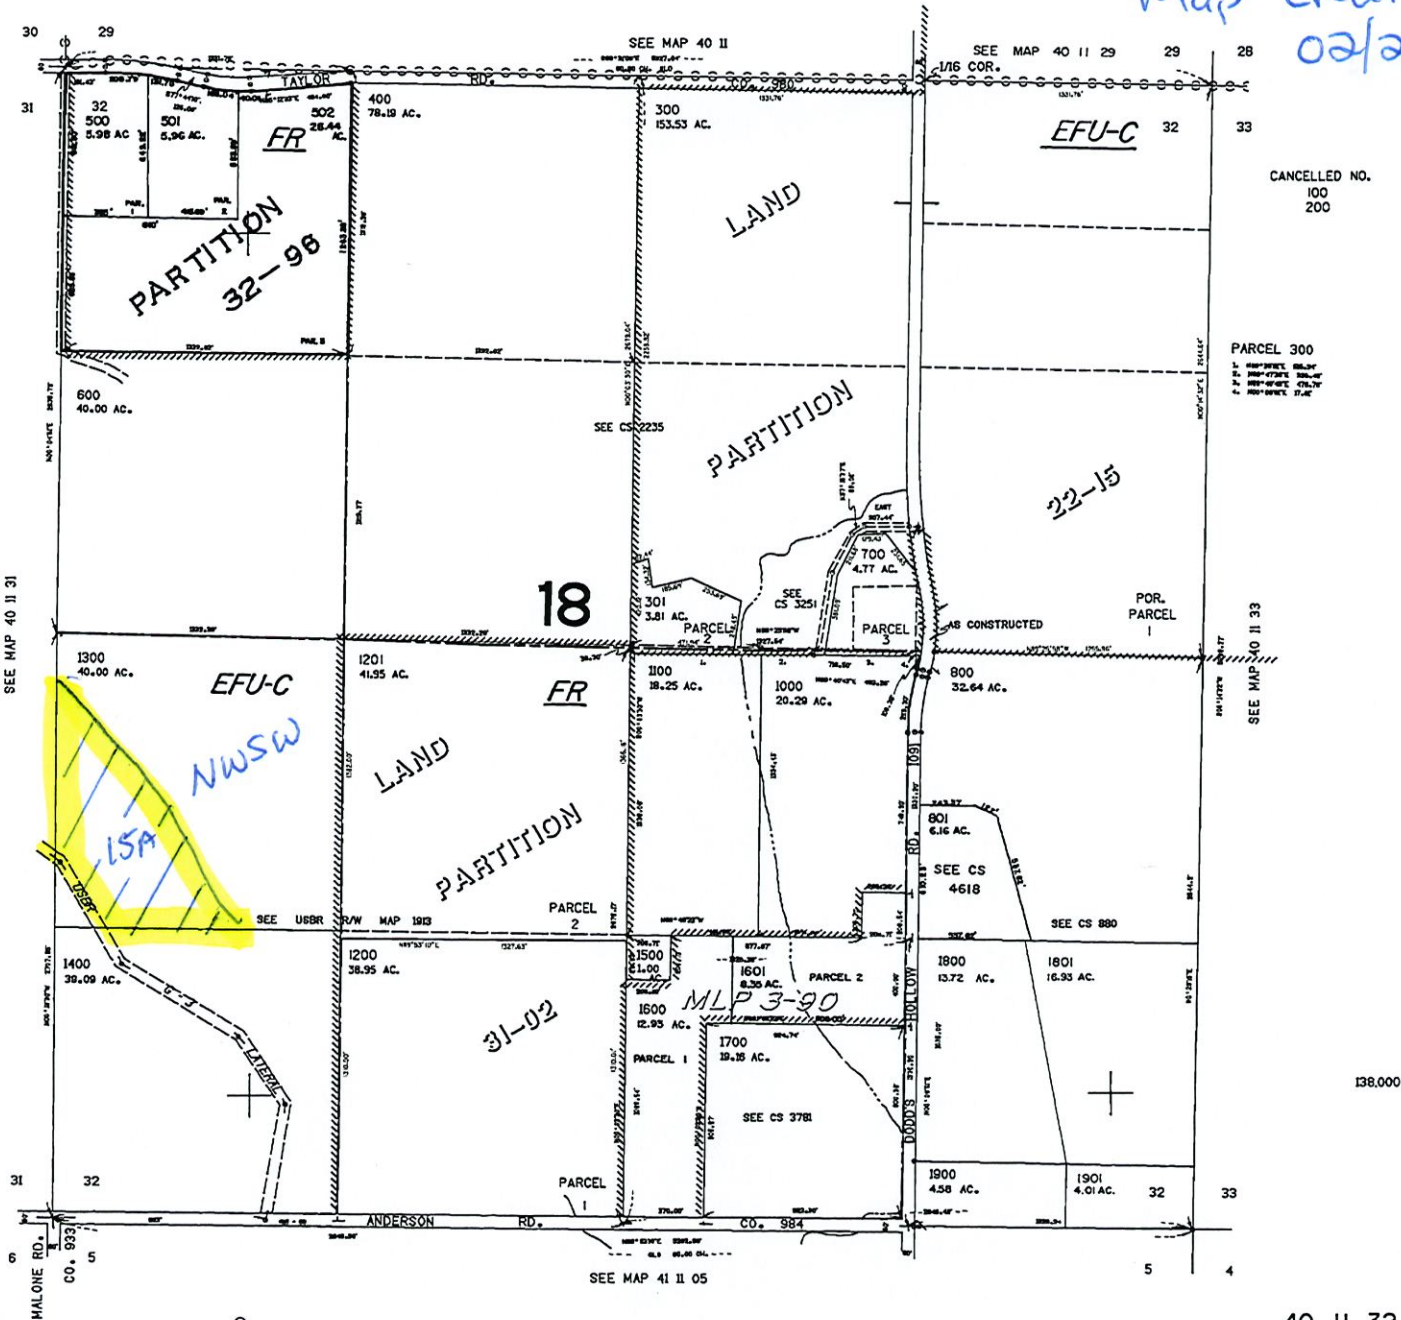

40 11 32

Map of

41 10 01  
& INDEX  
MERRILL

Map created  
02/23/2021


REVISED 09-24-14  
THIS MAP WAS PREPARED FOR  
ASSESSMENT PURPOSE ONLY

SECTION 01 T.41S. R.10E. W.M.  
KLAMATH COUNTY  
1"=400'

RECEIVED  
APR 01 2021  
OWRD  
NORTH

T41S R10E  
SEC. 01  
Tax lot  
200 NENW 40.00  
NWNW 34.00

Scale  
1"=880'

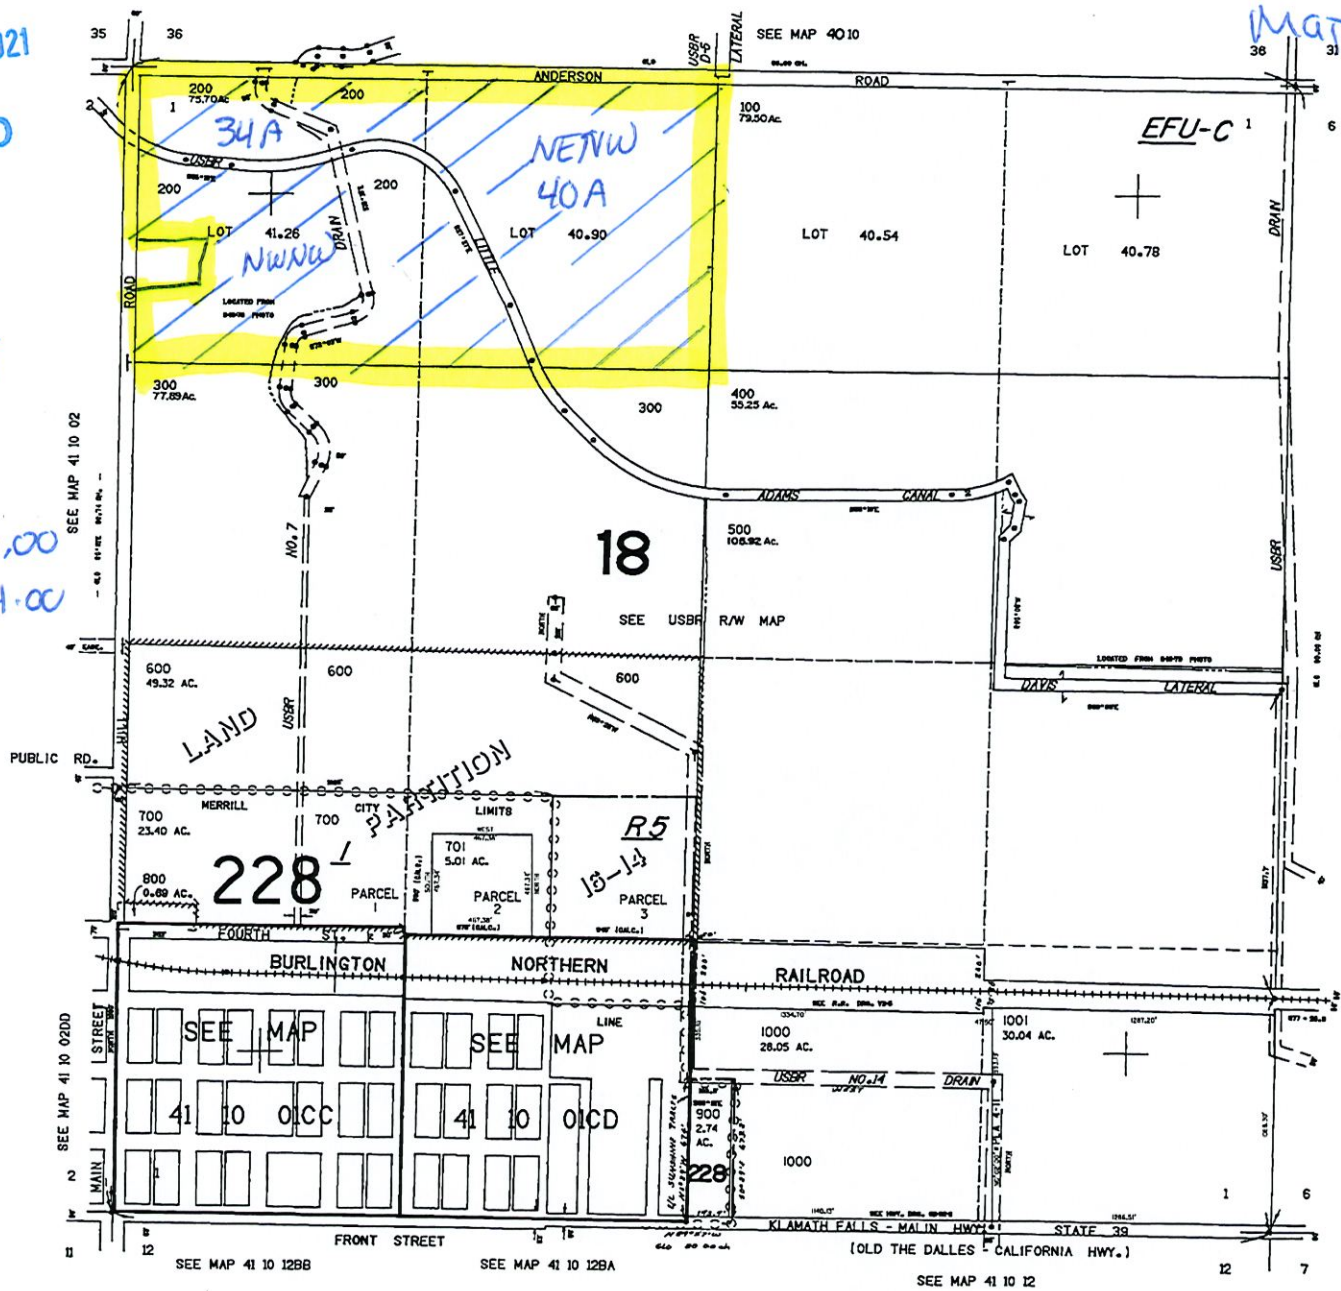

SEE MAP 41 11 06

133.000

41 10 01  
& INDEX  
MERRILL

02.000



Map of

41 11 01

Map created 02/23/2021

REVISED 05-17-2016  
THIS MAP WAS PREPARED FOR  
ASSESSMENT PURPOSE ONLY

SECTION 01 T.41S. R.11E. W.M.  
KLAMATH COUNTY  
1"=400'

RECEIVED  
APR 01 2021  
OWRD


NORTH

THIS R1E  
SEC. 01

Tax lot

800 NENW	30.00
NWNW	8.00
SWNW	10.00
SESW	36.00
NESW	38.00
NWSW	3.00

Scale  
1" = 880'

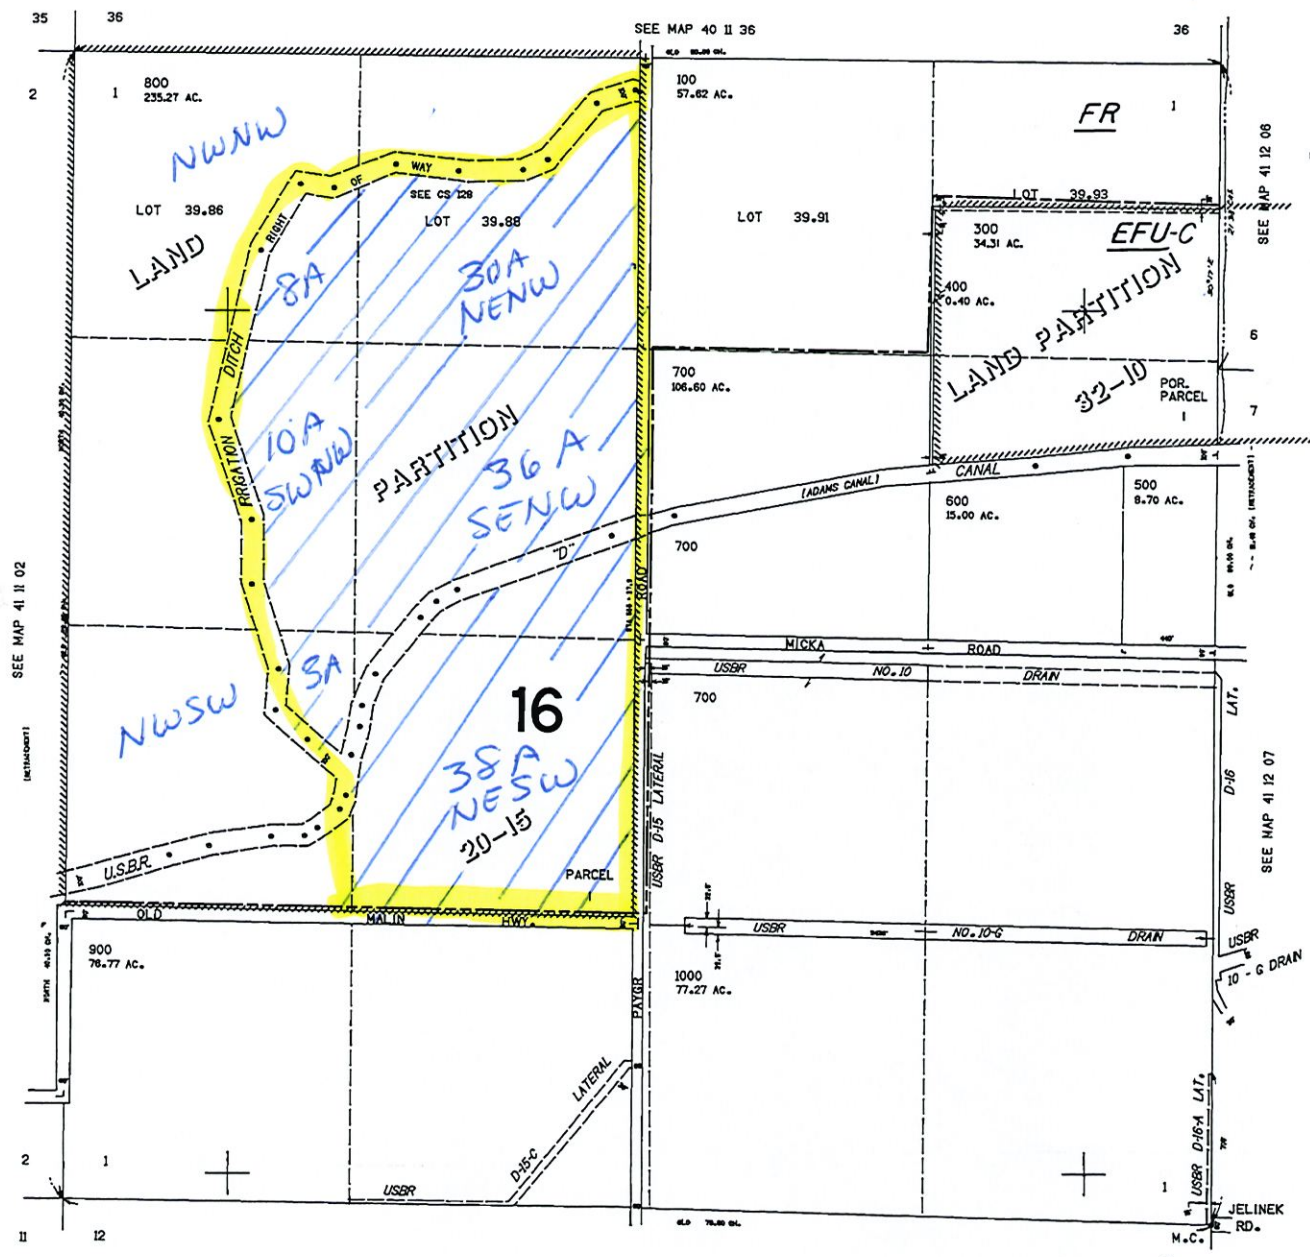

CANCELLED NO.  
200

132,000

41 11 01

11

12

SEE MAP 41 11 12

12

JELINEK RD.  
M.C.

SEE MAP 41 12 06

6

7

SEE MAP 41 12 07






SEE MAP 41 11 02

(WITHIN)

SEE MAP 41 11 02

2

1

1

1

.734,000

Map of.


41 II 10

Map created 02/23/2001

REVISED 06-06-14  
THIS MAP WAS PREPARED FOR ASSESSMENT PURPOSE ONLY

SECTION 10 T.41S. R.11E. W.M.  
KLAMATH COUNTY

1"=400'  
SEE MAP 41 II 03

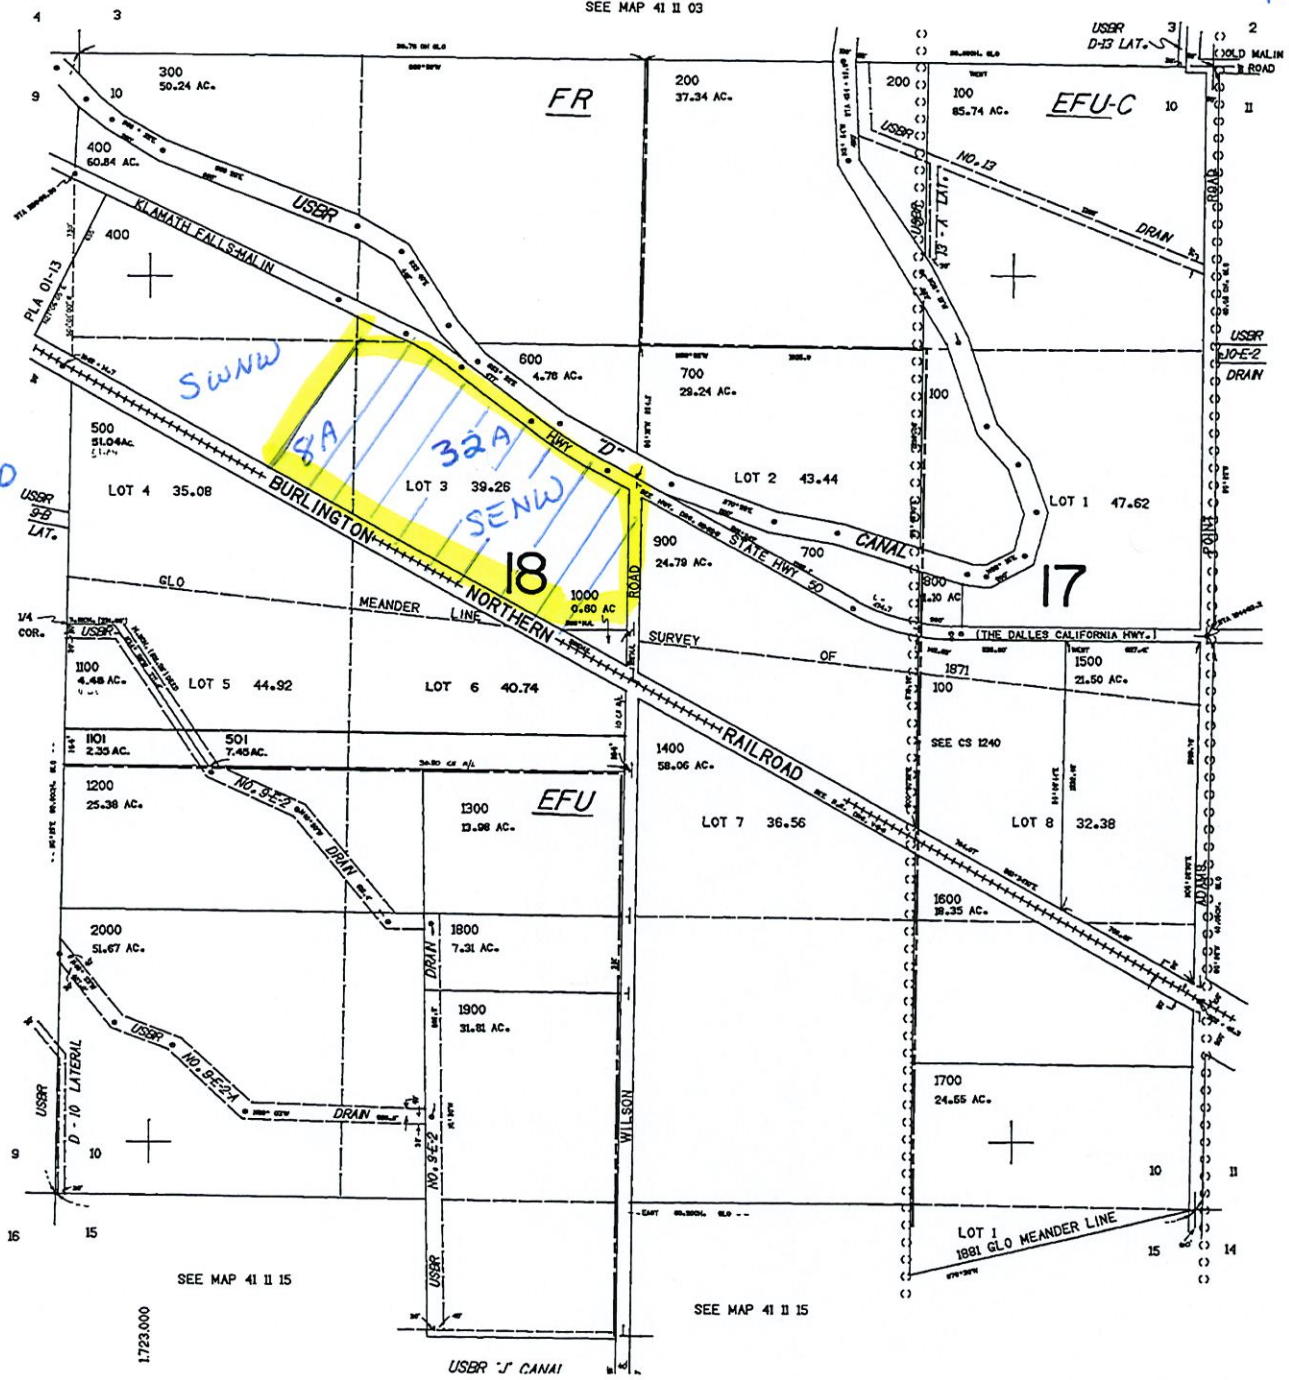

RECEIVED

APR 01 2021

OWRD

NORTH

THIS R11E  
SEC. 10

Tax lot  
400 SWNW 8.00  
SEnw 32.00

Scale  
1" = 880'

SEE MAP 41 II II

127,000

41 II 10



Map of

41 11 12

Map created 02/23/2021

SECTION 12 T.41S. R.11E. W.M.  
KLAMATH COUNTY

1"=400'

THIS MAP WAS PREPARED FOR ASSESSMENT PURPOSE ONLY.

RECEIVED

APR 01 2021

OWRD

NORTH

T41S R11E  
SEC. 12


Tax lot

1100 NESW 8.09  
NWSW 8.81

1500 SESW 39.95  
SWSW 40.00

Scale

1" = 880'

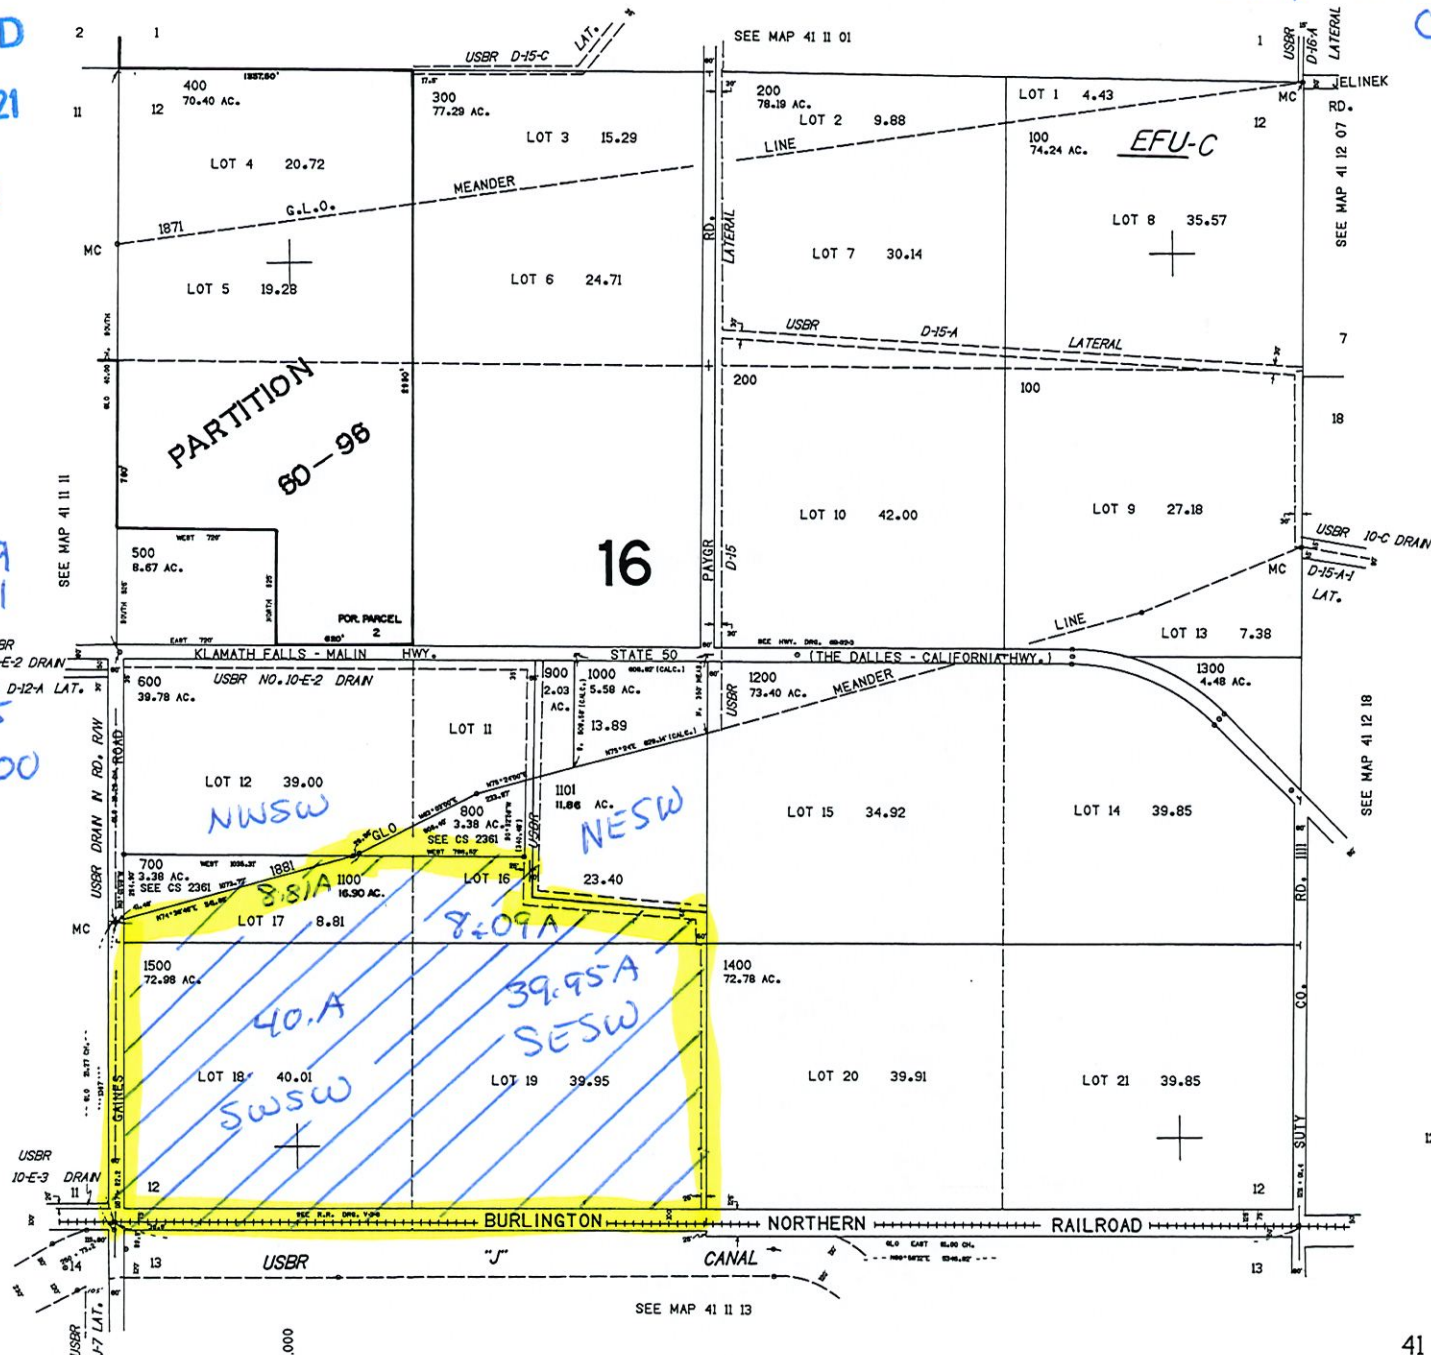

127,000

41 11 12