


Map 2 of 2

REVISED
1-29-09
THIS MAP WAS PREPARED FOR
ASSESSMENT PURPOSE ONLY

SECTION 13 T.40S. R.09E. W.M.
KLAMATH COUNTY

40 09 13

1"=400'

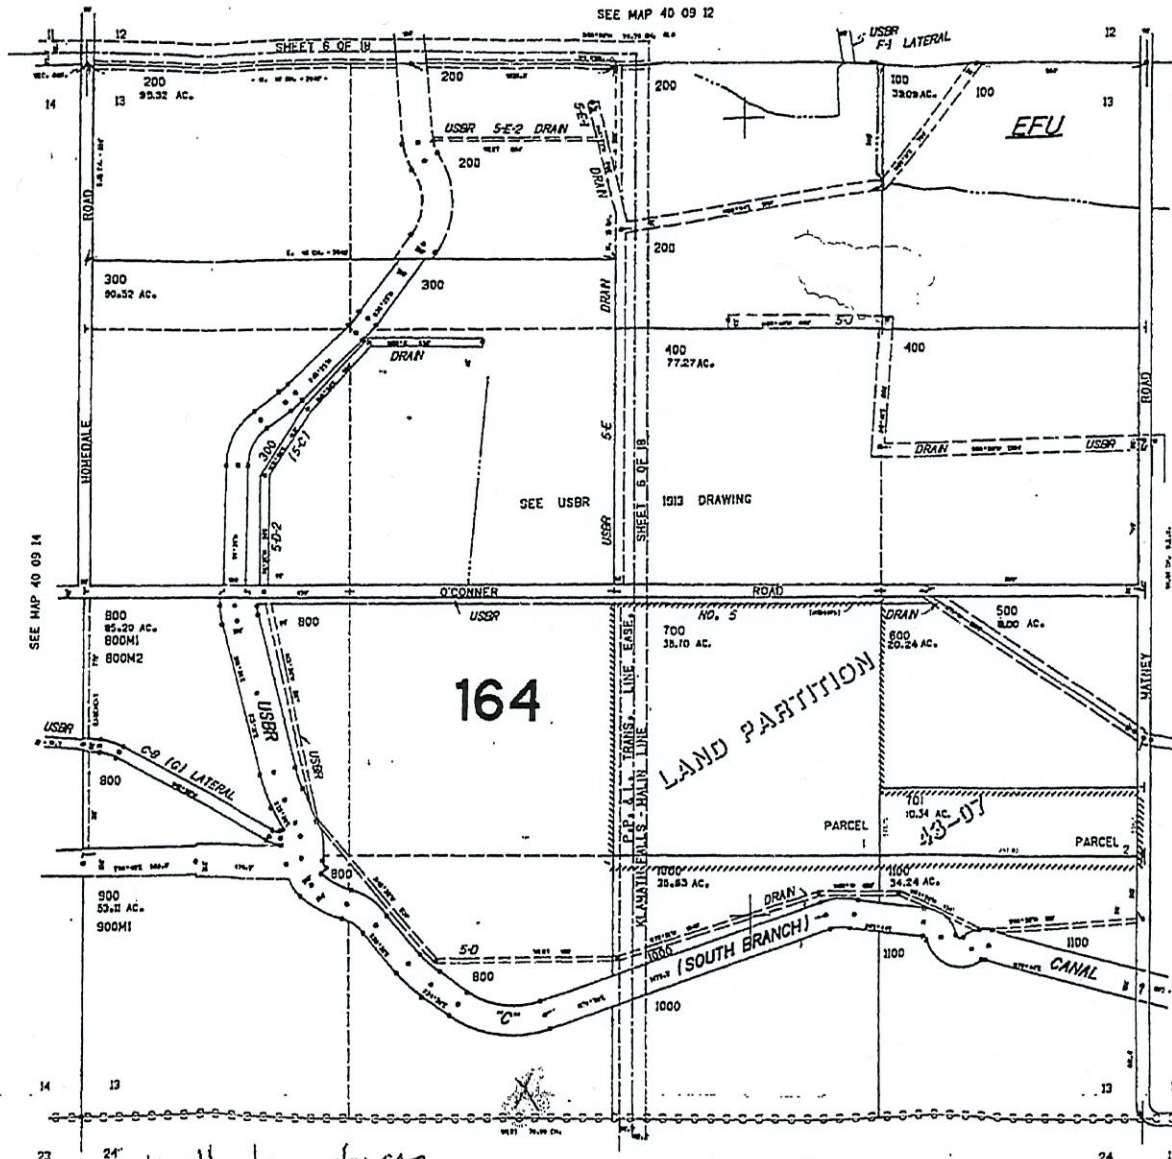

NORTH

T40S R9E
SEC 13

Scale

1" = 880'

Well location
Off NORTH

+ 2315' EAST FROM SW CORNER
Sec 13

RECEIVED
APR 13 2020
OWRD

RECEIVED
APR 05 2021
OWRD

40 09 13

1886000

REVISED 11-28-07

THIS MAP WAS PREPARED FOR ASSESSMENT PURPOSE ONLY

SECTION 12 T.40S. R.09E. W.M. KLAMATH COUNTY

1"=400'

MAP 2 OF 2

MAP CREATED 3-18-2021

NORTH


T40S R09E
SEC 12
Tax lot
1500 SWSE 26.00

RECEIVED

APR 05 2021

OWRD

Scale
1" = 880'

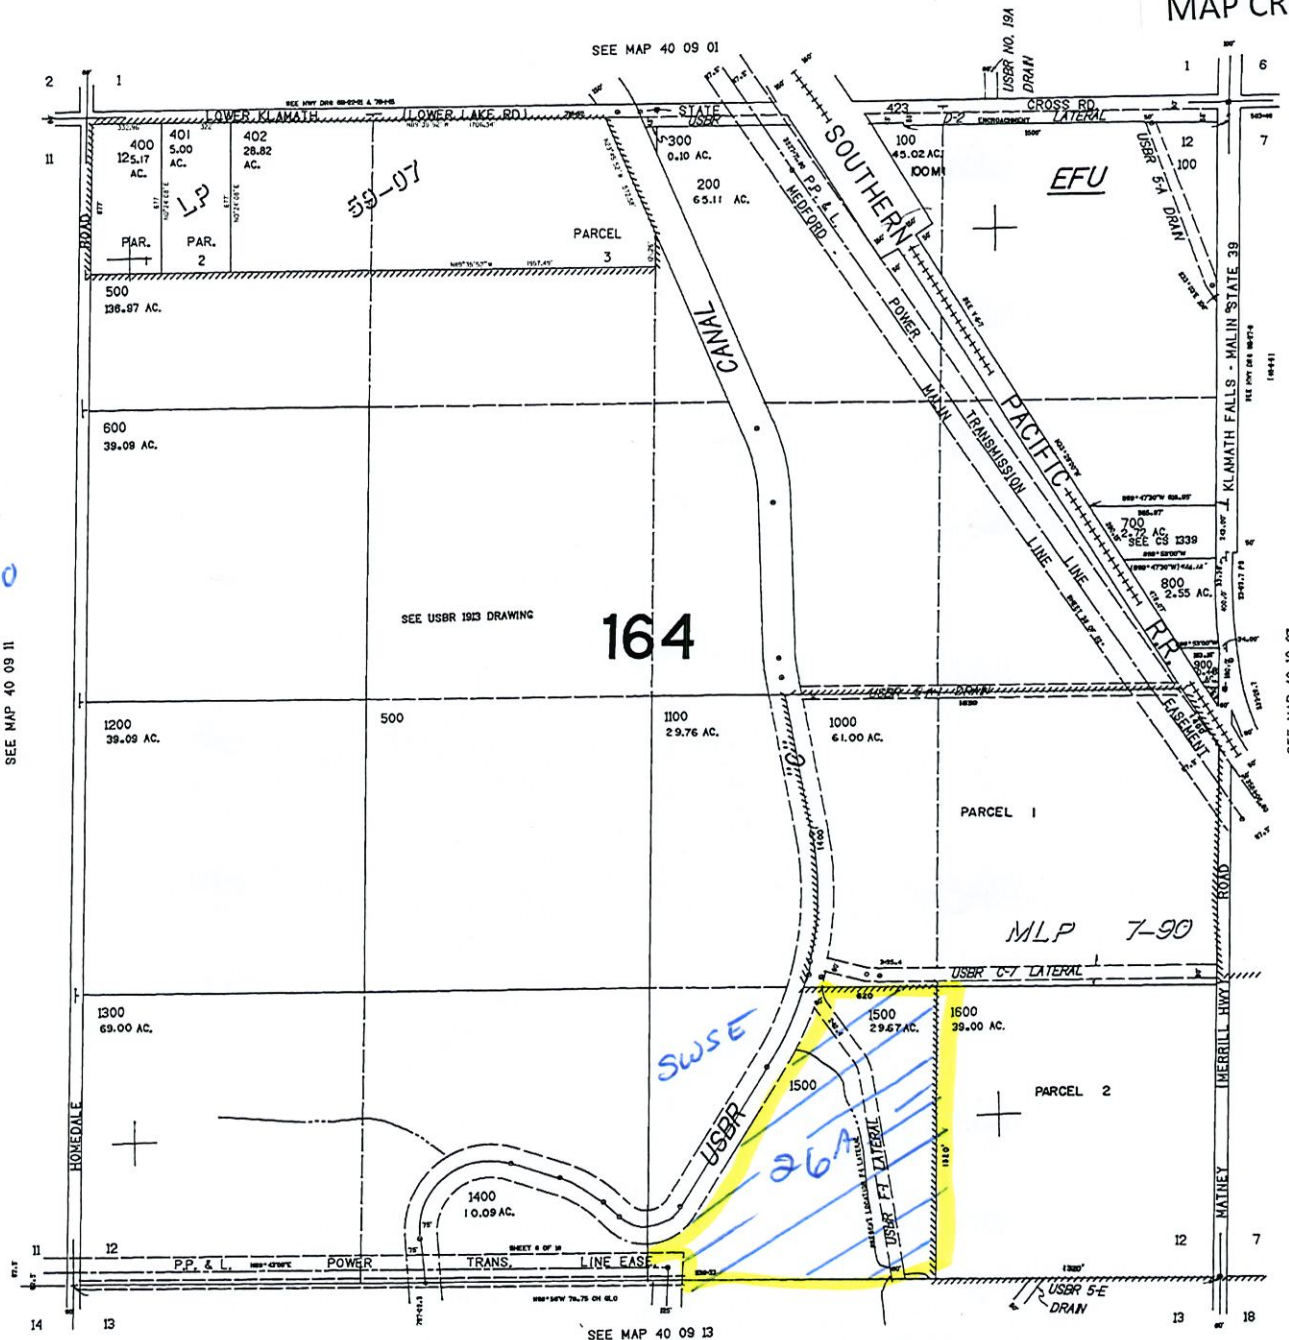

164

SWSE

26A

40 09 12

1:4,000