

1
NORTH

THIS R11E
SEC 2

RECEIVED
APR 05 2021
OWRD

Well Location
KLAM 56425


42.0292
-121.5016

17

THIS MAP WAS PREPARED FOR
ASSESSMENT PURPOSE ONLY.

SECTION 02 T.41S. R.11E. W.M.
KLAMATH COUNTY
1"=400'

MAP 1 OF 2
MAP CREATED 03/31/20

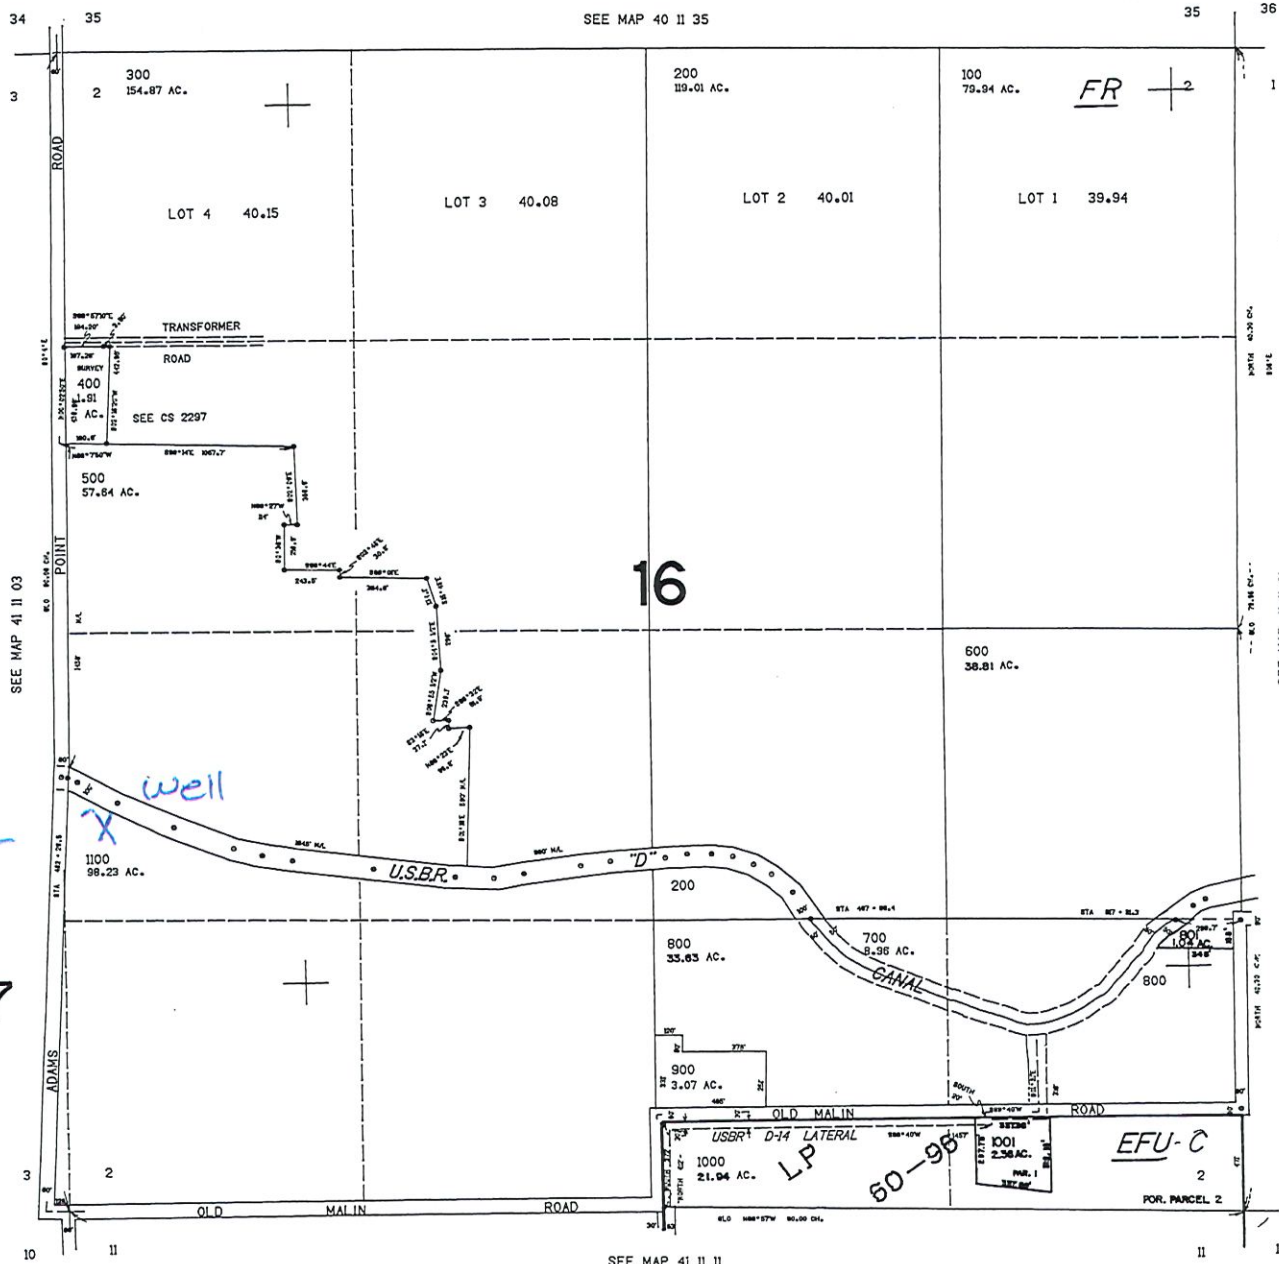

CANCELLED NOS
601

THIS MAP WAS PREPARED FOR ASSESSMENT PURPOSE ONLY.


SECTION 11 T.41S. R.11E. W.M.
KLAMATH COUNTY

1"=400'

MAP 2 OF 2

MAP CREATED 03/31/2021

NORTH
T41S R11E
SEC 11
Tax lot
300 - SWNE 39.00
SENE 39.00
RECEIVED
APR 05 2021
OWRD

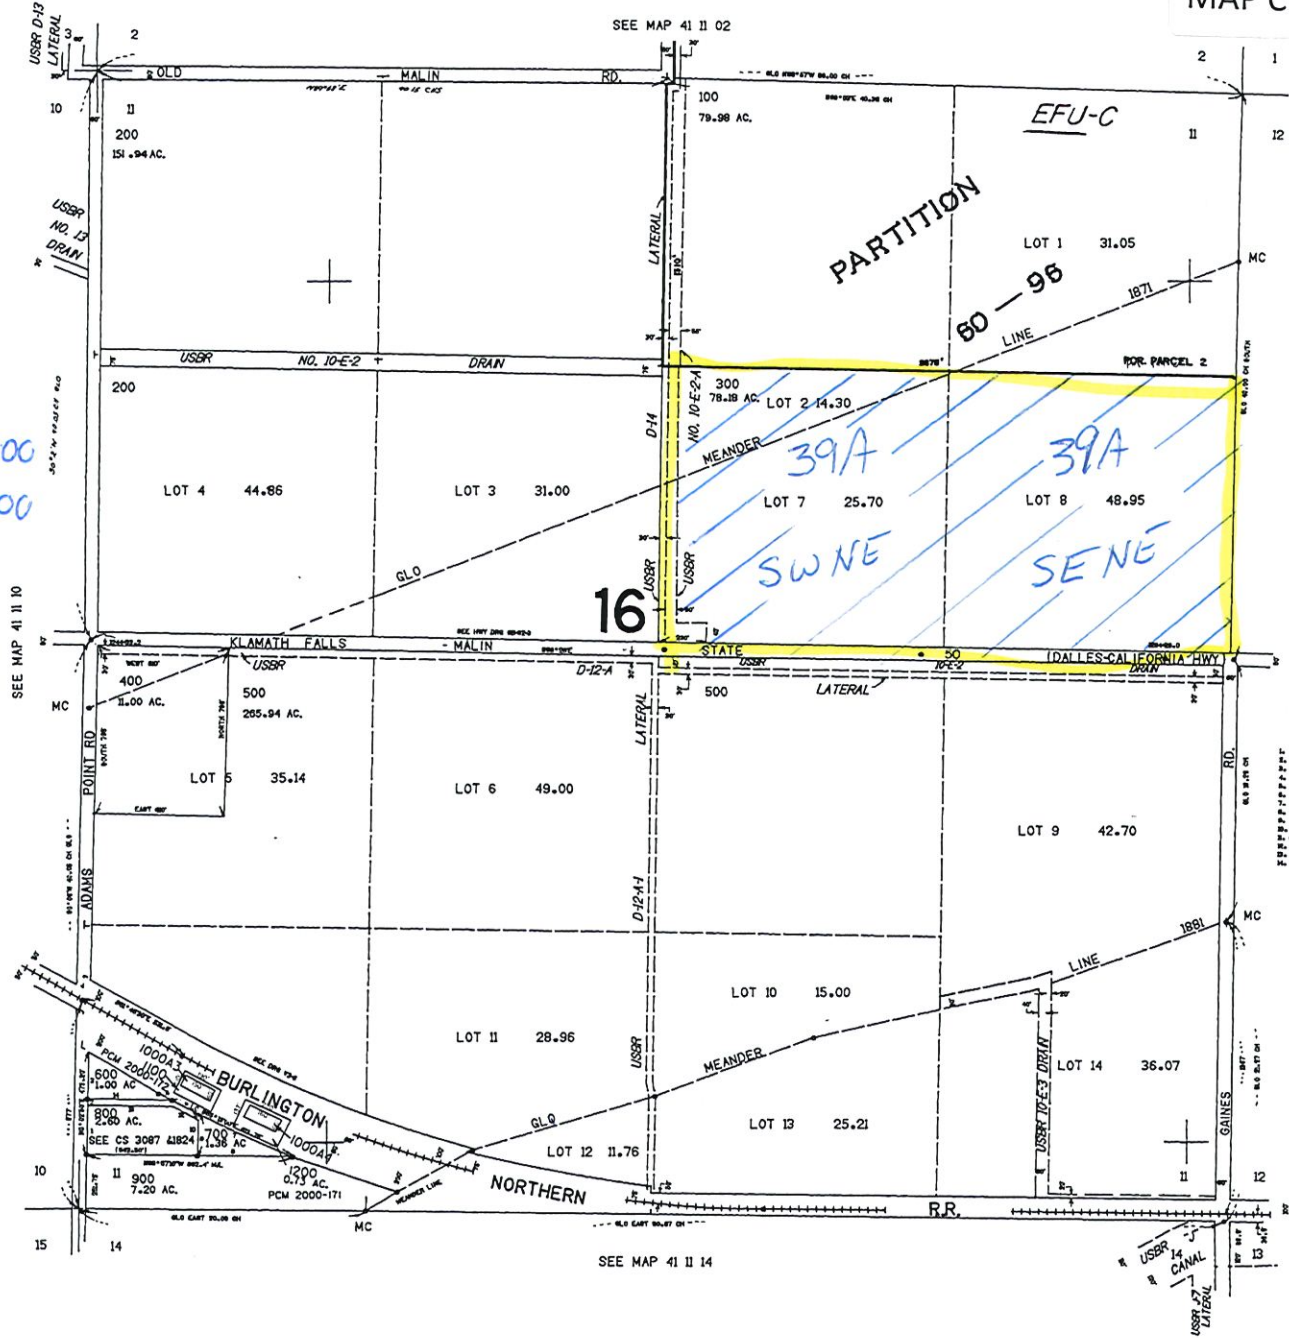

- 1. 10'-0\"/>

Scale
1" = 880'