

# Memorandum

## Oregon Water Resources Department Water Rights Service Division

To: Application G-19085

From: Alyssa Mucken

Subject: April 12, 2021

Date: Application Map (measured distances for 3 proposed wells)

---

I spoke with the applicant, Cory Turner, this afternoon. Cory confirmed that the wells proposed under this application are the same 3 wells used under the drought permit from 2020 (KLAM 57403, KLAM 57371, KLAM 52706)

With the applicant's permission, the application maps used for last year's drought permit (G-18421) have been added to the application file, and include a measured distance for all three wells.

Turner

RECEIVED

APR 07 2021

OWRD

MAP 1 OF 9

MAP CREATED 02/05/2021


41 11 03

Map created 02/05/2021

THIS MAP WAS PREPARED FOR ASSESSMENT PURPOSE ONLY.

SECTION 03 T.41S. R.11E. W.M. KLAMATH COUNTY T=400'

North

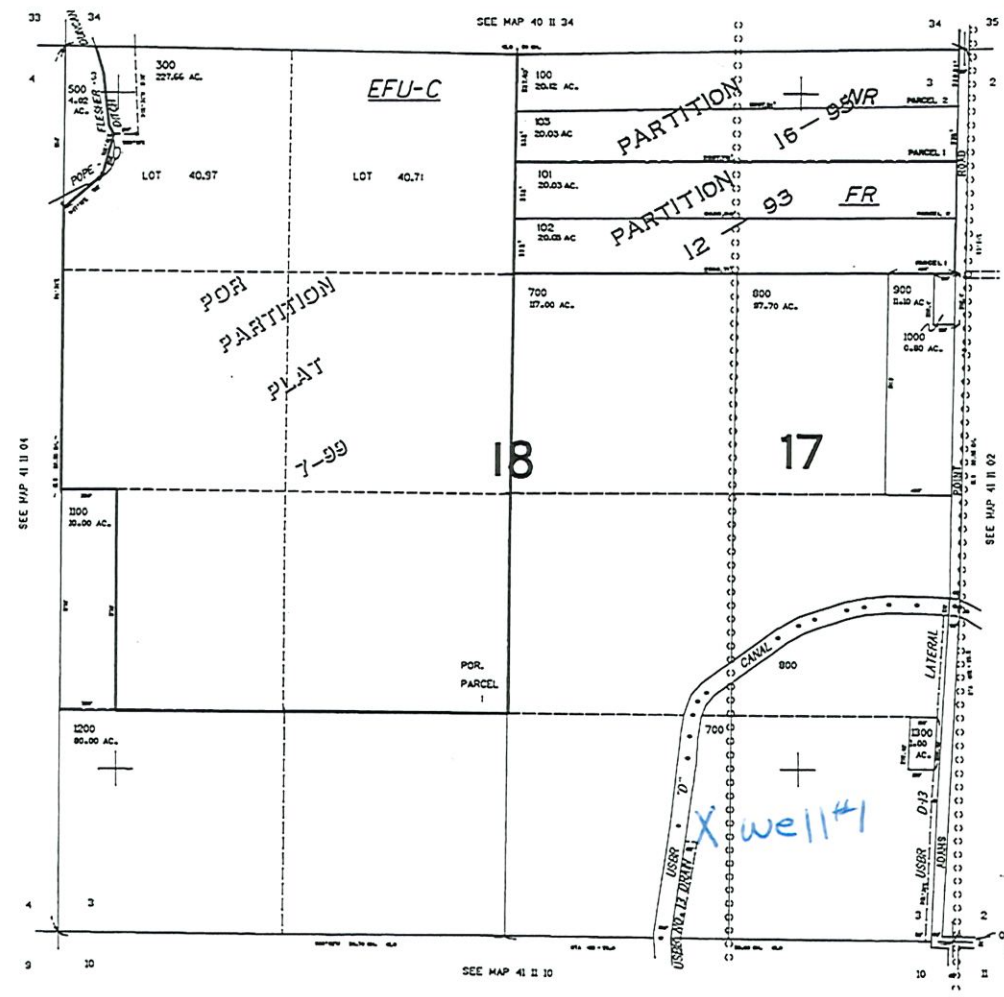

CANCELLED NO. 300 400 600

#1  
Well location  
 22,000 Klam 57403  
42.0258  
 -121.5080

Scale 1"=880'

41 11 03

1723.000

MAP # 1A

to show well Location only

T41S R11E

SEC 03

TL 700  
800

NORTH ↑

1" = 400'

SCALE

G. Lion

RECEIVED


APR 02 2020

OWRD

SECTION 03 T.41S. R.11E. WM.  
KLAMATH COUNTY

41 11 03

THIS MAP WAS PREPARED FOR  
ASSESSMENT PURPOSE ONLY

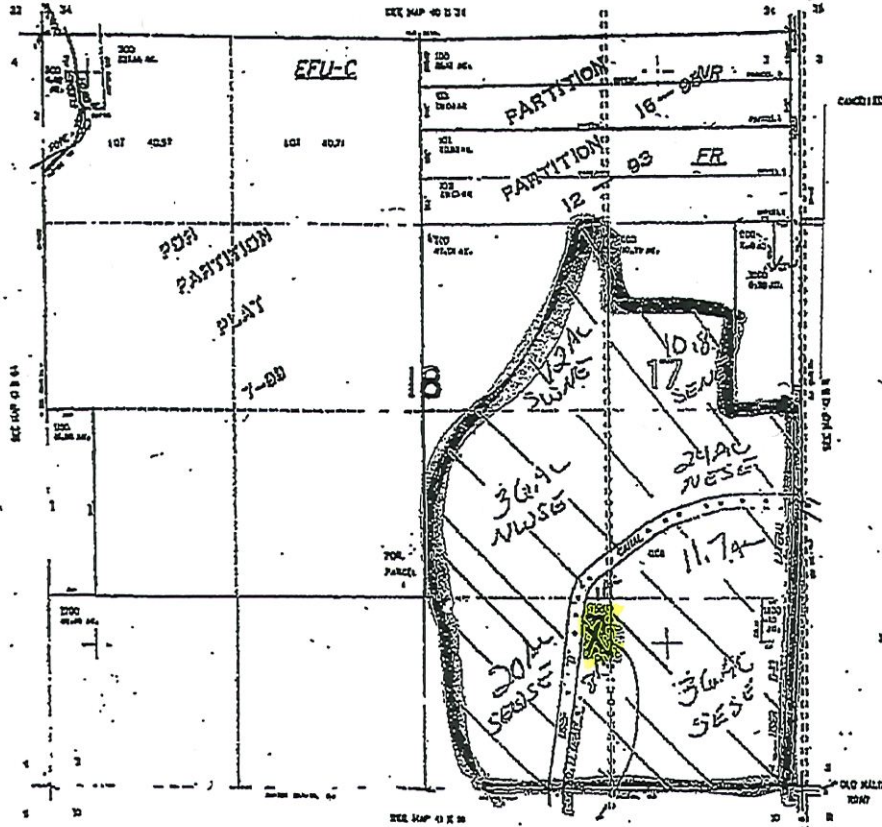

RECEIVED

APR 12 2021

OWRD

1100' North  
1380' West  
SE corner  
Sec. 3

well #1

41 11 03

Turner, Cora

REVISED 05-17-2016  
THIS MAP WAS PREPARED FOR  
ASSESSMENT PURPOSE ONLY

SECTION 01 T.41S. R.11E. W.M.  
KLAMATH COUNTY

MAP 2 OF 9


RECEIVED

APR 07 2021

OWRD

MAP CREATED 02/05/2021

NORTH  
THIS R11E  
SEC 01

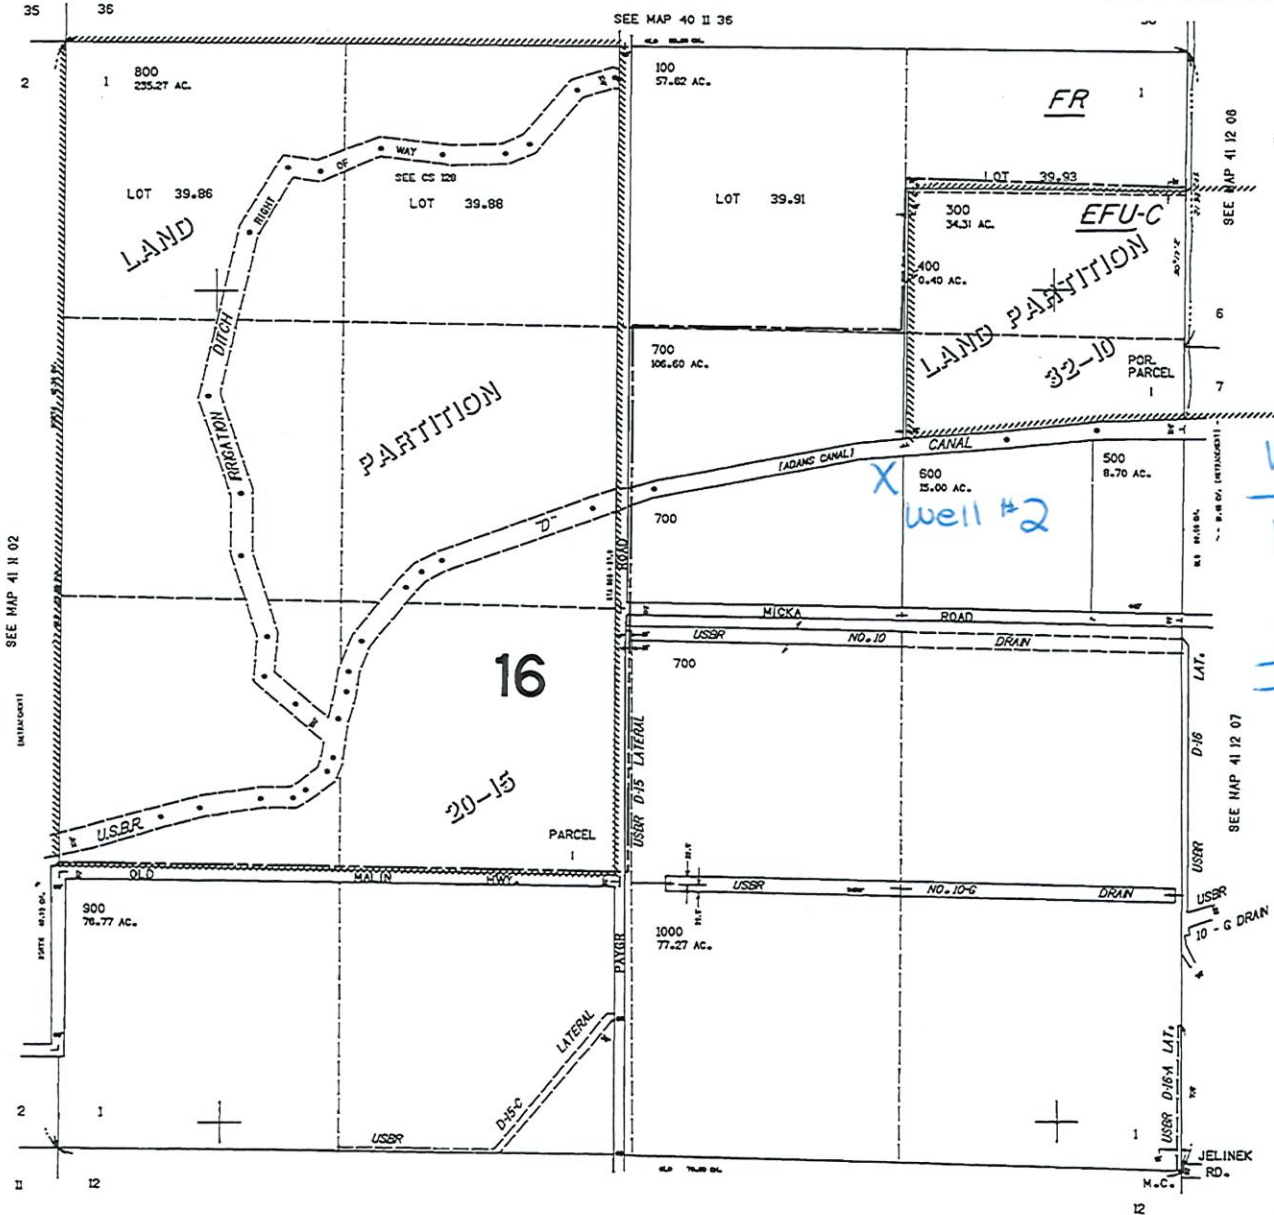

CANCELLED NO.  
200

Well #2 location  
Klam 57371  
42.0330  
-121.4683

Scale  
1" = 880'

.734,000

SEE MAP 41 II 12

41 II 01



RECEIVED

APR 02 2020

OWRD

41 11 01

CANCELLED NO. 200

41 11 01

41 11 01


MAP # 2A  
to show well  
location only

REVISED 05-17-2016  
THIS MAP WAS PREPARED FOR  
ASSESSMENT PURPOSE ONLY

SECTION 01 T.41S. R.11E. W.M.  
KLAMATH COUNTY  
T-400

NORTH  
T41S R11E  
Sec 1  
TL 600

Scale  
1" = 400'

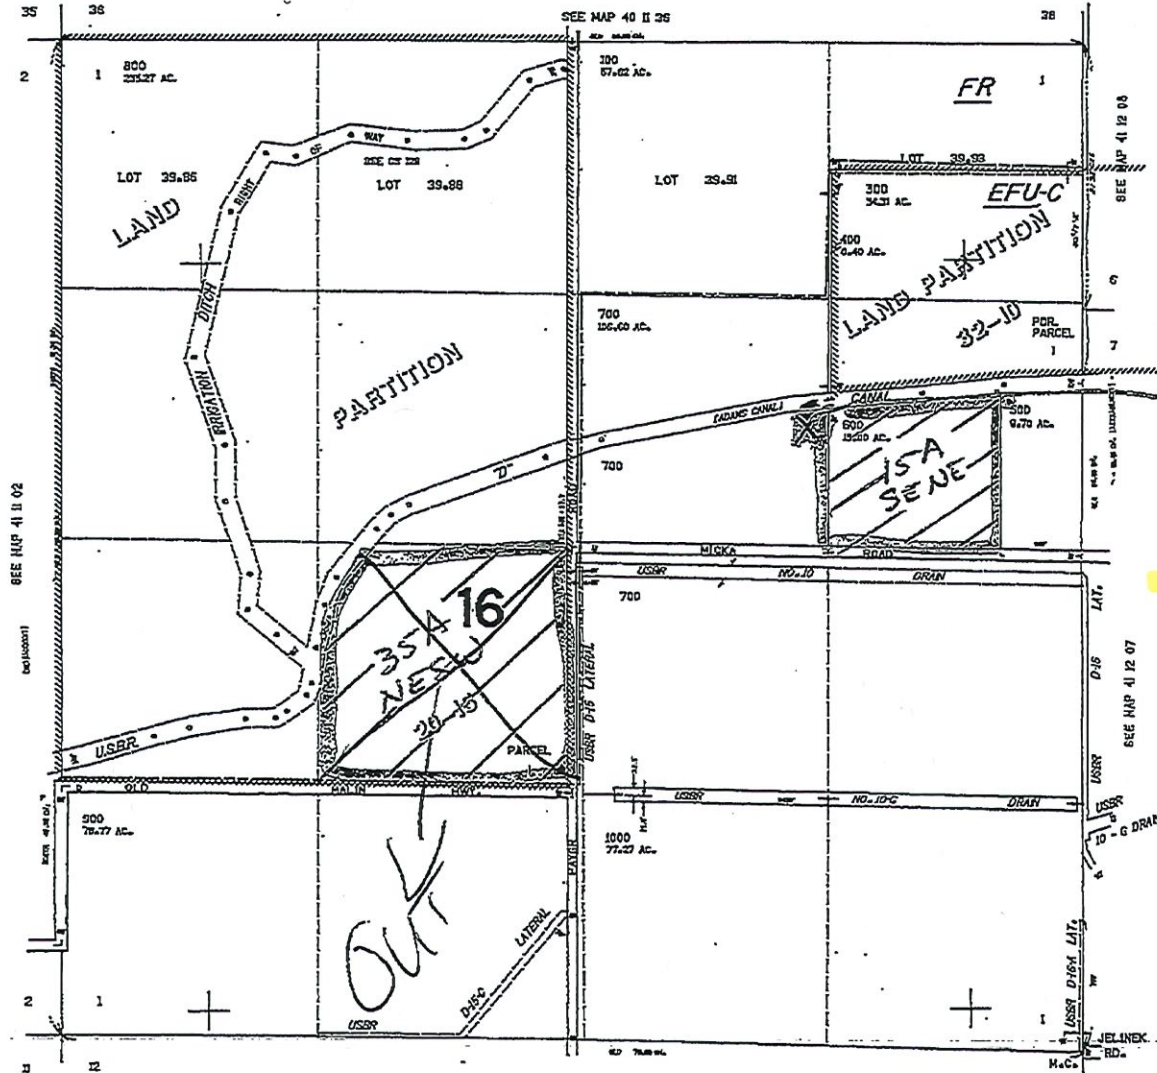

Well #2  
600' N  
of 1250' E  
FROM C1/4  
CORNER Sec #1

OUT

734000

SEE MAP 41 11 12

Turner

REVISED 4-7-11  
THIS MAP WAS PREPARED FOR  
ASSESSMENT PURPOSE ONLY

SECTION 06 T.41S. R.12E. W.M.  
KLAMATH COUNTY  
1"=400'

MAP 3 OF 9

MAP CREATED 02/05/2021


RECEIVED

APR 07 2021

OWRD

North  
THIS R12E  
SEC. 6

CANCELLED NO.  
1200  
1300

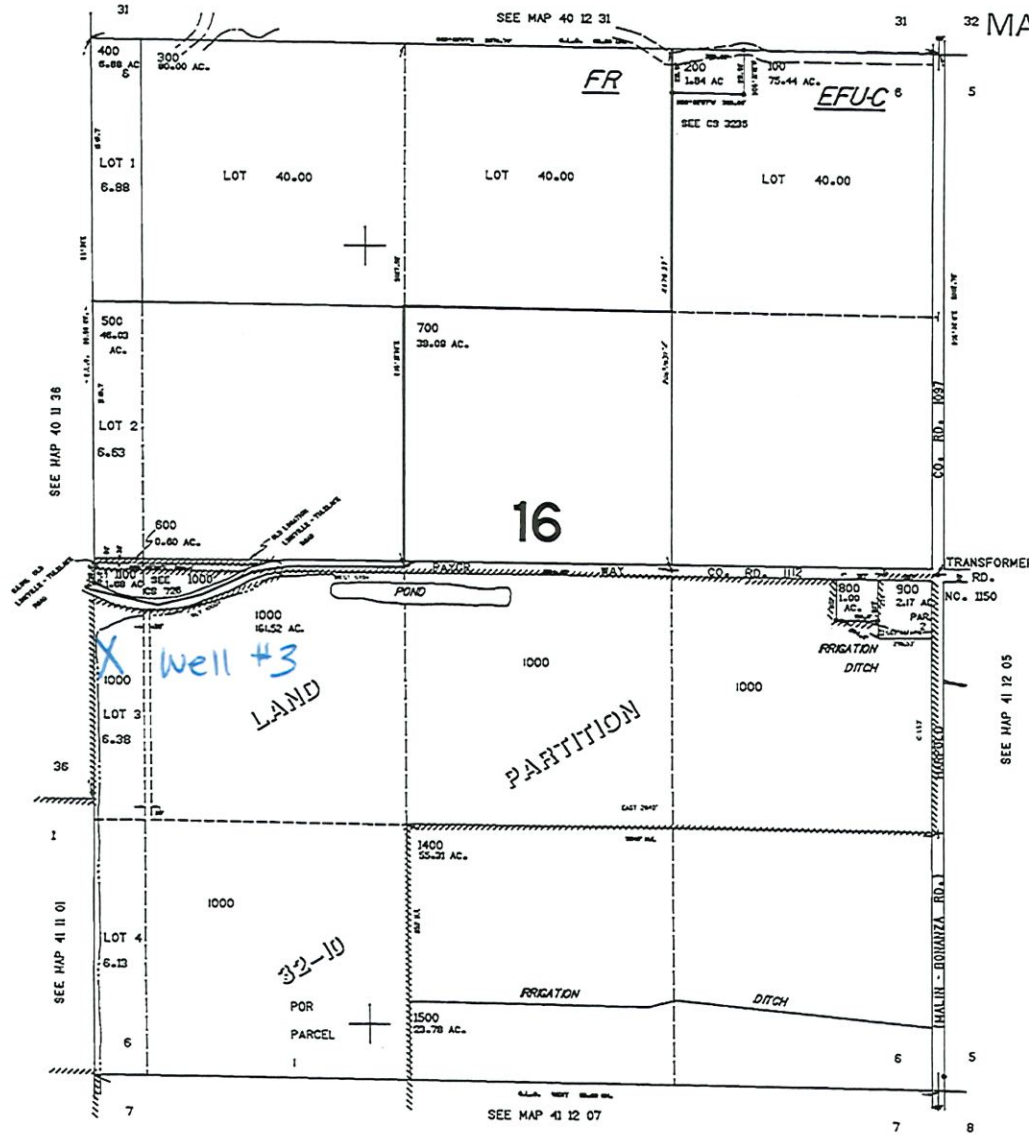

Well #3  
Well location  
Klam 52706  
42.0410  
-121.4631

Well #3  
LAND

40,000

138,000  
41 12 06

MAP # 3A

to show well location only

REVISED 4-7-11  
THIS MAP WAS PREPARED FOR  
ASSESSMENT PURPOSE ONLY

SECTION 06 T.41S. R.12E. W.M.  
KLAMATH COUNTY  
T-400'

RECEIVED  
APR 02 2020  
OWRD

RECEIVED


APR 12 2021

41 12 06 OWRD

NORTH  
T41 S, R12E Sec 6

Well # 3  
128' S +  
1228' West  
of C'4 Sec 6

Scale  
1" = 400'

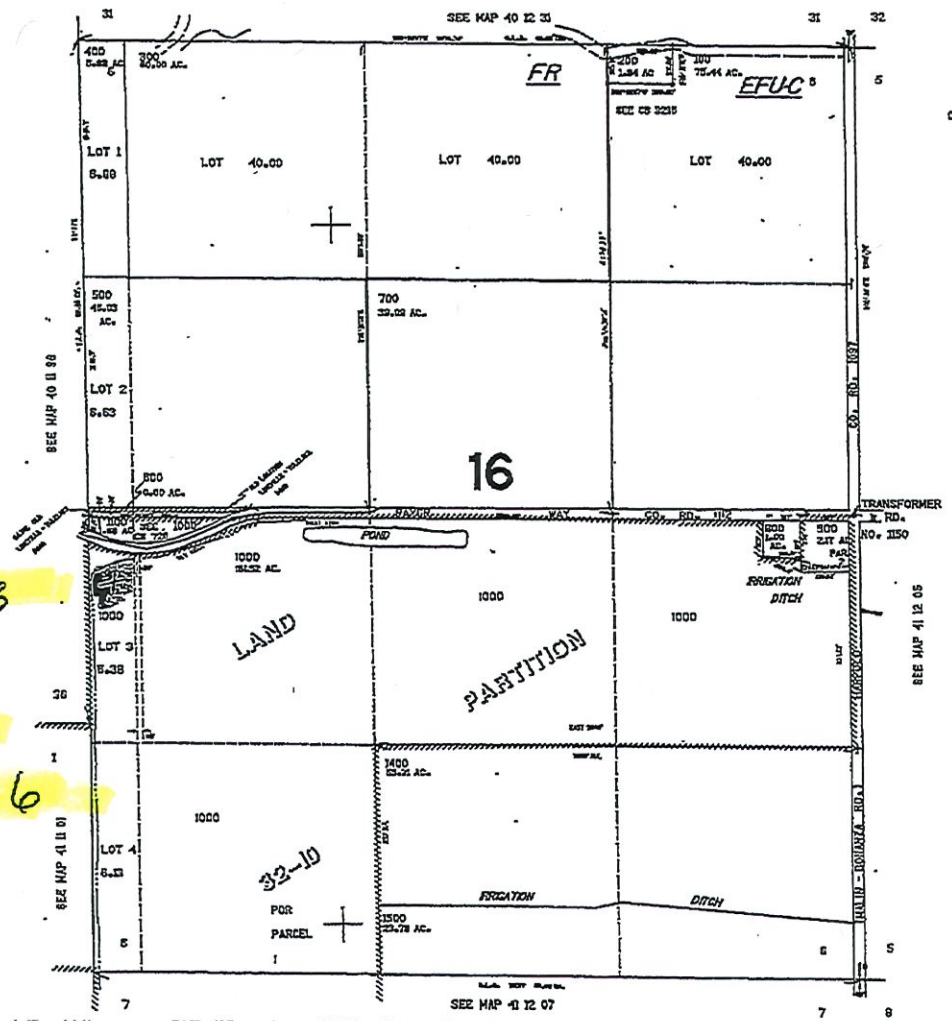

CANCELLED NO.  
1200  
1300

41 12 06



REVISED 05-17-2016  
THIS MAP WAS PREPARED FOR  
ASSESSMENT PURPOSE ONLY


SECTION 01 T.41S. R.11E. W.M.  
KLAMATH COUNTY

1"=400'

MAP 4 OF 9

MAP CREATED 04/01/2021

RECEIVED  
APR 07 2021  
OWRD  
NORTH  
T41S R11E  
SEC 01  
Tax lot  
600 SENE 15.00

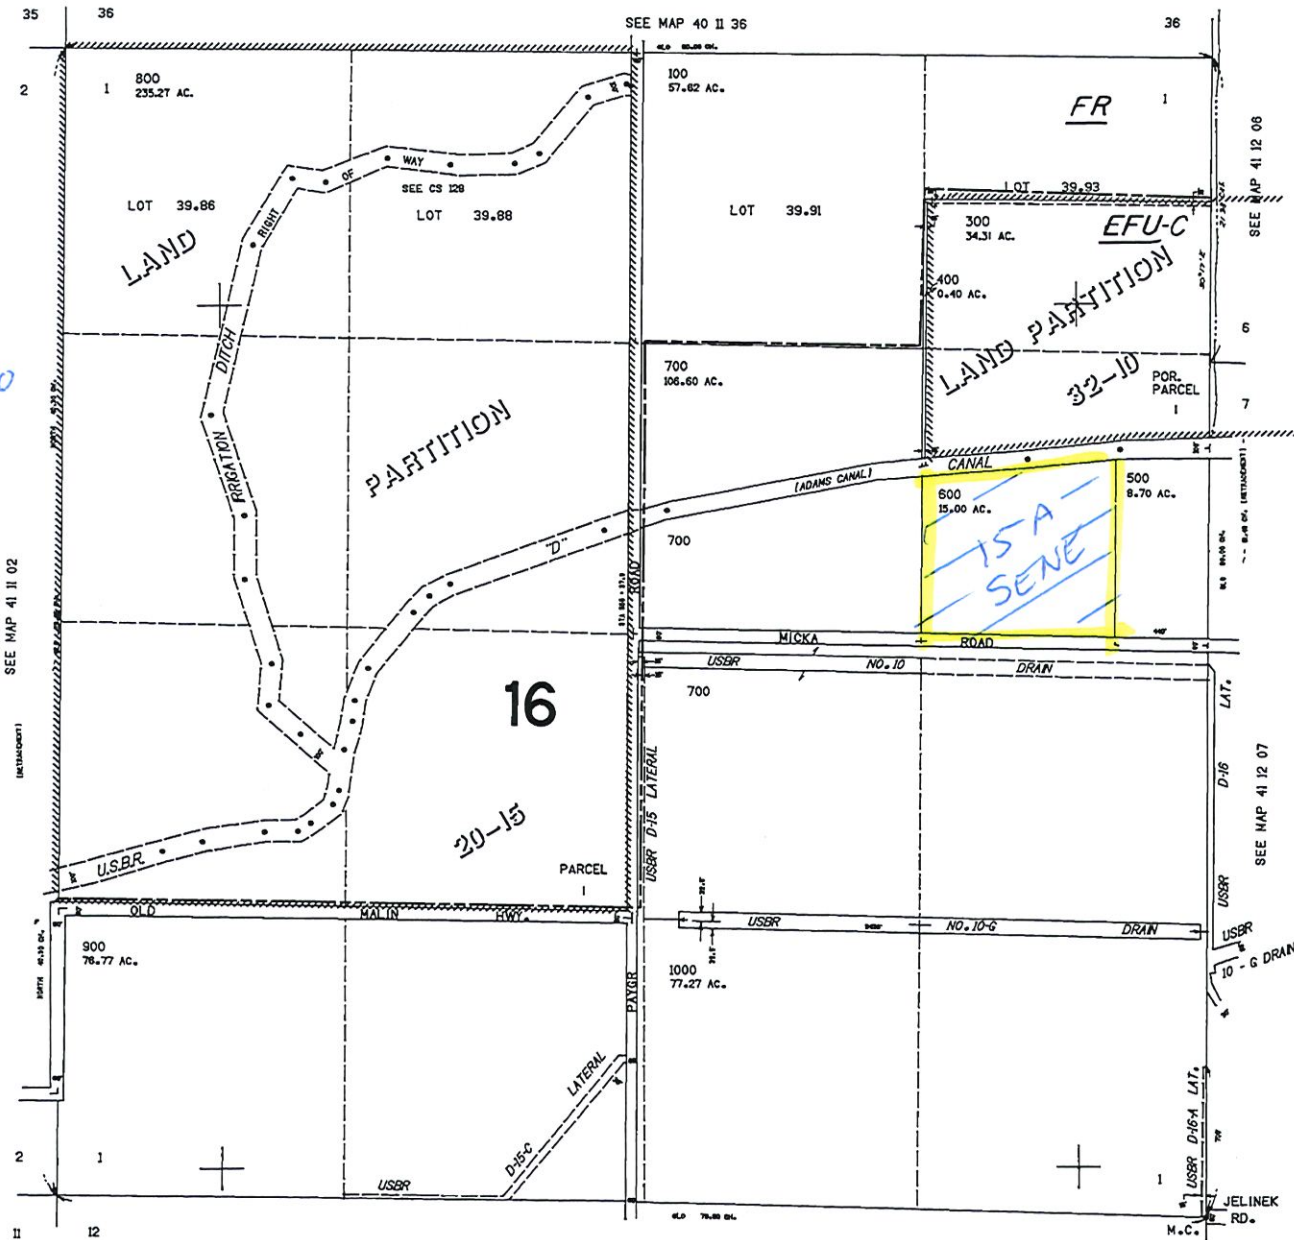

CANCELLED NO.  
200

Scale  
1" = 880'

.734,000

SEE MAP 41 12 12

132,000

41 11 01




RECEIVED  
APR 07 2021

OWRD

THIS MAP WAS PREPARED FOR  
ASSESSMENT PURPOSE ONLY

SECTION 03 T.41S. R.11E. W.M.  
KLAMATH COUNTY

1"=400'

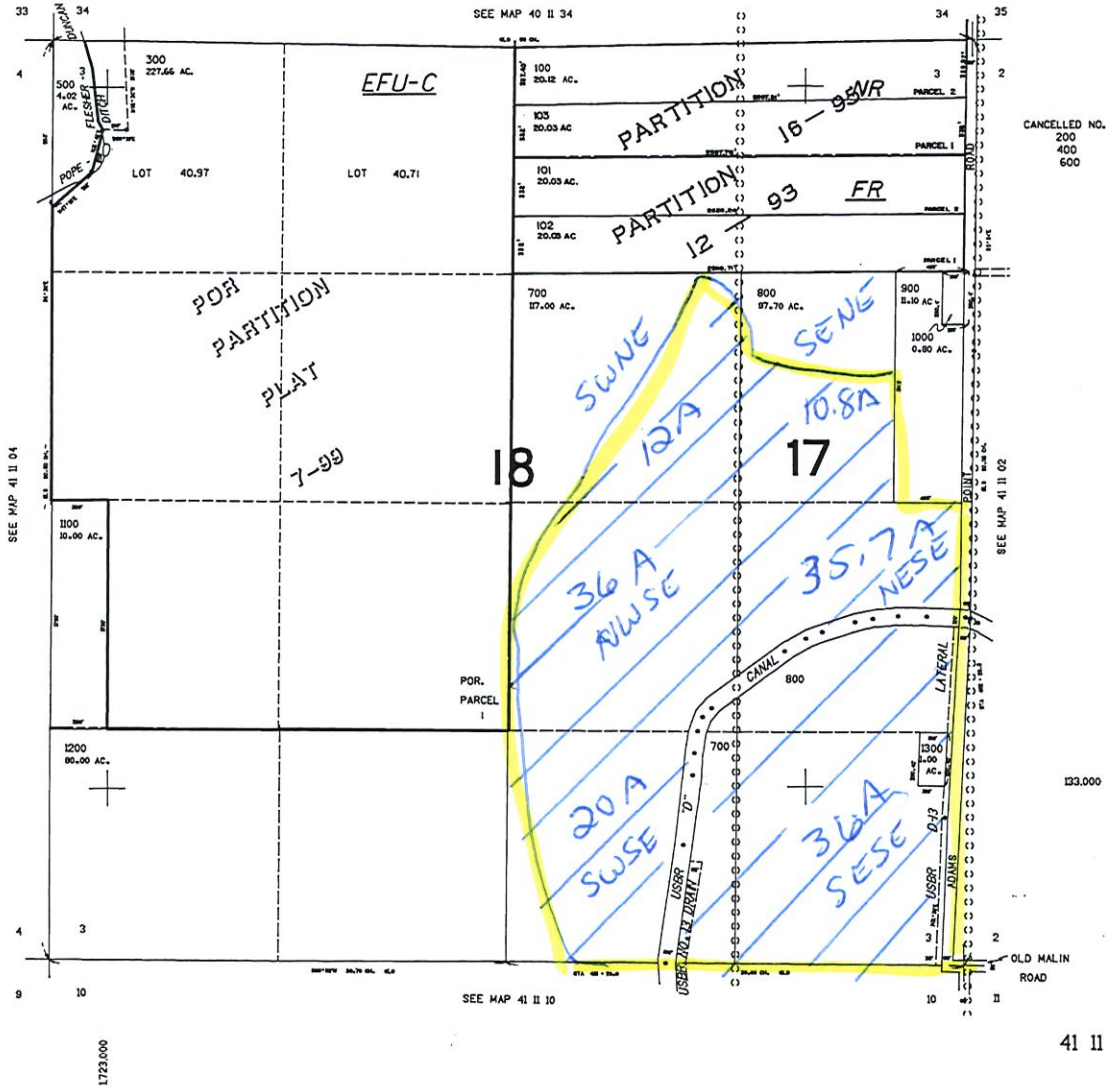

NORTH  
T41S R11E  
SEC.03

Tax lot

700	SWNE	12.00
	NWSE	36.00
	SWSE	20.00
800	SENE	10.80
	NESE	35.7
	SESE	36.00

Scale

1" = 880'

REVISED 4-8-11

THIS MAP WAS PREPARED FOR ASSESSMENT PURPOSE ONLY

SECTION 07 T.41S. R.12E. W.M. KLAMATH COUNTY

T=400'

MAP 6 OF 9

MAP CREATED 04/01/2021

RECEIVED


APR 07 2021

OWRD

NORTH

T41S R12E  
SEC. 07  
Tax lot

500	SENE	38.00
600	NESE	37.00
700	SESE	38.00
800	SWSE	38.00
1000	SWSW	5.00

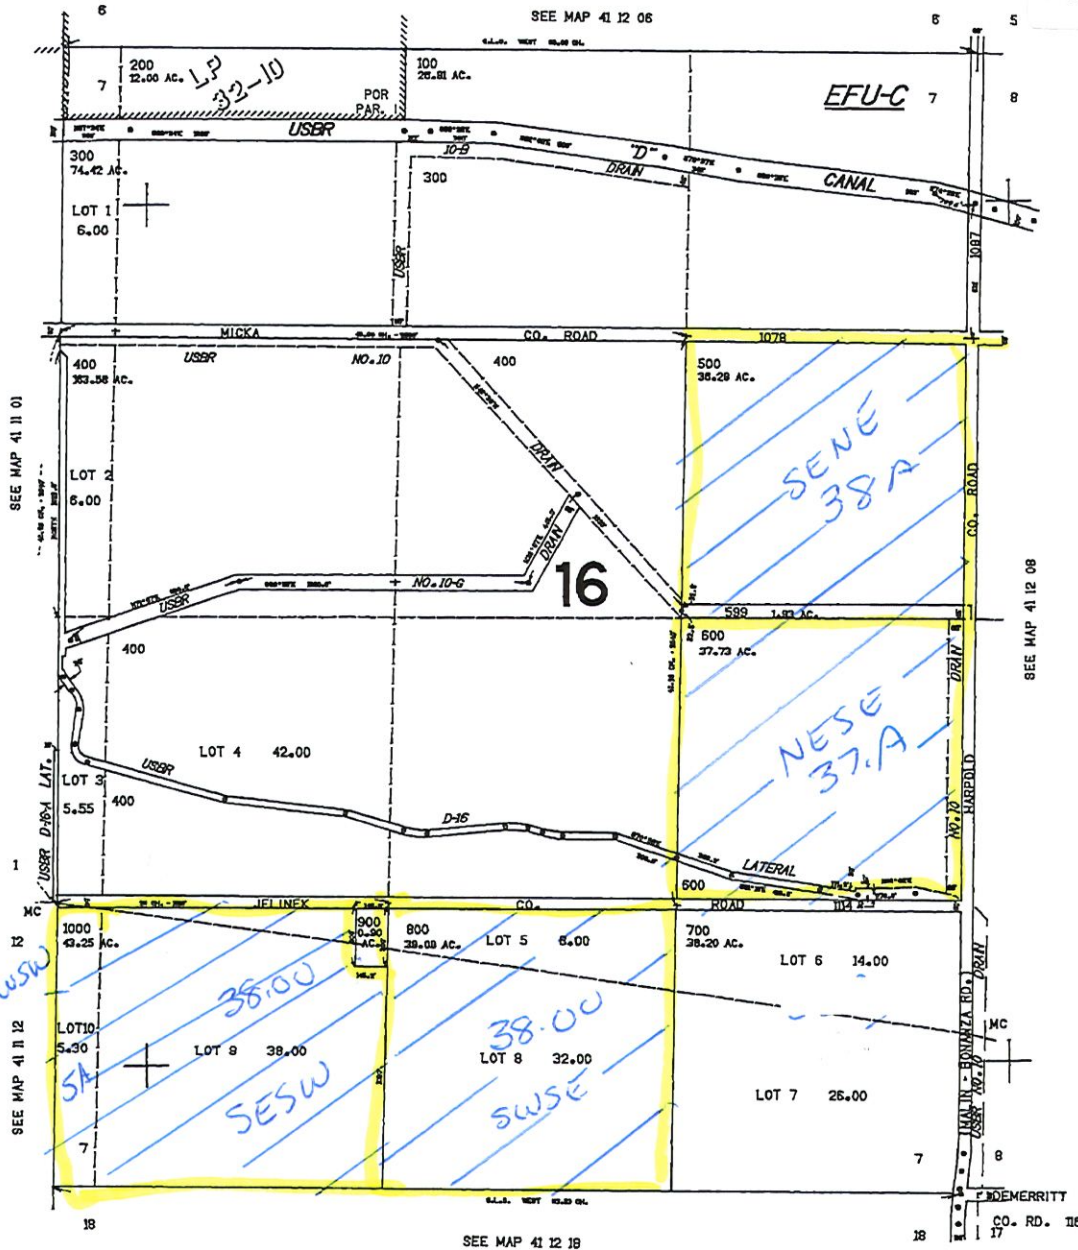

Scale  
1" = 880'

131.000

41 12 07

REVISED 12-9-13

THIS MAP WAS PREPARED FOR ASSESSMENT PURPOSE ONLY

SECTION 08 T.41S. R.12E. W.M.  
KLAMATH COUNTY

1"=400'

MAP 7 OF 9

MAP CREATED 04/01/2021

RECEIVED

APR 07 2021

OWRD

NORTH


T41S R12E

SEC 08

Tax lot

1200 NWSW 39.00

1300 SWSW 38.00

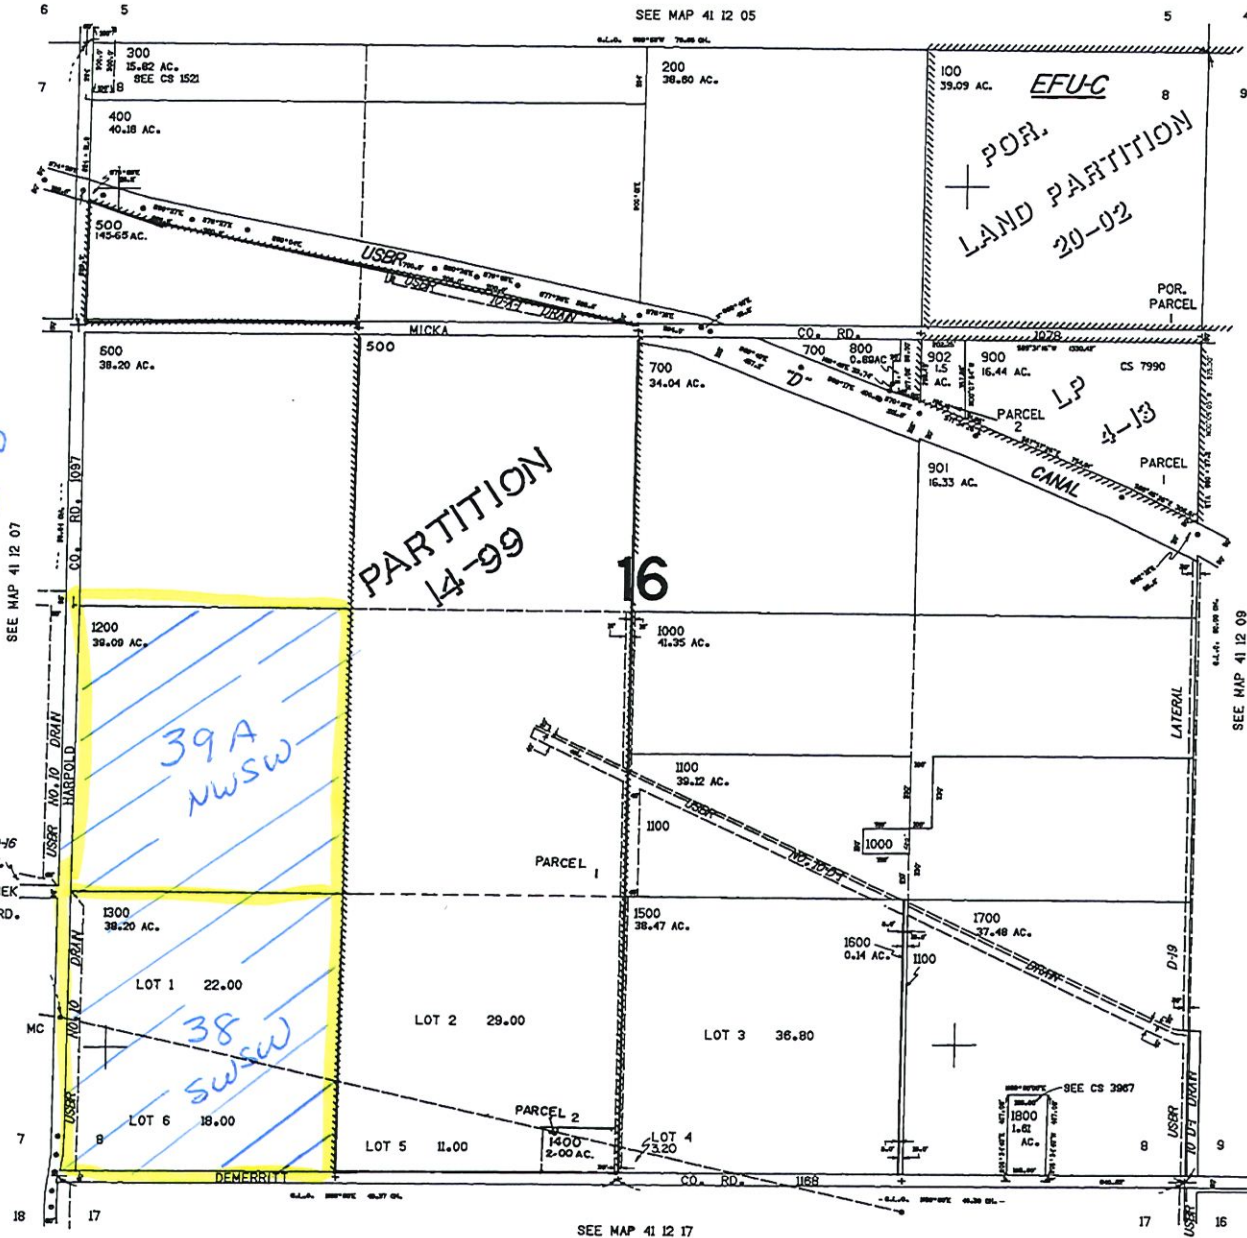

Scale

1" = 880'

41 12 08



THIS MAP WAS PREPARED FOR ASSESSMENT PURPOSE ONLY

SECTION 17 T.41S. R.12E. W.M. KLAMATH COUNTY

1"=400'

MAP 8 OF 9

MAP CREATED 04/01/2021

RECEIVED

APR 07 2021

OWRD

NORTH

T41S R12E


SEC. 17

Tax lot

400 NWNW 3.00  
SWNW 40.00  
SEnw 38.00

Scale

1"=880'

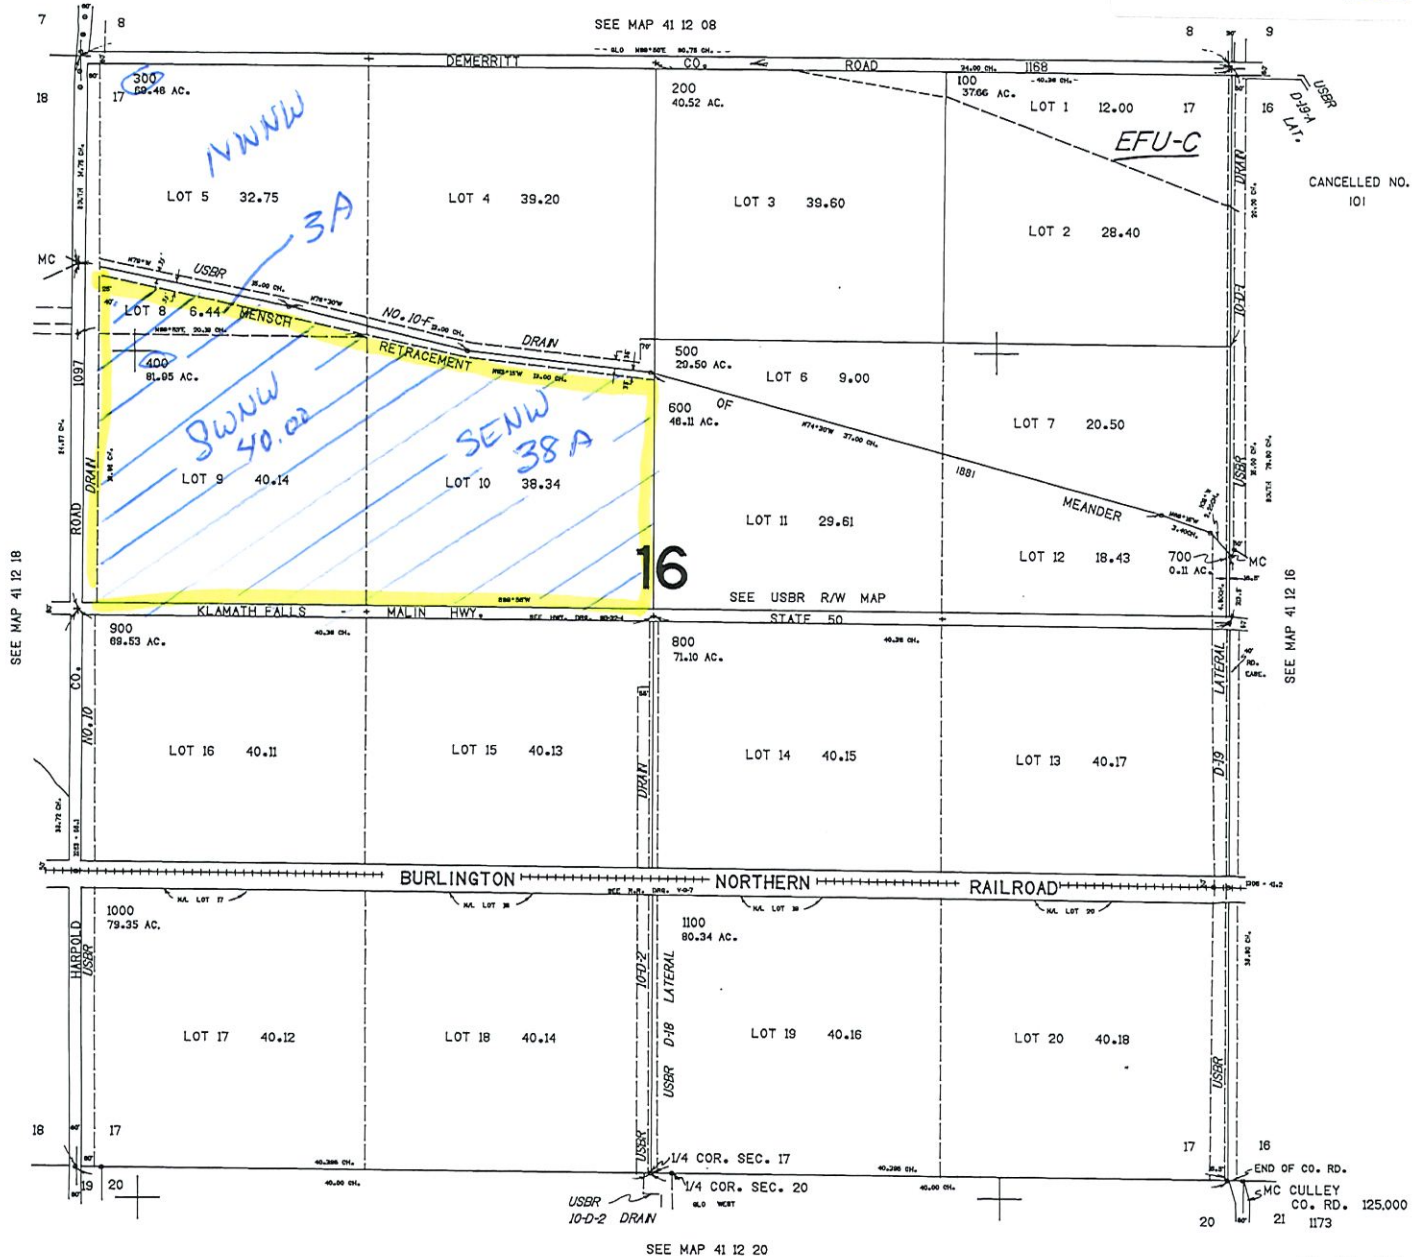

3.000

SEE MAP 41 12 20

41 12 17



SECTION 18 T.41S. R.12E. W.M.  
 KLAMATH COUNTY  
 1"=400'

MAP 9 OF 9

MAP CREATED 04/01/2021

THIS MAP WAS PREPARED FOR  
 ASSESSMENT PURPOSE ONLY.

RECEIVED

APR 07 2021

OWRD

NORTH  
 T41S R12E  
 SEC. 18  
 Tax lot


Scale  
 1" = 880'

