


Bengard
Well #1

SECTION 26 T.39S. R.11 1/2E. W.M.
KLAMATH COUNTY
1"=400'

MAP 2 OF 5

MAP CREATED 02-04-2021

THIS MAP WAS PREPARED FOR
ASSESSMENT PURPOSE ONLY.

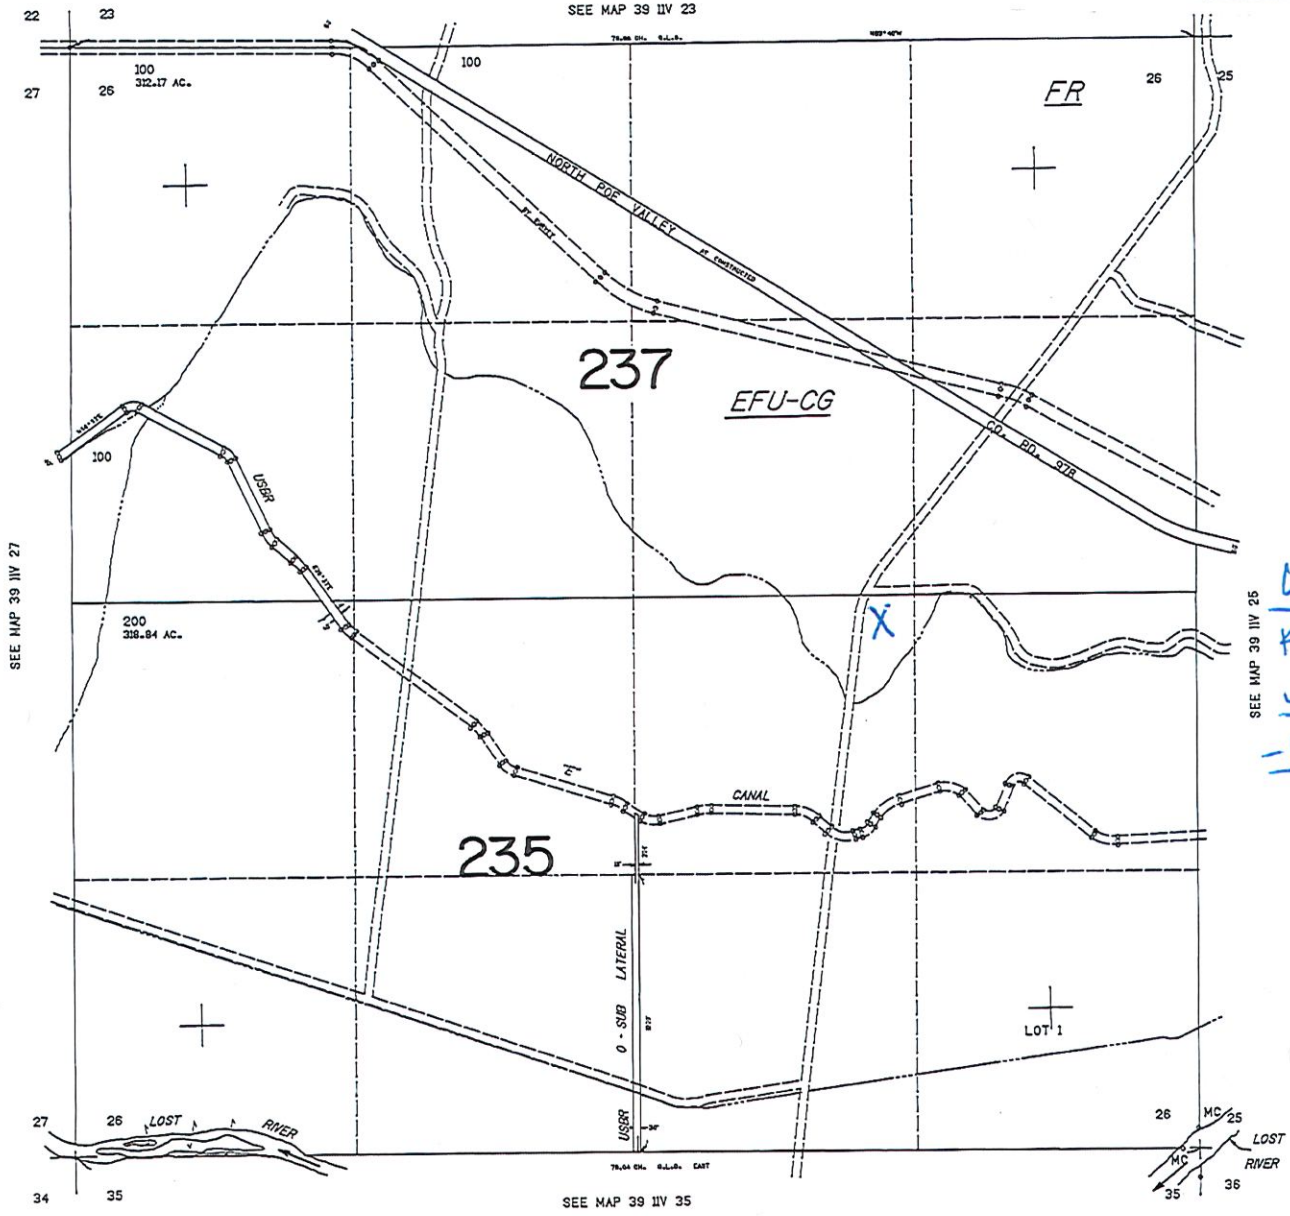

Well location
KLAM 10292
42.1584
-121.4925

725,000

39 IIV 26


Bengard
Well #2

REVISED 11-05-2018
THIS MAP WAS PREPARED FOR
ASSESSMENT PURPOSE ONLY

SECTION 22 T.39S. R.11 1/2E. W.M.
KLAMATH COUNTY

MAP 1 OF 5

MAP CREATED 02-04-2021

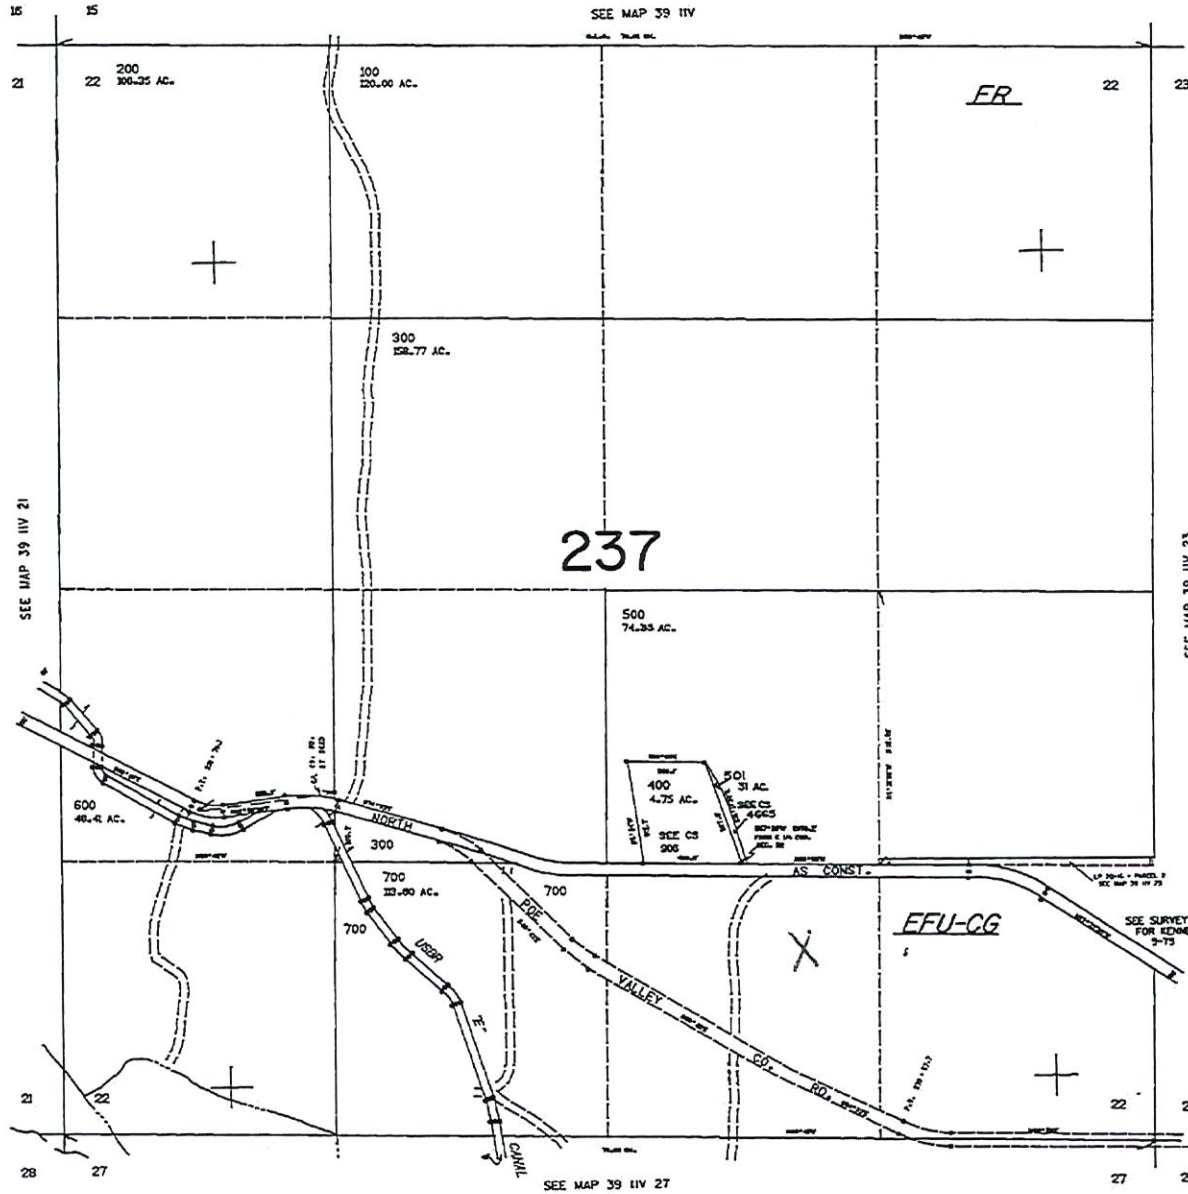


RECEIVED
APR 03 2021
OWRD

Well location
Klam 53779
42.1682
-121.5121

SECTION 27 T.39S. R.11 1/2E. W.M.
KLAMATH COUNTY

1"=400'

THIS MAP WAS PREPARED FOR
ASSESSMENT PURPOSE ONLY.

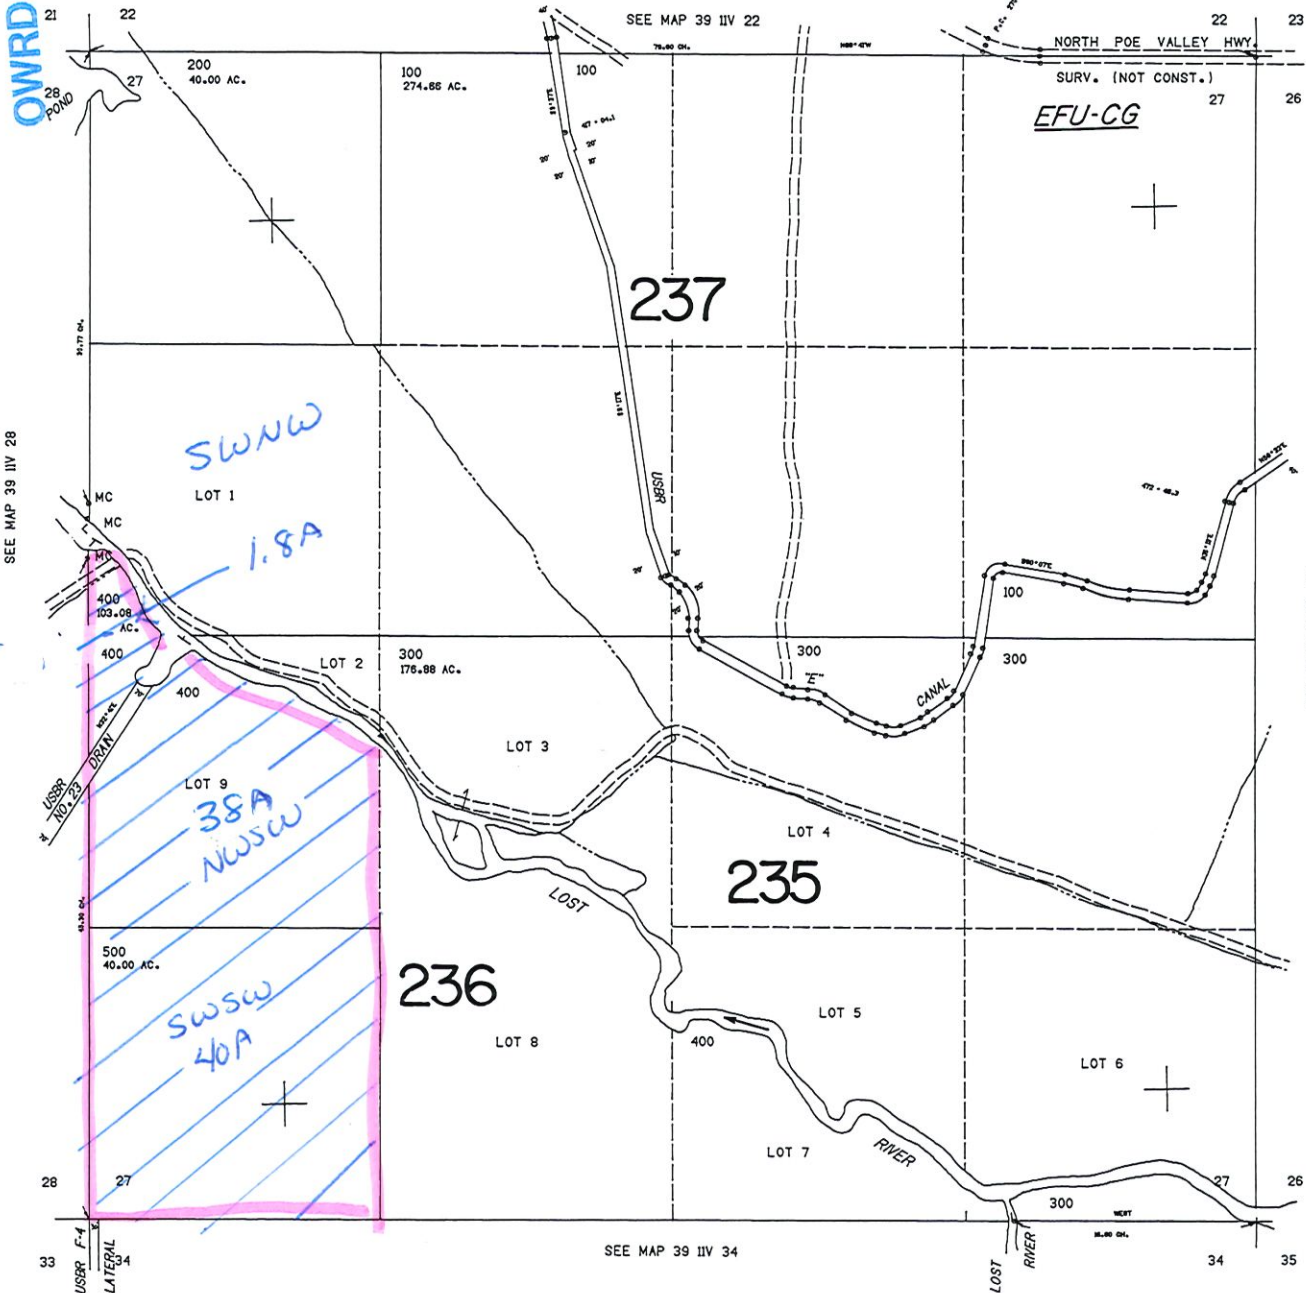

RECEIVED
APR 03 2021

OWWRD

NORTH


T39S R11.5E
Sec 27
Tax lot
400-5WNW-1.80
NWSW 38.0
500-5WSW-40.0

Scale
1" = 880'

SECTION 28 T.39S. R.11 1/2E. W.M.
KLAMATH COUNTY

1"=400'

THIS MAP WAS PREPARED FOR ASSESSMENT PURPOSE ONLY.

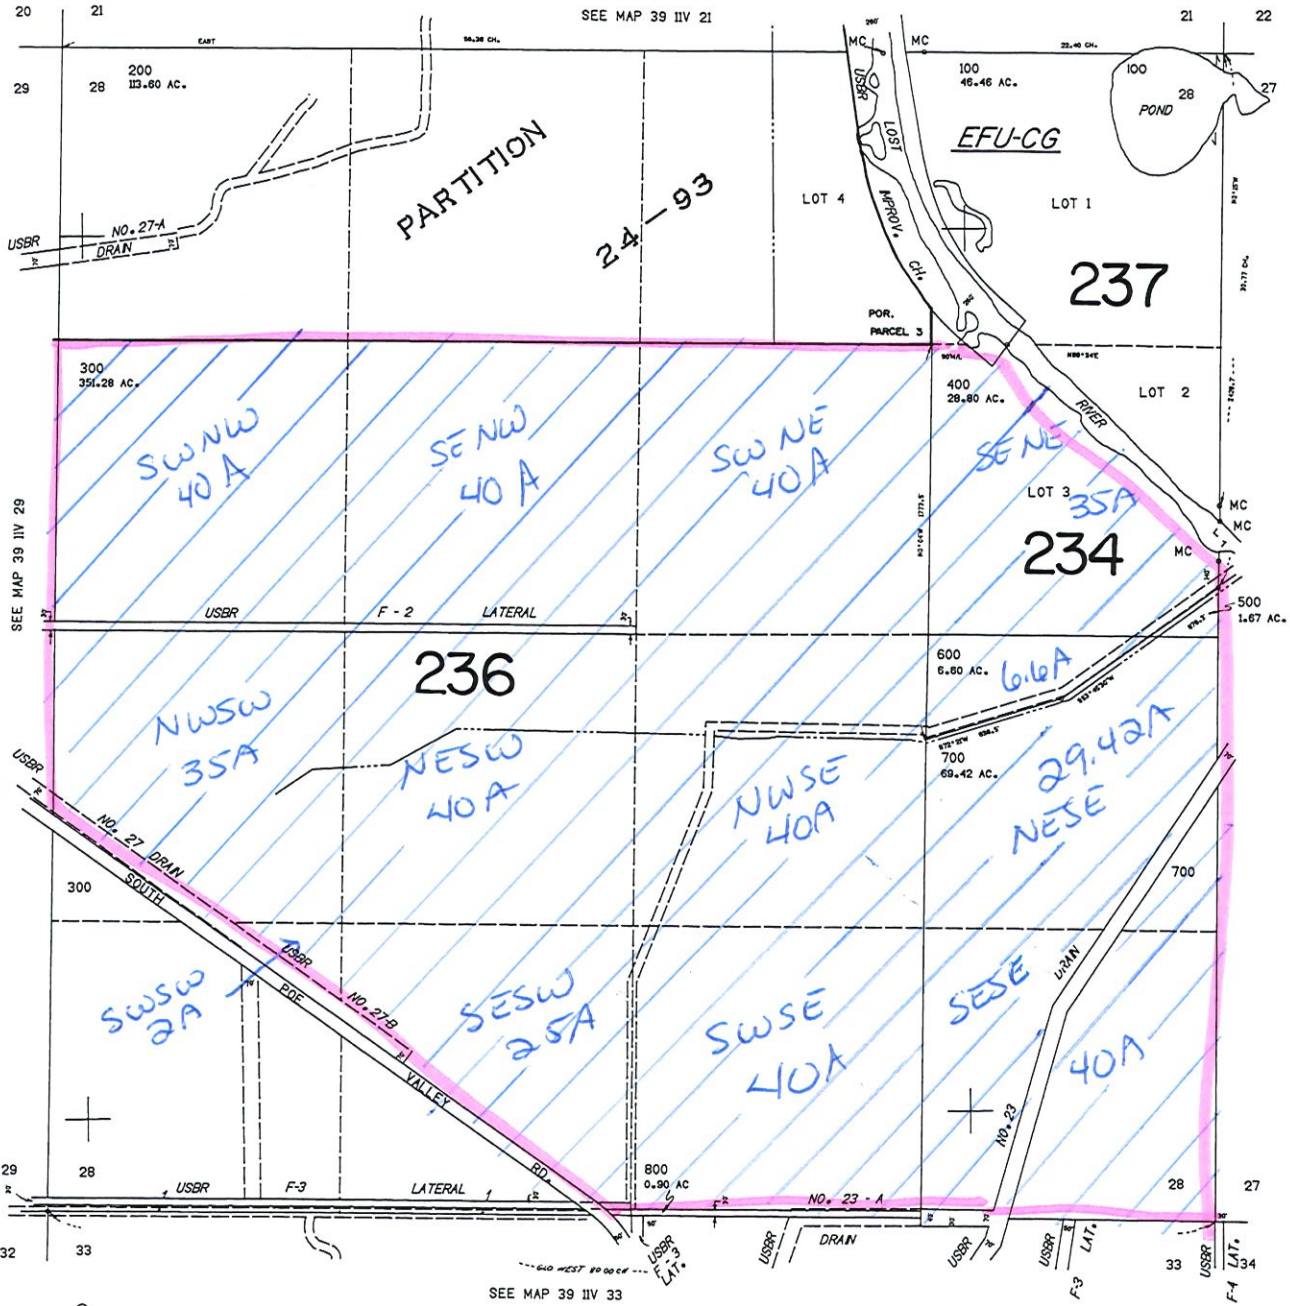

RECEIVED
APR 09 2021
OWRD

NORTH

T39S R11.5E
SEC 28
Tax lot

300	SWNW	40.0
	SE NW	46.0
	SW NE	40.0
	NW SE	40.0
	NWSW	35.00
	NESW	40.00
	SWSW	2.00
	SESW	25.00
	SWSE	40A
400	SENE	35.0
600	NESE	6.6
700	NESE	29.42
	SESE	40.0

Scale
1"=800'

REVISED 06-04-14

THIS MAP WAS PREPARED FOR ASSESSMENT PURPOSE ONLY

SECTION 34 T.39S. R.11 1/2E. W.M. KLAMATH COUNTY

1" = 400'

MAP 5 OF 5


MAP CREATED 03/08/2021

NORTH
T39S R11.5E
SEC. 34

Taxlot

- 200 NENW 40.0
- SENW 12.0
- SWNW 34.0
- 300 NWNW 39.25
- 400 SWNW 5.96
- 500 NWSW 40.0
- SWSW 38.0
- 900 SWSE 38.18

Scale
1" = 880'

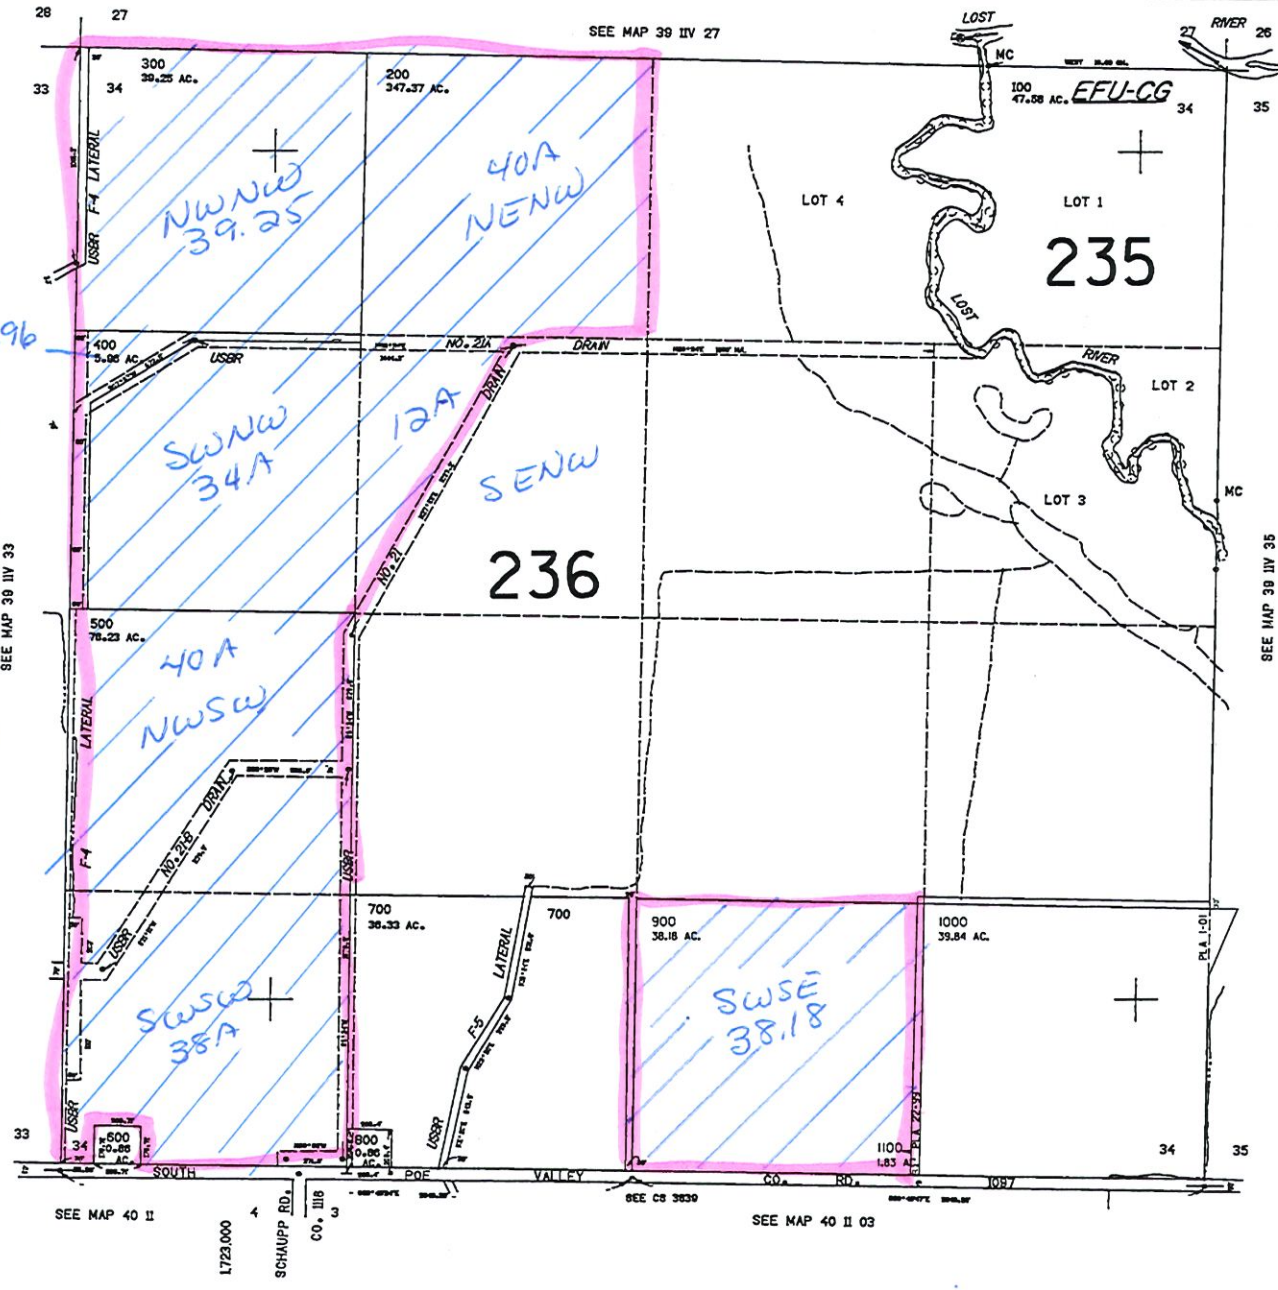

RECEIVED
APR 09
OWRD


174,000

SECTION 26 T.39S. R.11 1/2E. W.M.
KLAMATH COUNTY
1"=400'

39 IIV 26

THIS MAP WAS PREPARED FOR
ASSESSMENT PURPOSE ONLY.

NORTH
T39S R11 1/2E
Sec 26

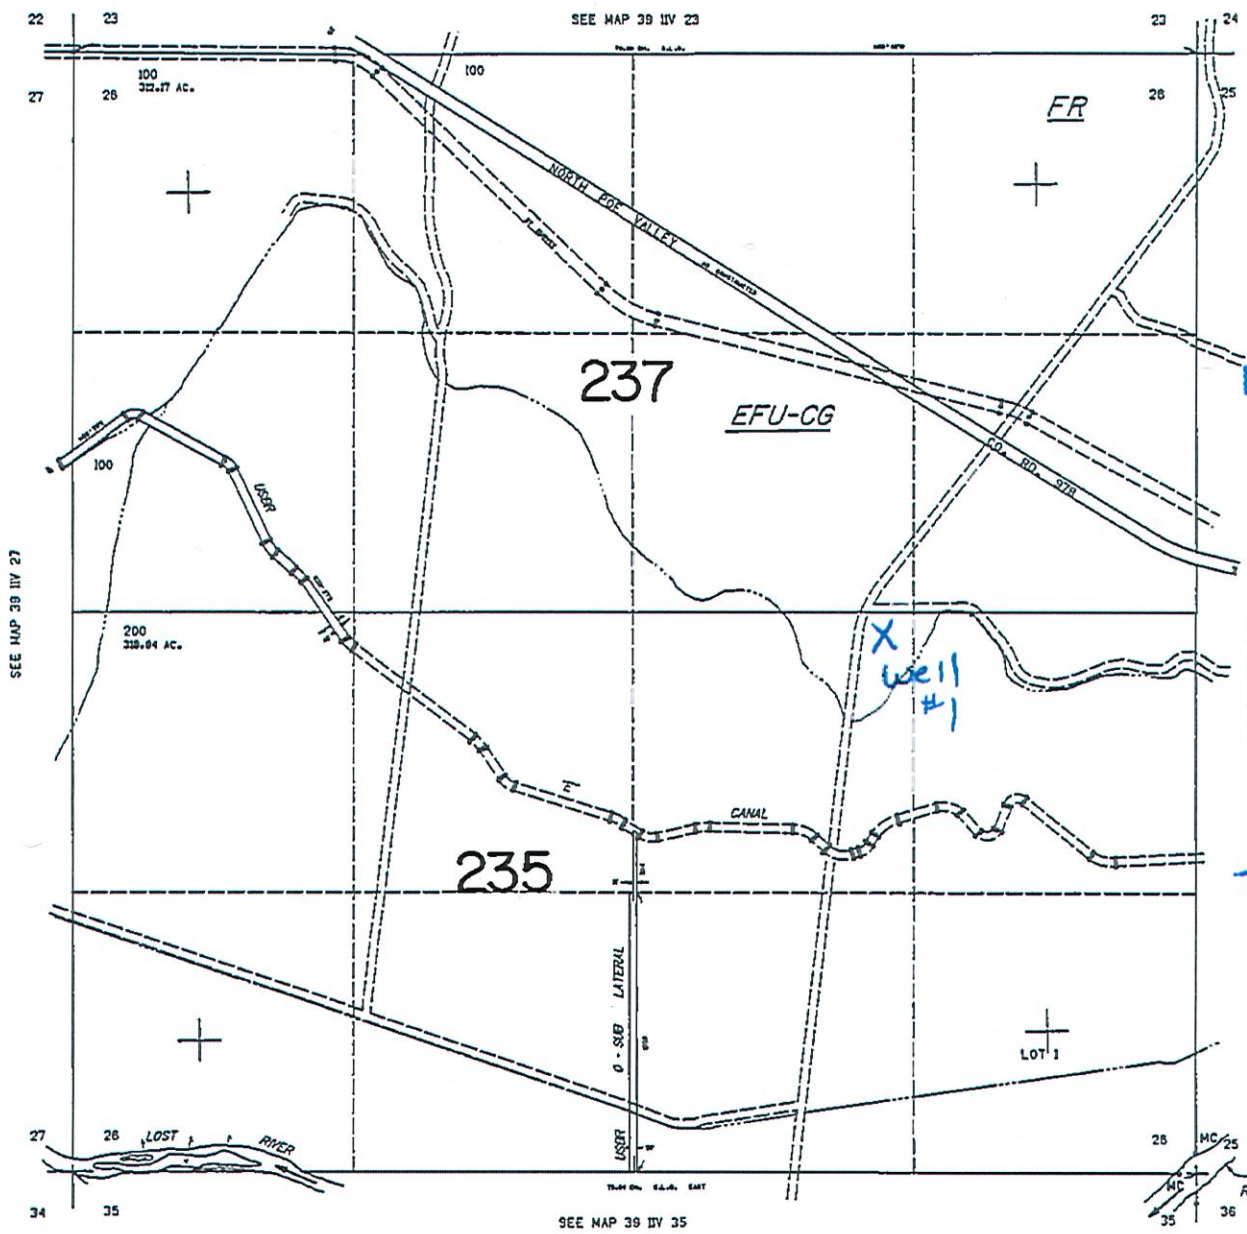

RECEIVED
JUN 01 2020
OWRD

Well # 1
139.3' South
221.1' West
FROM 1/4 1/4
of NESE

Scale
1" = 400'

Map 2 of 5

SECTION 22 T.39S. R.11 1/2E. W.M.
KLAMATH COUNTY

39 IIV 22

THIS MAP WAS PREPARED FOR
ASSESSMENT PURPOSE ONLY.

1"=400'


↑
NORTH
T39S 11 1/2 E
Sec 22

RECEIVED
JUN 01 2020
OWRD

Well # 2
Location

520.0' east
481.2' south
SE Center
Corner

Scale
1" = 400'

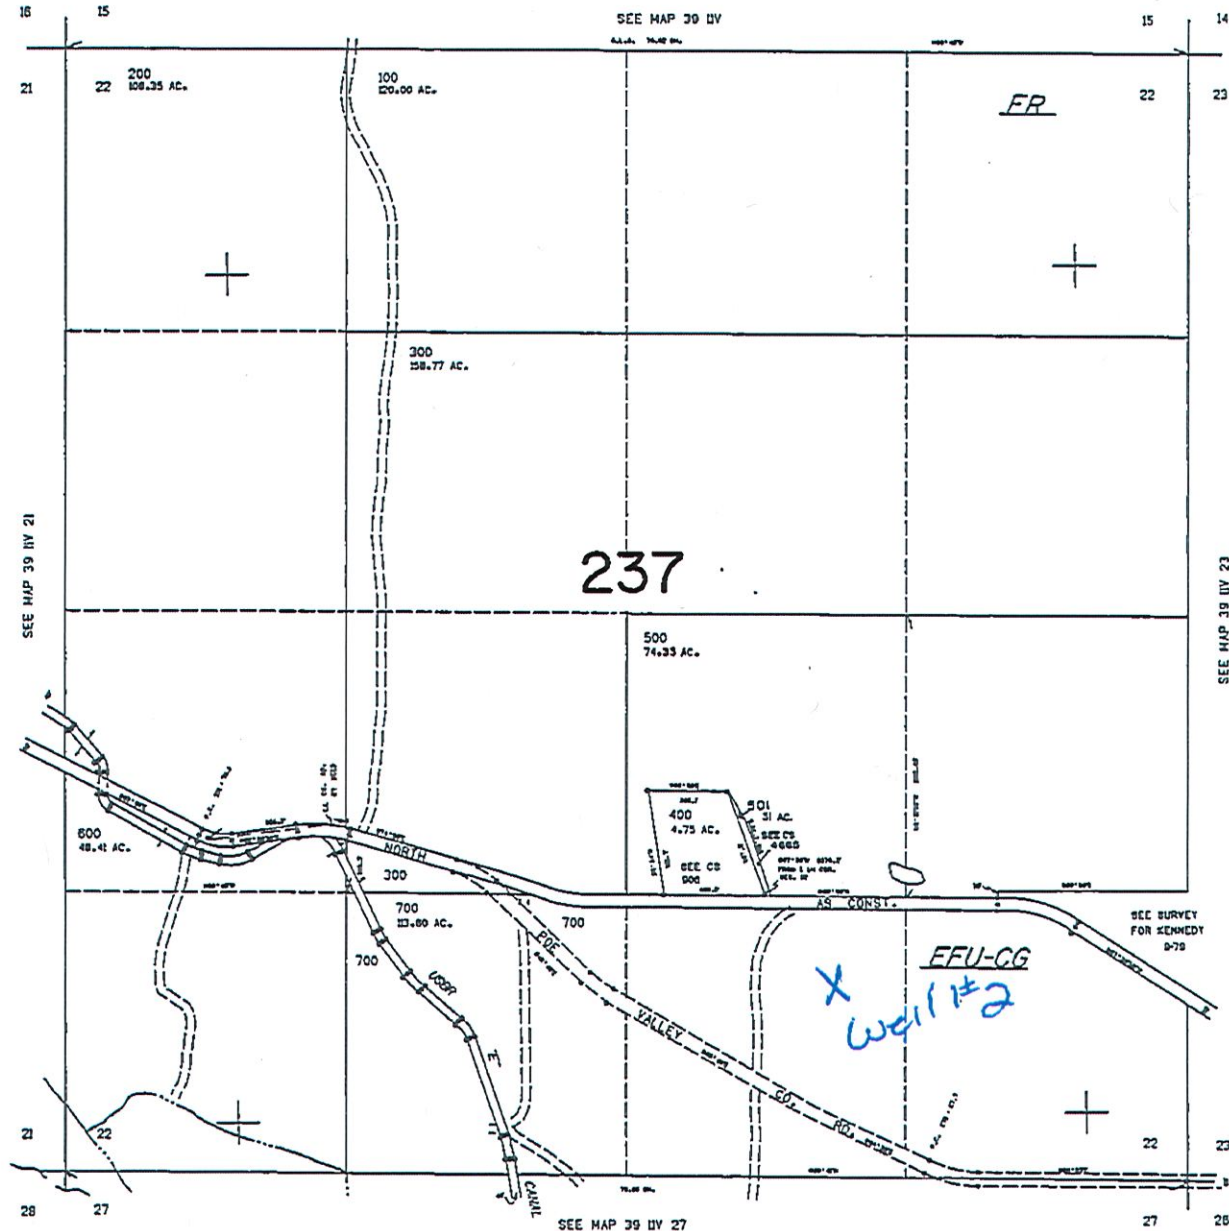

21,000

39 IIV 22