

Holland Dairy
King



REVISED 5-15-07
THIS MAP WAS PREPARED FOR
ASSESSMENT PURPOSE ONLY


SECTION 29 T.39S. R.11E. W.M.
KLAMATH COUNTY
1"=400'

MAP 1 OF 4

MAP CREATED 02/05/2021

RECEIVED
APR 12 2021
OWRD

Well Location
KLAM 52778
42.1528
-121.5569

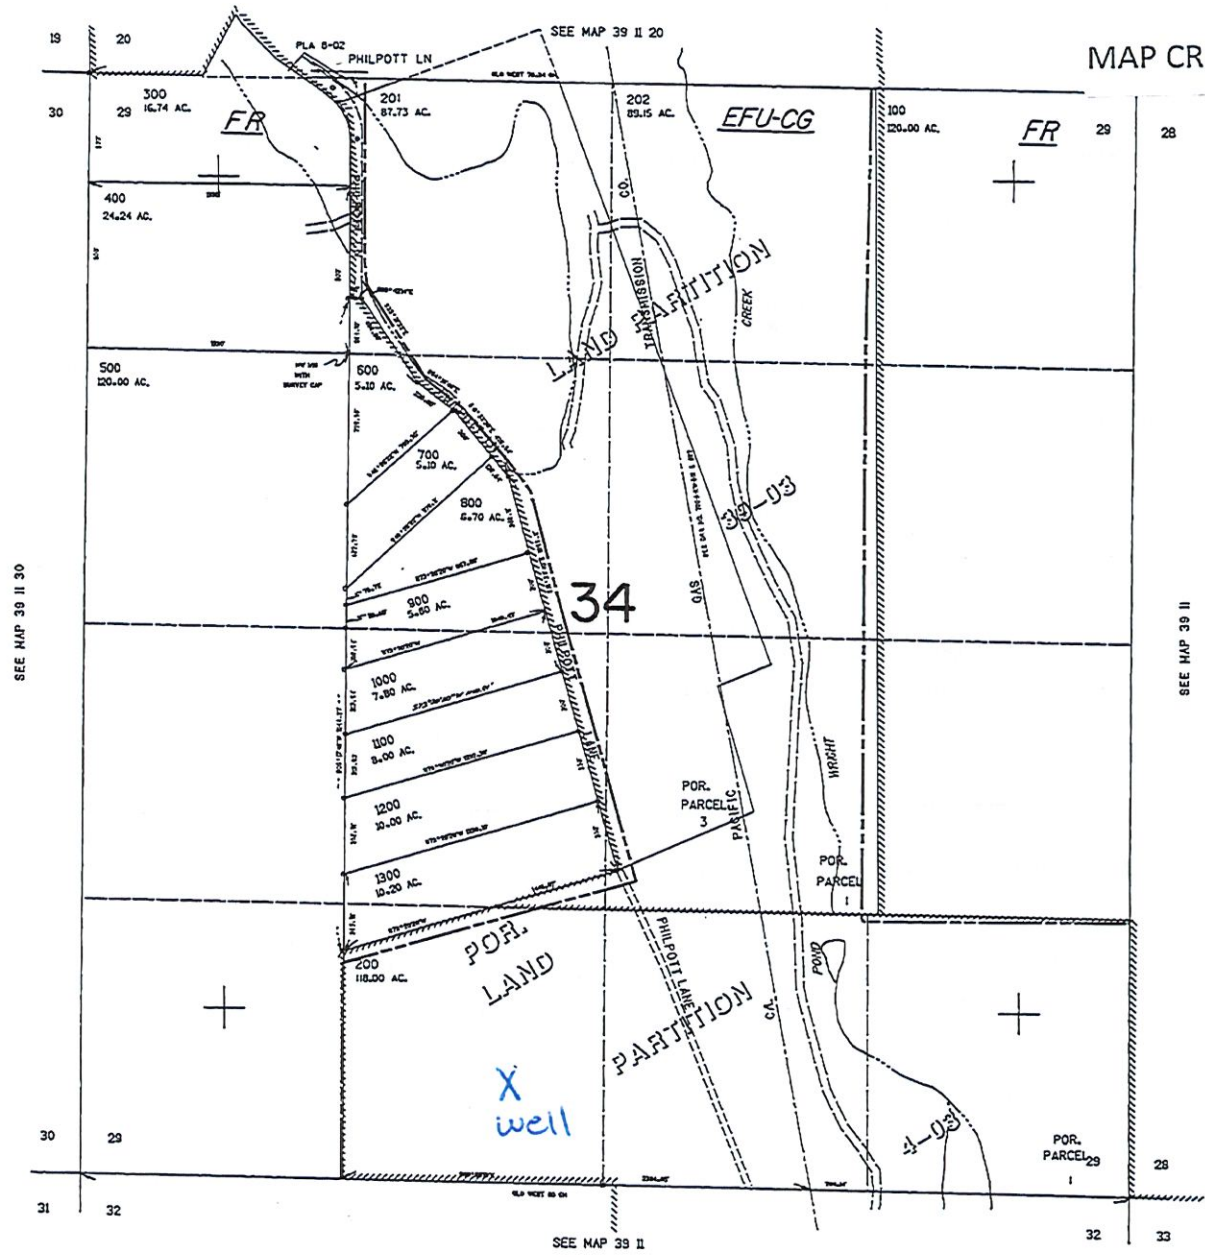

REVISED 11-27-07


THIS MAP WAS PREPARED FOR ASSESSMENT PURPOSE ONLY

SECTION 17 T.39S. R.10E. W.M. KLAMATH COUNTY

1" = 400'

MAP 2 OF 4

MAP CREATED 04/02/2021

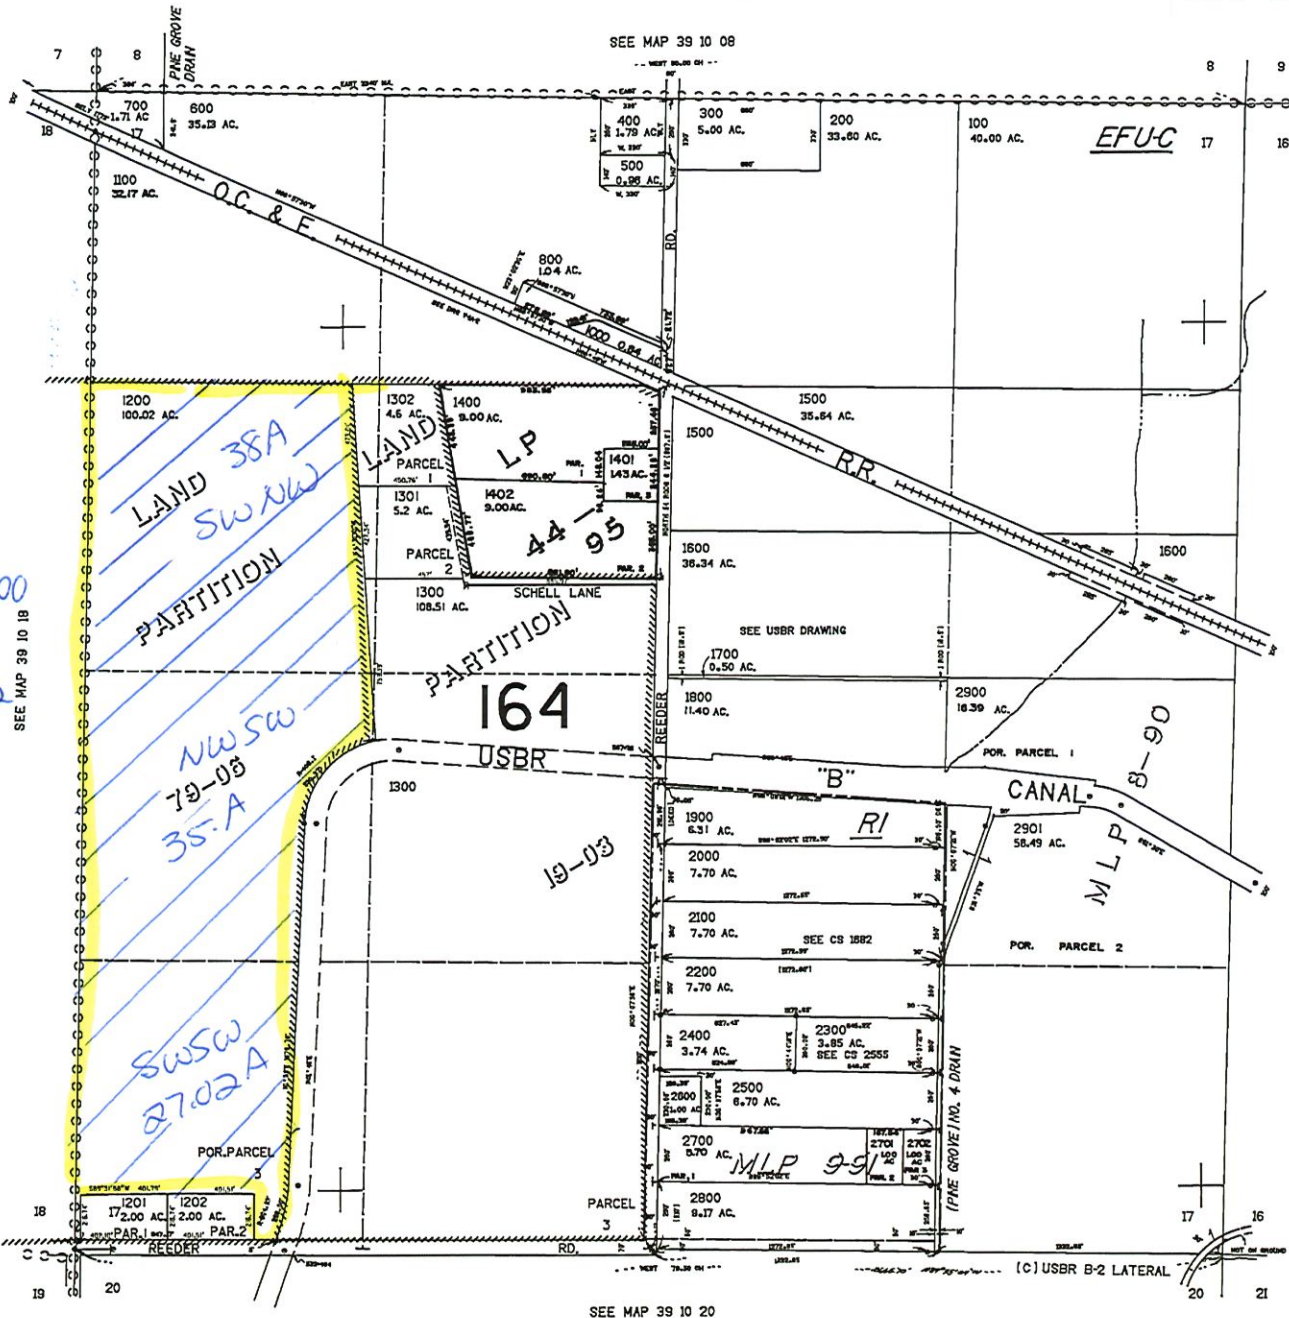

1

NORTH

T39S R10E

SEC. 17

Tax lot

1200 SWNW 38.00

NNSW 35.00

SWSW 27.02

SEE MAP 39 10 18

LAND 38A SWNW PARTITION

LAND LP 44-95

LAND 164

NWSW 79-05 35-A

SWSW 27.02A

PAR. PARCEL 1

PAR. PARCEL 2

PAR. PARCEL 3

SEE MAP 39 10 18

Scale

1" = 880'

CANCELLED NO. 1900A1

SEE MAP 39 10 18

RECEIVED APR 12 2021

OWRD

186,000

SEE MAP 39 10 20

39 10 17

1,000

REVISED 07-27-2020

THIS MAP WAS PREPARED FOR ASSESSMENT PURPOSE ONLY

SECTION 18 T.39S. R.10E. W.M.
KLAMATH COUNTY

1" = 400'

MAP 3 OF 4


MAP CREATED 04/02/2021



T39S R10E
SEC. 18

Tax lot

800 SWSE 40.00
SESE 38.00

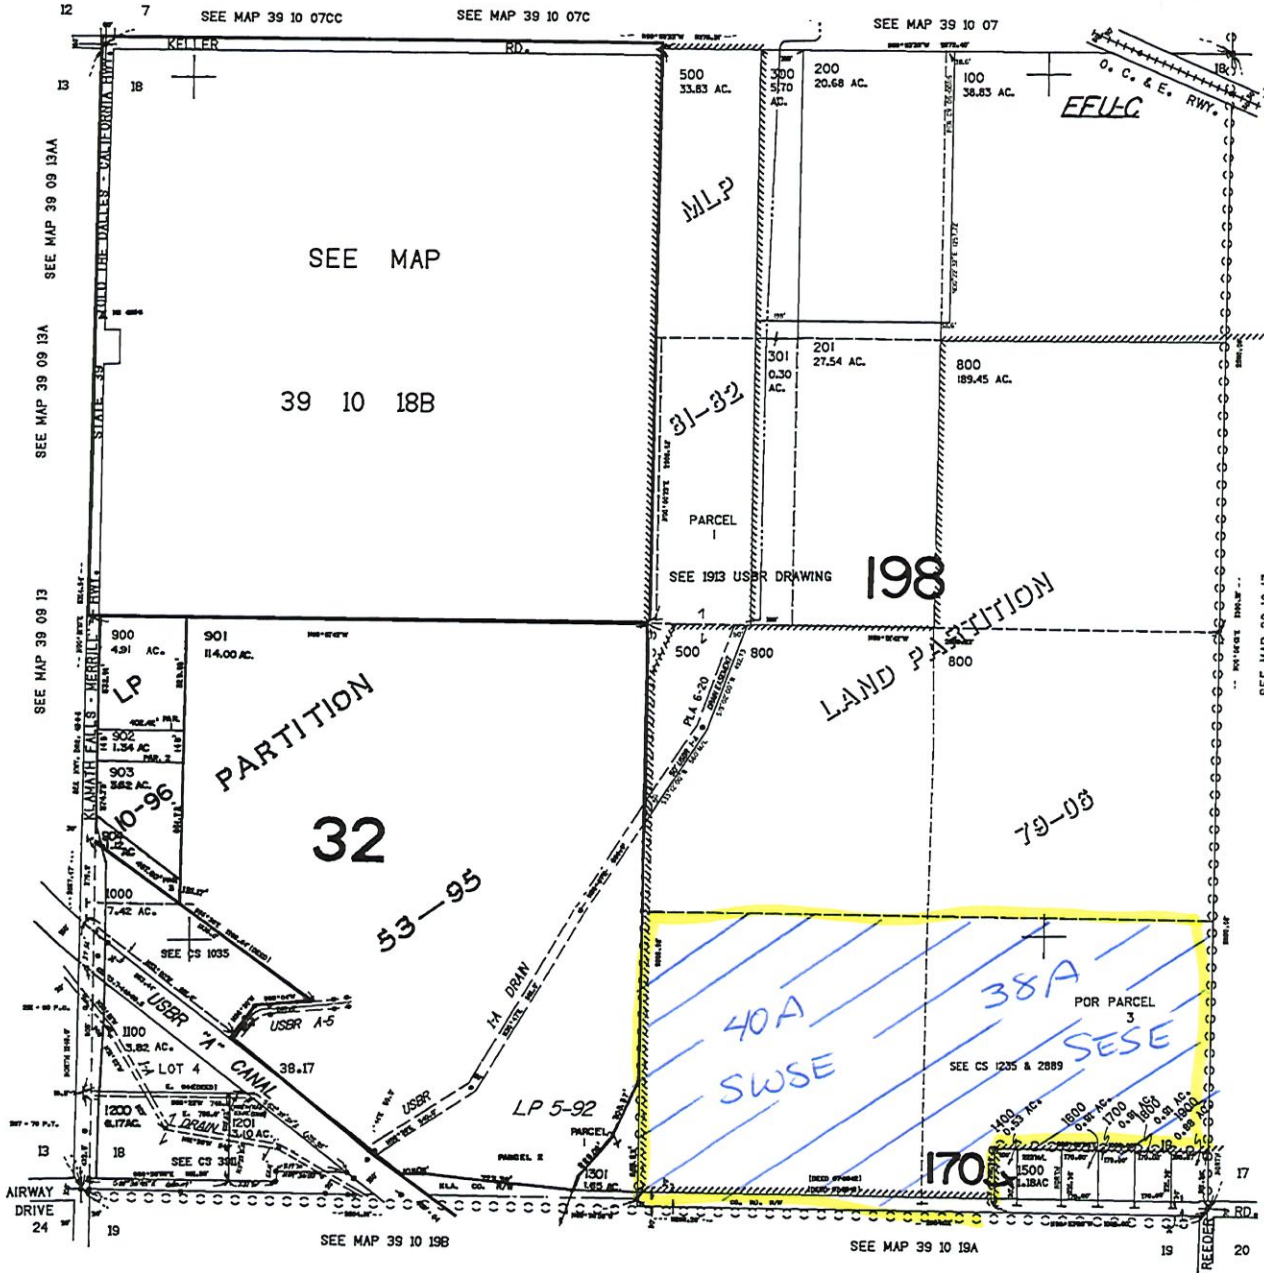

CANCELLED NO.

- 1300
- 600
- 700
- 800A1
- 400
- 202

RECEIVED

APR 12 2021

OWRD

Scale
1" = 880'

39 10 18
& INDEX

THIS MAP WAS PREPARED FOR ASSESSMENT PURPOSE ONLY


SECTION 20 T.39S. R.10E. W.M. KLAMATH COUNTY

1"=400'

SEE MAP 39 10 17

MAP 4 OF 4

MAP CREATED 04/02/2021

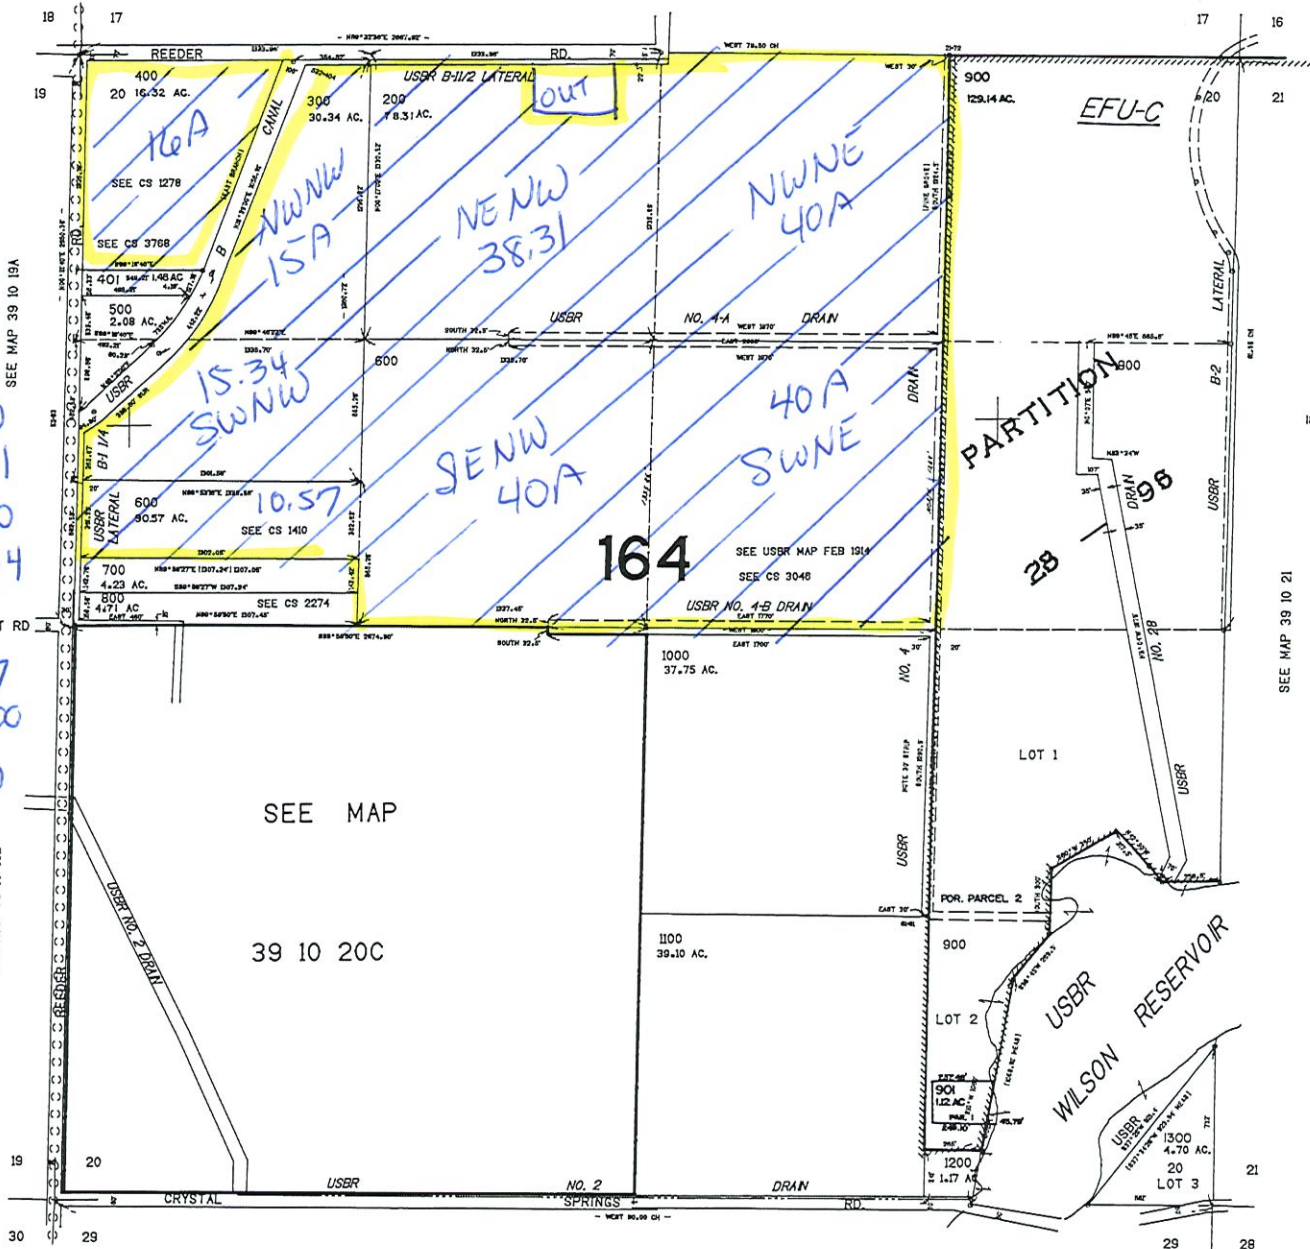

↑
NORTH
T39S R10E
SEC 20

Tax lot

200 - NWNE	40.00
NENW	38.31
300 NWNW	15.00
SWNW	15.34
400 NNNW	16.00
600 SWNW	10.57
SENW	40.00
SWNE	40.00

Scale
1" = 880'

RECEIVED
APR 12 2021
OWRD



39 10 20
& INDEX
180,000

CLAIM OF BENEFICIAL AND FINAL PROO


RECEIVED

MAY 13 2020

OWRD

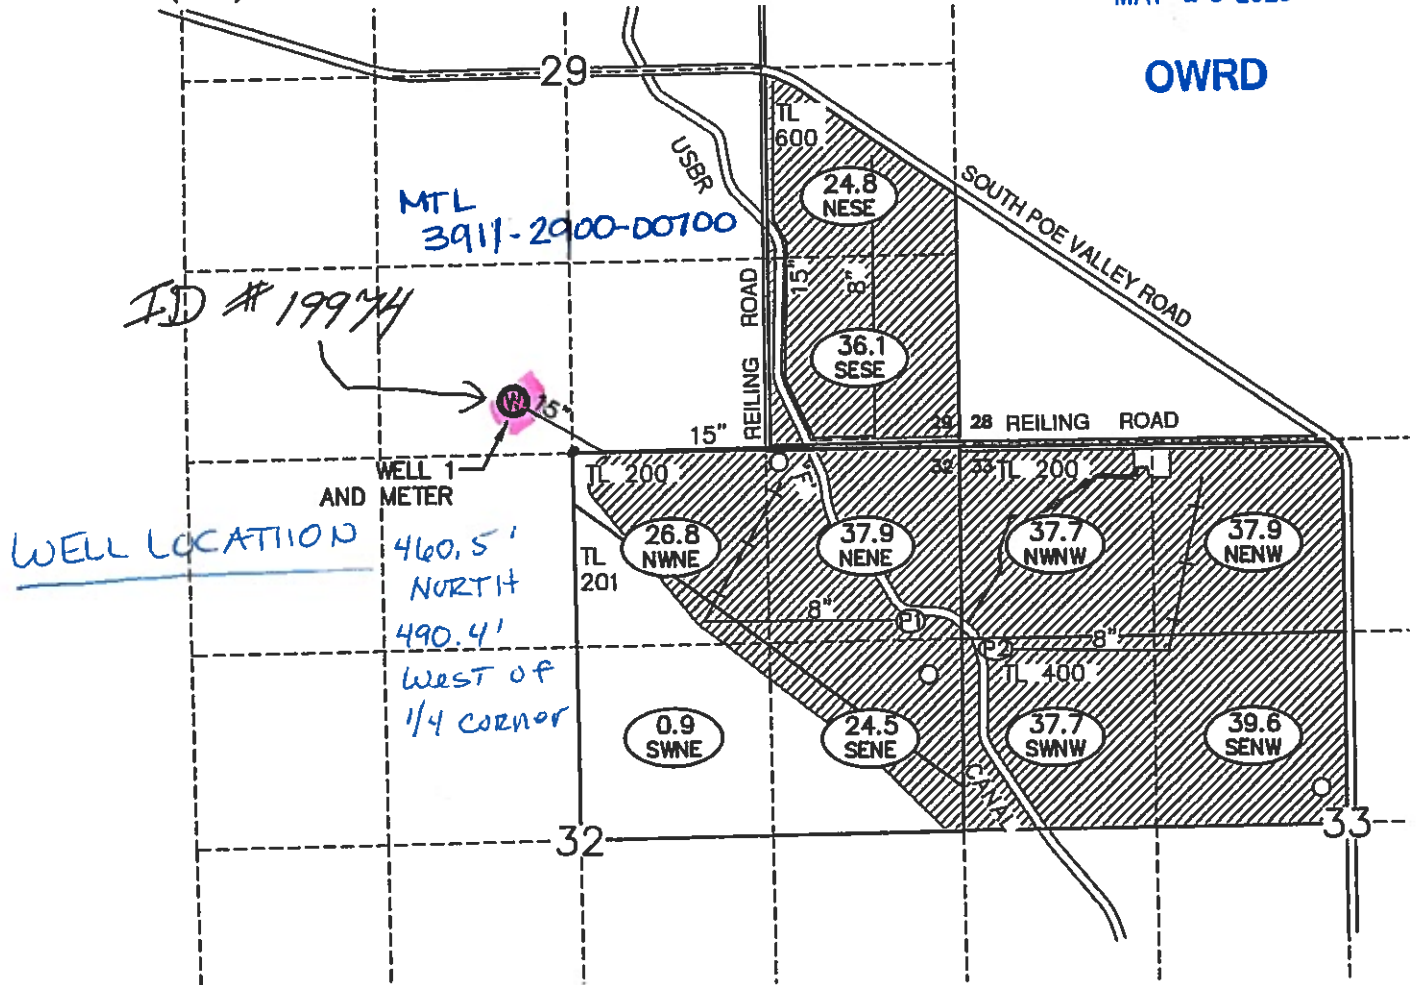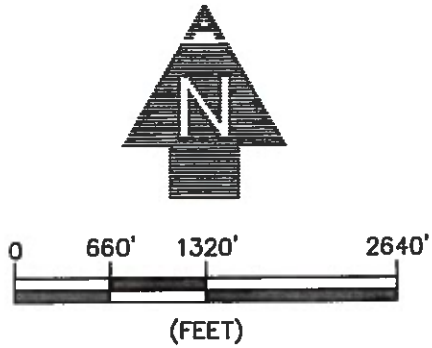

LEGEND

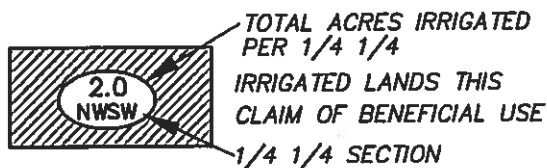

32 SECTION DESIGNATION

TL TAX LOT NUMBER

--- SECTION LINES
- - - 1/4 1/4 LINES

== ROADS

--- TAX LOT BOUNDARY

10" MAIN LINE SIZE

---+---+---+--- PIVOT LINE

○ BIG GUN

⊙ EXISTING P.O.A. (WELL)

⊙ PUMPING STATION AND NUMBER