

GREAT WESTERN

SECTION 02 T.40S. R.09E. W.M.  
KLAMATH COUNTY

MAP 1 OF 3

THIS MAP WAS PREPARED FOR  
ASSESSMENT PURPOSE ONLY.

1"=400'

MAP CREATED 02/05/2022


NORTH

T40S R09E  
SEC 2

RECEIVED

APR 16 2021

OWRD

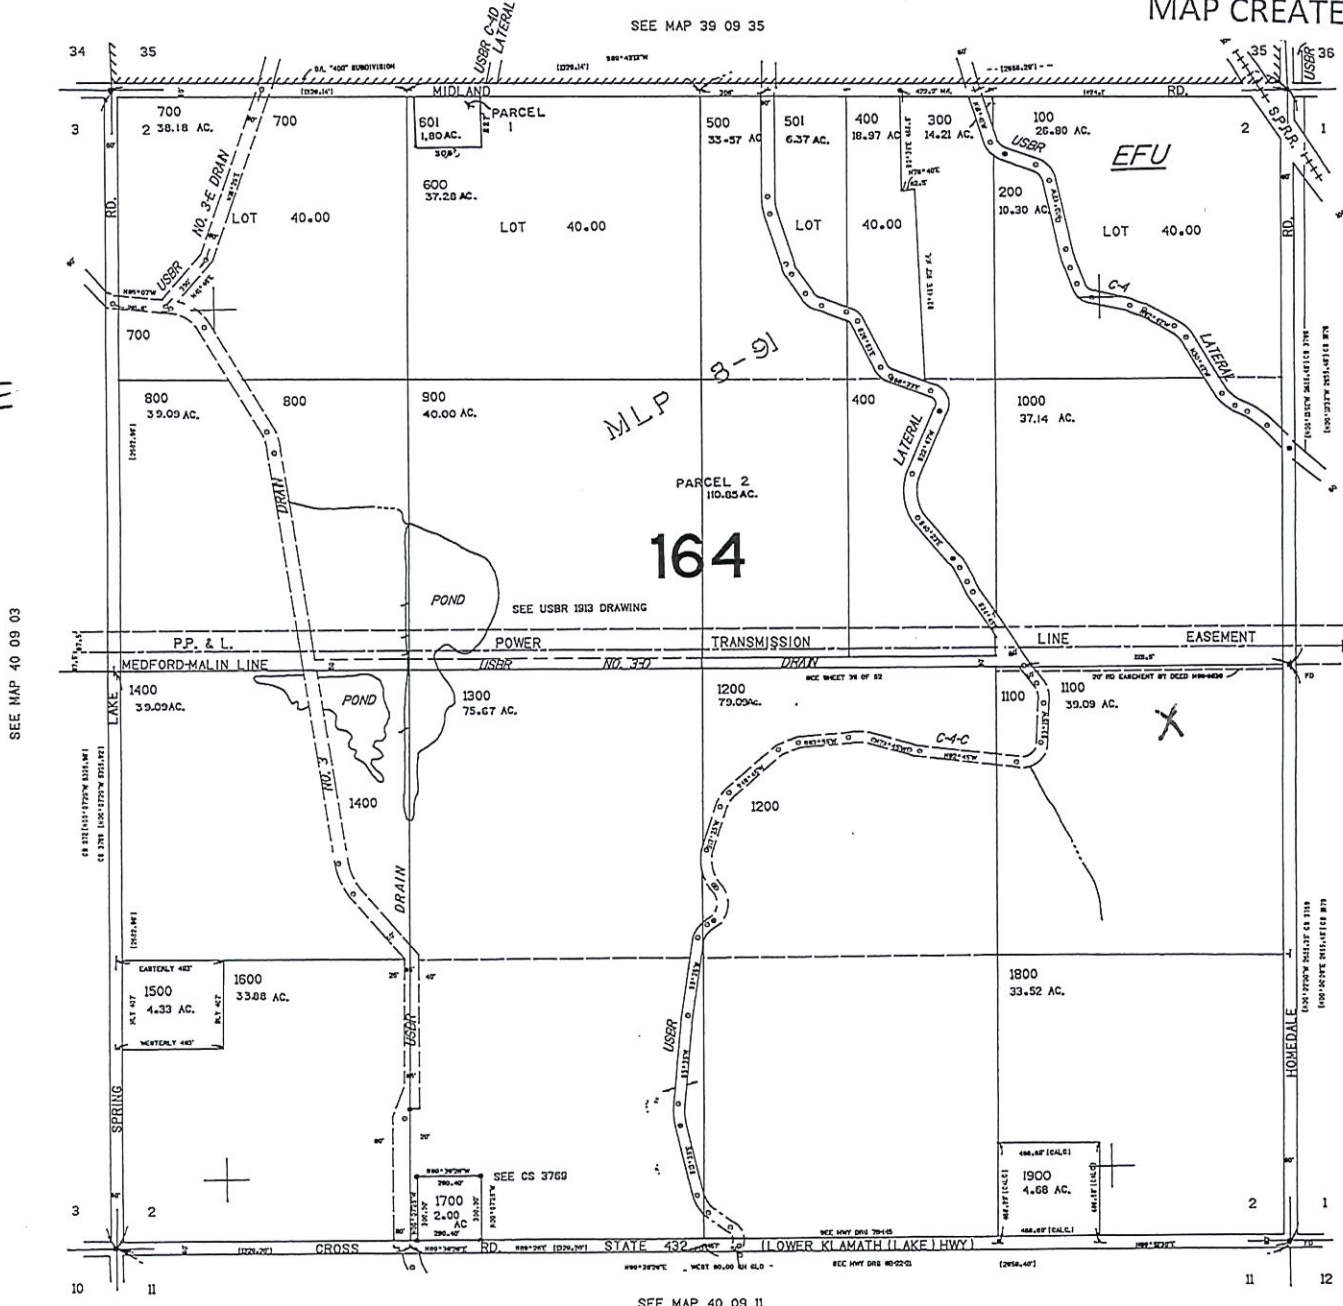

SEE MAP 40 09 03

SEE MAP 40 09 01

Well # 1  
Well location  
KLAM 52825  
42.1184  
-121.7195

165.1

SEE MAP 40 09 11

40 09 02

000

REVISED 03-30-2020  
THIS MAP WAS PREPARED FOR  
ASSESSMENT PURPOSE ONLY

SECTION 01 T.40S. R.09E. W.M.  
KLAMATH COUNTY  
1" = 400'

MAP 2 OF 3

MAP CREATED 04/09/2021


NORTH

T40S R09E  
SEC 01

Tax lot

500-SENW 35.00  
NESW 14.00  
600 SENE 18.00  
SWNE 20.00

Scale  
1" = 880'

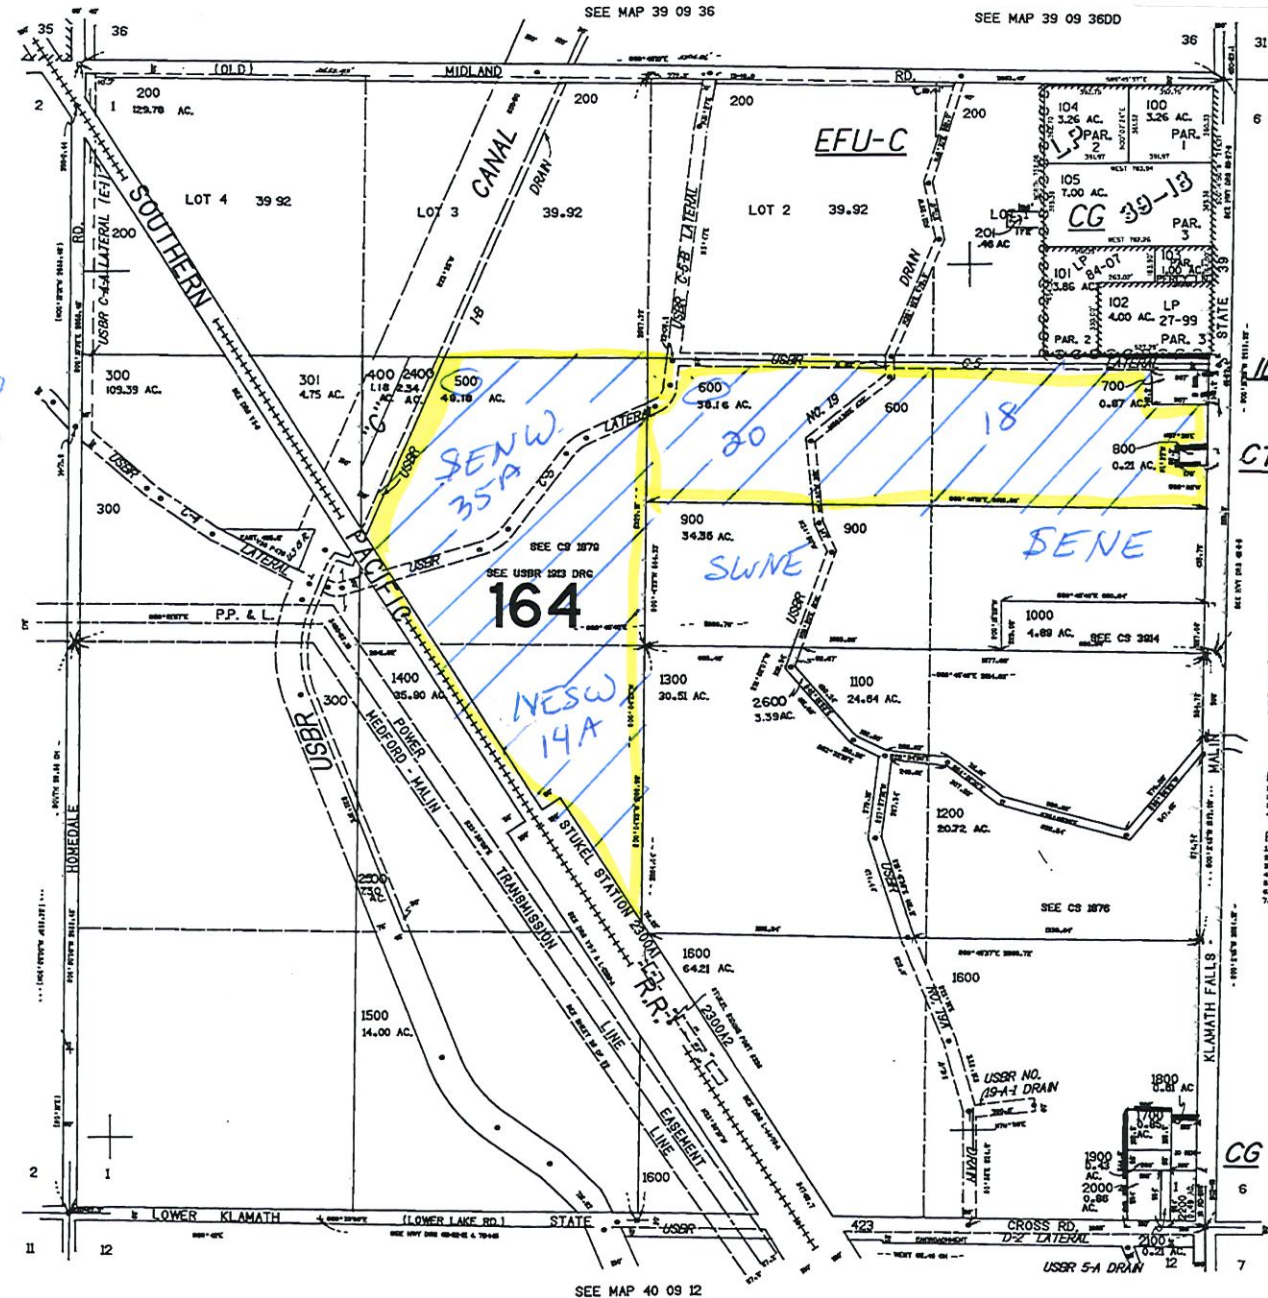

RECEIVED  
APR 16 2021  
OWRD

CT

CG

SEE MAP 40 09 12

40 09 01



SECTION 06 T.40S. R.10E. W.M.  
KLAMATH COUNTY

1"=400'


MAP 3 OF 3

MAP CREATED 04/09/2021

THIS MAP WAS PREPARED FOR  
ASSESSMENT PURPOSE ONLY

NORTH  
T40S R10E  
SEC 7  
Tax lot  
1000  
NWSW 8.00  
SWSW 38.00

RECEIVED  
APR 16 2021  
OWRD

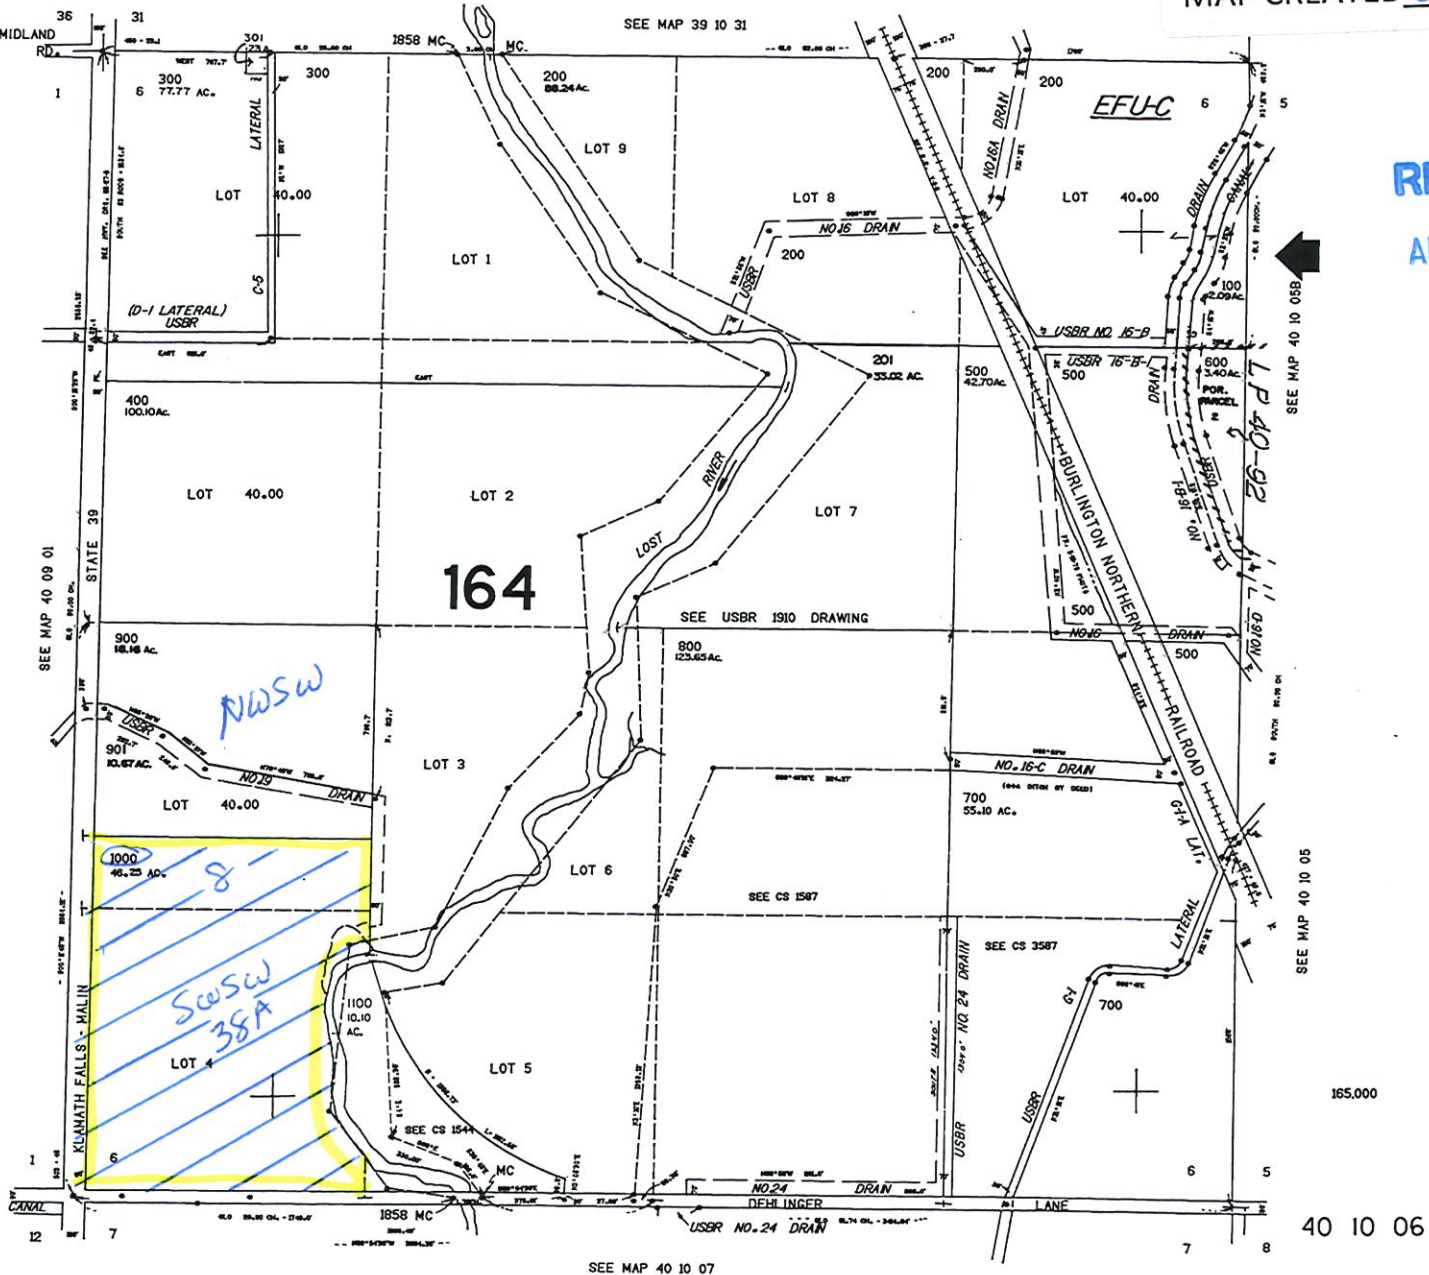

164

SEE MAP 40 09 01

SEE MAP 40 10 08B

SEE MAP 40 10 05

40 10 06

SEE MAP 40 10 07

1876.000

Scale  
1"=880'