

REVISED 07-12-2018


THIS MAP WAS PREPARED FOR ASSESSMENT PURPOSE ONLY

SECTION 23 T.41S. R.12E. W.M.
KLAMATH COUNTY
1" = 400'

MAP 2 OF 3

MAP CREATED 03/19/2021

NORTH

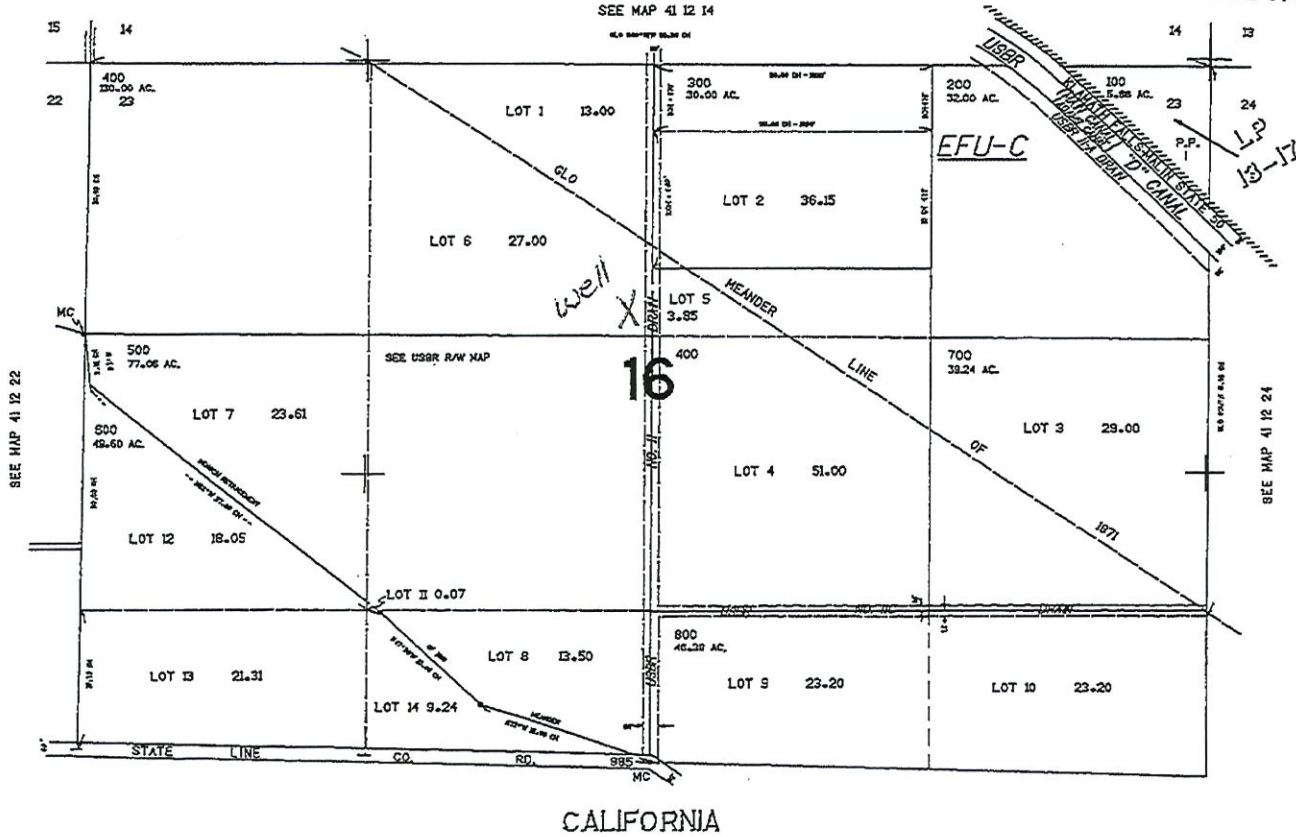

Well #2

Well location
KLAM 10445
42.0029
-121.3794

Scale
1" = 880'

RECEIVED
APR 20 2021
OWRD

41 12 23

776

CLAIM OF BENEFICIAL USE AND FINAL PROOF MAP

FOR
CHEYNE BROTHERS, LLC


T41S, R12E, Sec. 14 & 23 W.M.
KLAMATH COUNTY, OREGON

RECEIVED BY OWRD APPLICATION No. G-15764
PERMIT No. G-15430
JUL 15 2013

SALEM, OR

NOTES:

1. THIS MAP WAS PREPARED FROM FIELD MEASUREMENTS, NAIP 2005 AERIAL PHOTOGRAPH, KLAMATH COUNTY TAX MAPS 401214 & 401223 AND OREGON GLO MAPS.
2. THE PURPOSE OF THIS MAP IS TO IDENTIFY THE LOCATION OF THE WATER RIGHT ONLY, AND IS NOT INTENDED TO PROVIDE DIMENSIONS OR LOCATION OF PROPERTY LINES.
3. FOR TAX LOT INFORMATION, SEE TAX MAPS INCLUDED WITH THIS COBU.
4. DATE OF PRIORITY FOR THIS APPLICATION IS MAY 17, 2002.

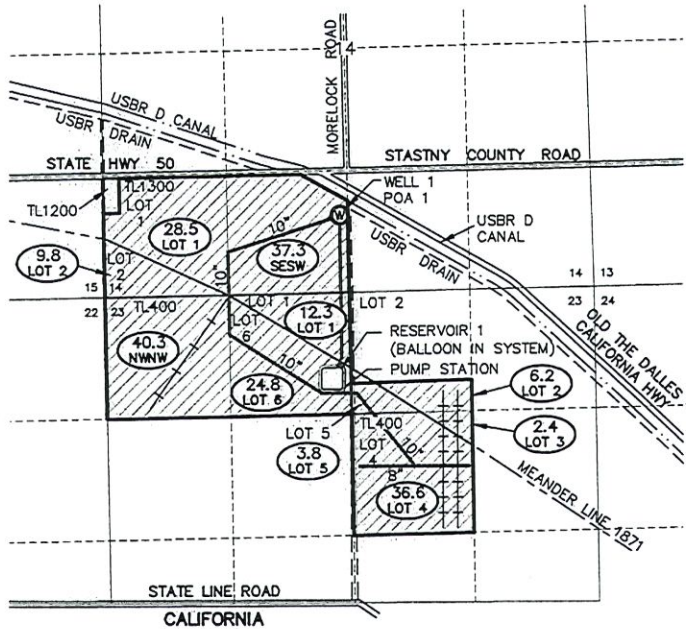


WELL TIE:

THE WELL AND METER ARE LOCATED 2,595' EAST AND 471' SOUTH FROM THE S1/16 OF S15/S14 LOCATED IN THE SE1/4 SW1/4, SECTION 14, T41S, R12E, W.M.

RECEIVED
APR 20 2021
OWRD

G LOT	1/4 1/4	SECTION	TOWNSHIP	RANGE	PERMITTED ACRES	# IRRIGATED ACRES
1	SW SW	14	41S	12E	27.0	28.5
2	SW SW	14	41S	12E	10.0	9.8
	SE SW	14	41S	12E	36.0	37.3
1	NE NW	23	41S	12E	13.0	12.3
2	NW NE	23	41S	12E	7.0	6.2
3	SW NE	23	41S	12E	4.0	2.4
4	SW NE	23	41S	12E	34.0	36.6
5	NW NE	23	41S	12E	3.0	3.8
6	NE NW	23	41S	12E	27.0	24.8
	NW NW	23	41S	12E	41.0	40.3
TOTAL ACRES IRRIGATED:					202.0	202.0


LEGEND

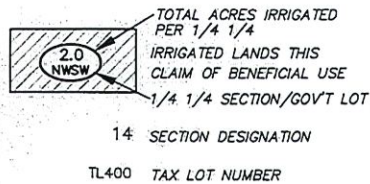

- SECTION LINES
- 1/4 1/4 LINES
- ROADS
- PROPERTY BOUNDARY
- TAX LOT BOUNDARY
- EASEMENTS

- 10" MAIN LINE SIZE
- PIVOT LINE
- 4" WHEEL LINES
- EXISTING P.O.A. (WELL)

Douglas E. Adkins Authorized Member
Applicant signature

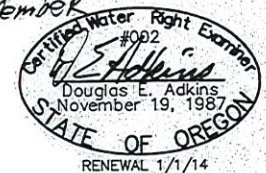

2950 Shasta Way · Klamath Falls, Oregon 97603 · (541) 884-4666 · FAX (541) 884-5335
Oregon · California
CHEYNE_BASE.DWG

COBU MAP # 776

RECEIVED

APR 20 2021

OWRD

Crown Top well

TRANSFER APPLICATION MAP FOR CALIFORNIA GIANT, INC.


IN SECTIONS 27 & 34, T40S, R12E W.M.
KLAMATH COUNTY, OREGON

CERTIFICATE No.: 27304
PERMIT No.: U-361
APPLICATION No.: U-393



NOTES:

1. THIS MAP WAS PREPARED FROM THE FINAL PROOF MAP FOR PERMIT U-361, OREGON GLO MAP, NAIP 2005 AERIAL PHOTOGRAPH AND KLAMATH COUNTY TAX MAPS.
2. THE PURPOSE OF THIS MAP IS TO IDENTIFY THE LOCATION OF THE WATER RIGHT ONLY, AND IS NOT INTENDED TO PROVIDE DIMENSIONS OR LOCATION OF PROPERTY LINES.
3. CURRENTLY ALL LANDS SHOWN HEREON ARE IRRIGATED FROM EXISTING P.O.A. WELL #1.
4. PRIORITY DATE OF ALL IRRIGATED LANDS SHOWN HEREON IS SEPTEMBER 26, 1950.
5. 199.8 ACRES ARE TO BE TRANSFERRED TO PROPOSED P.O.A. WELL #2.
6. 32.4 ACRES WILL REMAIN UNDER EXISTING P.O.A. WELL #1.
7. CERTIFICATE 68137 AUTHORIZES IRRIGATION OF 41.6 ACRES FROM PROPOSED P.O.A. WELL #2. SEE ATTACHED CERTIFICATE.

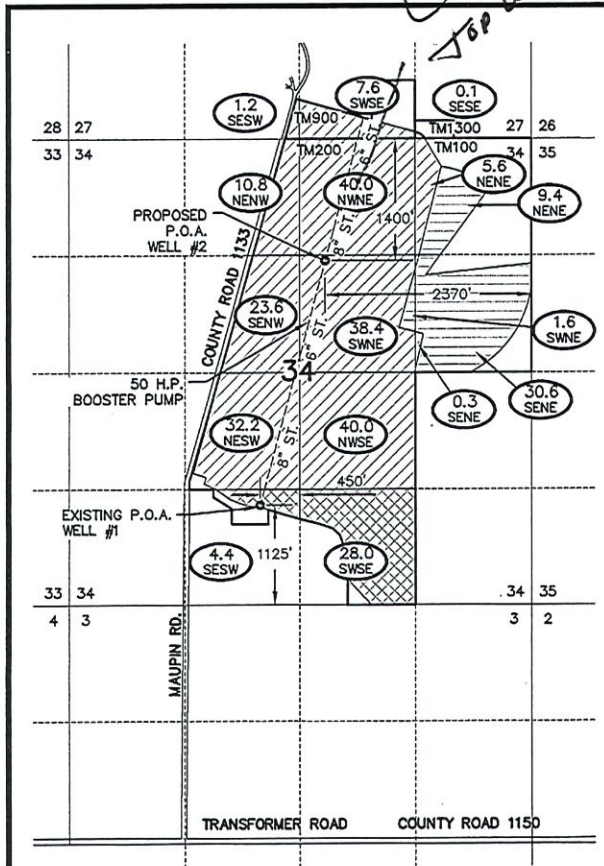

TAX MAP NUMBER	1/4 1/4	SECTION	TOWNSHIP	RANGE	WELL #	# IRRIGATED ACRES
900	SE SW	27	40S	R12E, WM	2	1.2
900	SW SE	27	40S	R12E, WM	2	7.6
900	SE SE	27	40S	R12E, WM	2	0.1
200	NE NE	34	40S	R12E, WM	2	5.6
200	NW NE	34	40S	R12E, WM	2	40.0
200	SW NE	34	40S	R12E, WM	2	38.4
200	SE NE	34	40S	R12E, WM	2	0.3
200	NE NW	34	40S	R12E, WM	2	10.8
200	SE NW	34	40S	R12E, WM	2	23.6
200	NE SW	34	40S	R12E, WM	2	32.2
200	SE SW	34	40S	R12E, WM	1	4.4
200	NW SE	34	40S	R12E, WM	2	40.0
200	SW SE	34	40S	R12E, WM	1	28.0

TOTAL ACRES IRRIGATED: 232.2

LEGEND

- IRRIGATED LANDS WELL #1 (UNCHANGED)
- IRRIGATED LANDS WELL #2 (CHANGED P.O.A.)
- CERTIFICATE 68137 IRRIGATED LANDS FROM WELL #2
- IRRIGATED ACREAGE 1/4 1/4 SECTION
- ROADWAY
- TAX MAP NUMBER
- TAX LOT BOUNDARY
- EXISTING WELL
- SECTION NUMBER AND CENTER
- SECTION LINE
- 1/4 1/4 LINE
- GOVERNMENT LOT NUMBER

Adkins
Applicant signature



RENEWAL 12/31/11

RECEIVED

JAN 13 2011

T 11185

WATER RESOURCES DEPT
SALEM, OREGON
Engineers Planners Surveyors



2950 Shasta Way · Klamath Falls, Oregon 97603 · (541) 884-4666 · FAX (541) 884-5335
Klamath Falls, OR

10/10/10

BASE.DWG

2988-01