

Horsley

MAP 1 OF 4

THIS MAP WAS PREPARED FOR  
ASSESSMENT PURPOSE ONLY

SECTION 31 T.39S. R.09E. W.M.  
KLAMATH COUNTY

1"=400'

MAP CREATED \_\_\_\_\_


map created  
02/05/2021

RECEIVED

APR 26 2021

OWRD

↑  
N

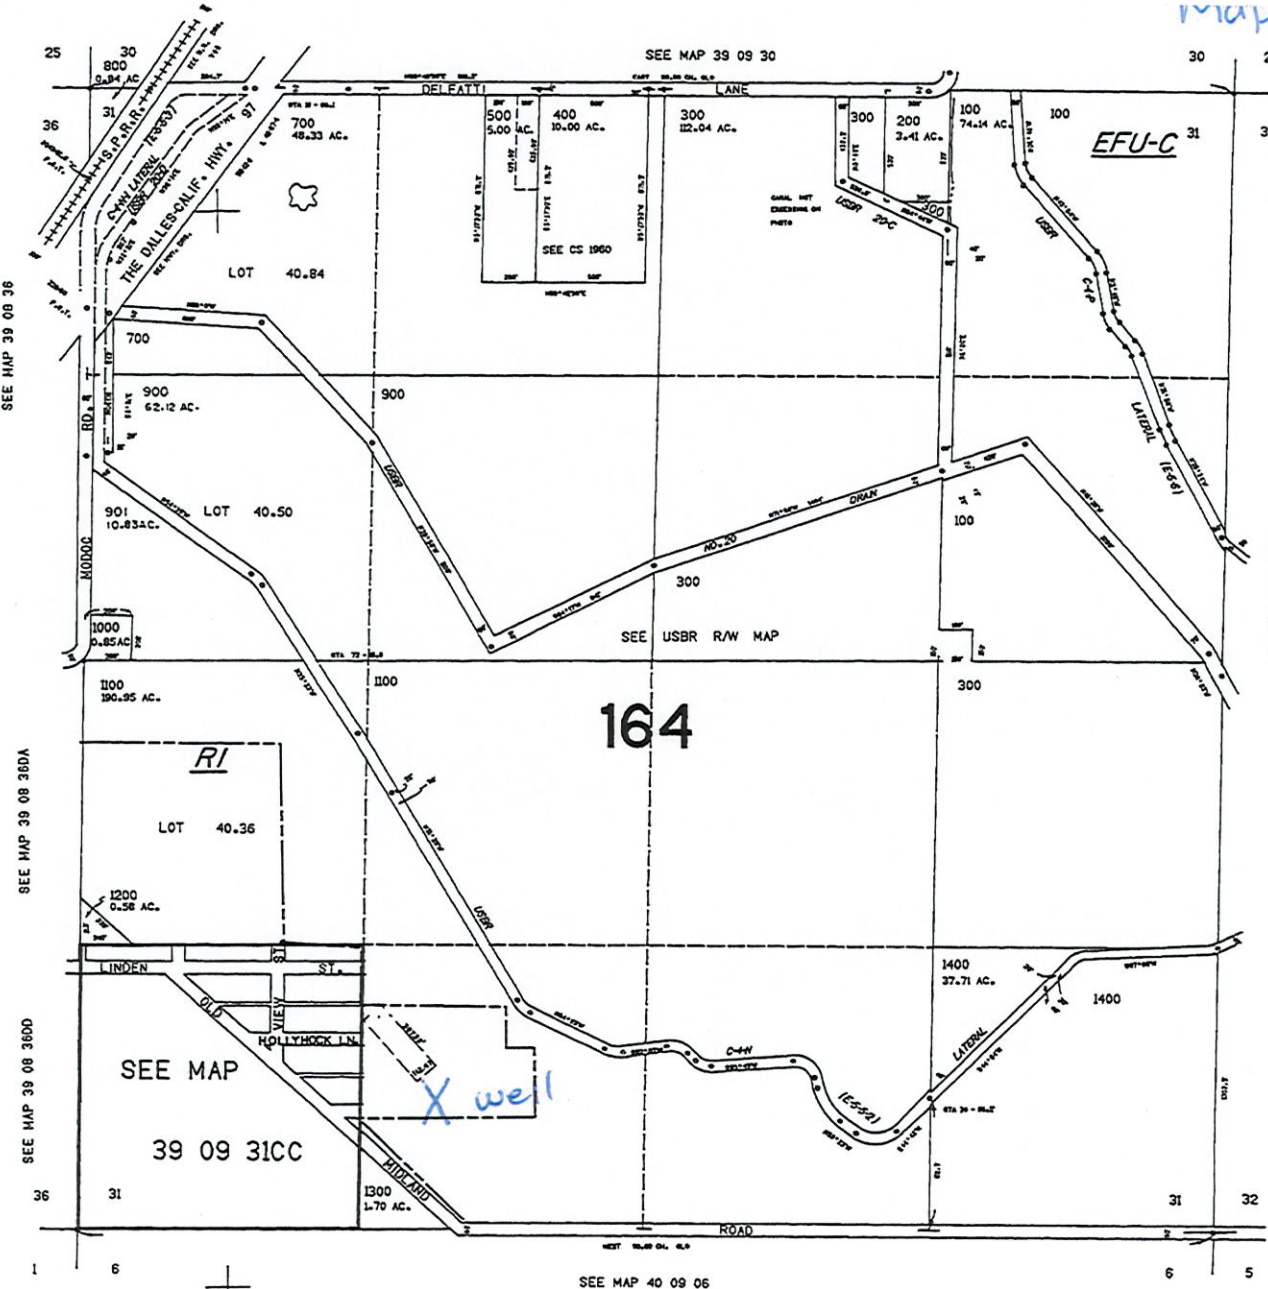

+ 175.000

CANCELLED NO.  
600

SEE MAP 39 09 32

164

Well location  
KLAM 51231  
42.1276  
-121.8092

SEE MAP 39 08 360A

SEE MAP 39 08 360D

+ 44.000

SEE MAP 40 09 06

+ 39 09 31  
& INDEX

RECEIVED

APR 26 2021

OWRD

NORTH  
T39S R09E  
SEC. 31

Tax lot  
300 NESE 40.00

Scale

1" = 880'


THIS MAP WAS PREPARED FOR  
ASSESSMENT PURPOSE ONLY

SECTION 31 T.39S. R.09E. W.M.  
KLAMATH COUNTY

1"=400'

MAP 2 OF 4

MAP CREATED 04/08/2021

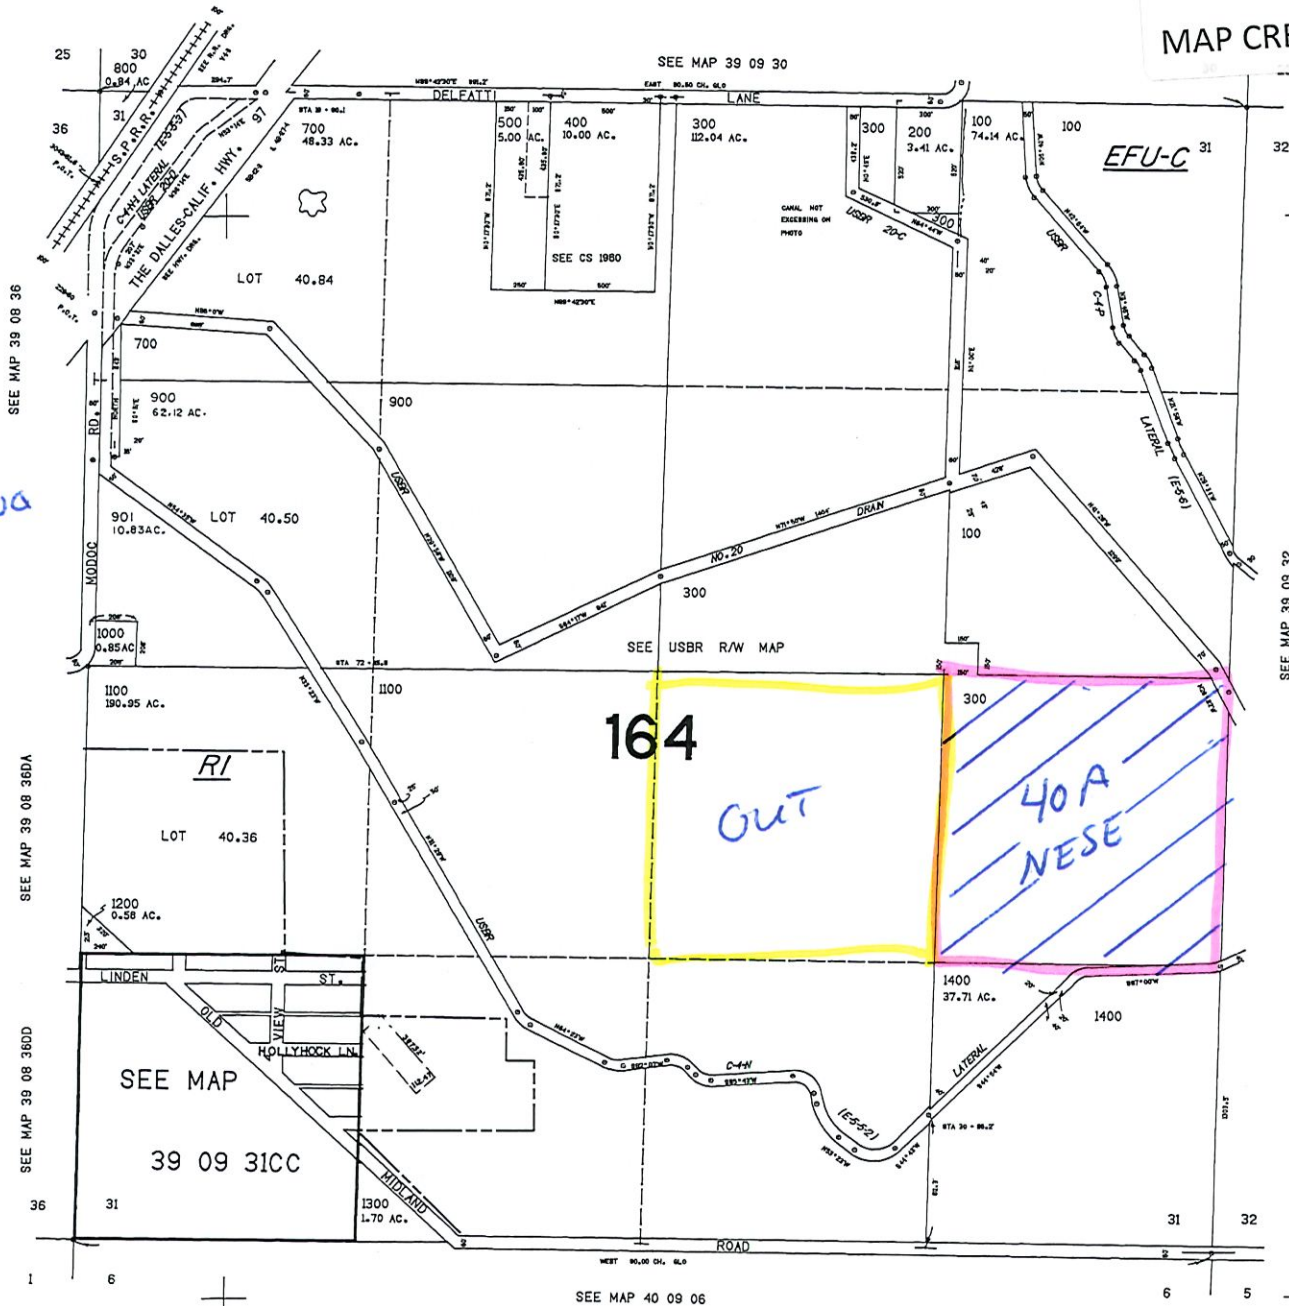

175.000  
CANCELLED NO.  
600

39 09 31  
& INDEX



T.40S. R.09E. W.M.  
KLAMATH COUNTY

MAP 21 OF 4

REVISED 08-03-2018  
THIS MAP WAS PREPARED FOR  
ASSESSMENT PURPOSE ONLY

MIDLAND 1" = 2000'

MAP CREATED 04/08/2021

NORTH


T 40S ROSE  
Index

Tax lot  
4500 SE 1/4  
130 Acres

Tax lot  
5400 SWSW  
40.00

RECEIVED  
APR 26 2021

OWRD

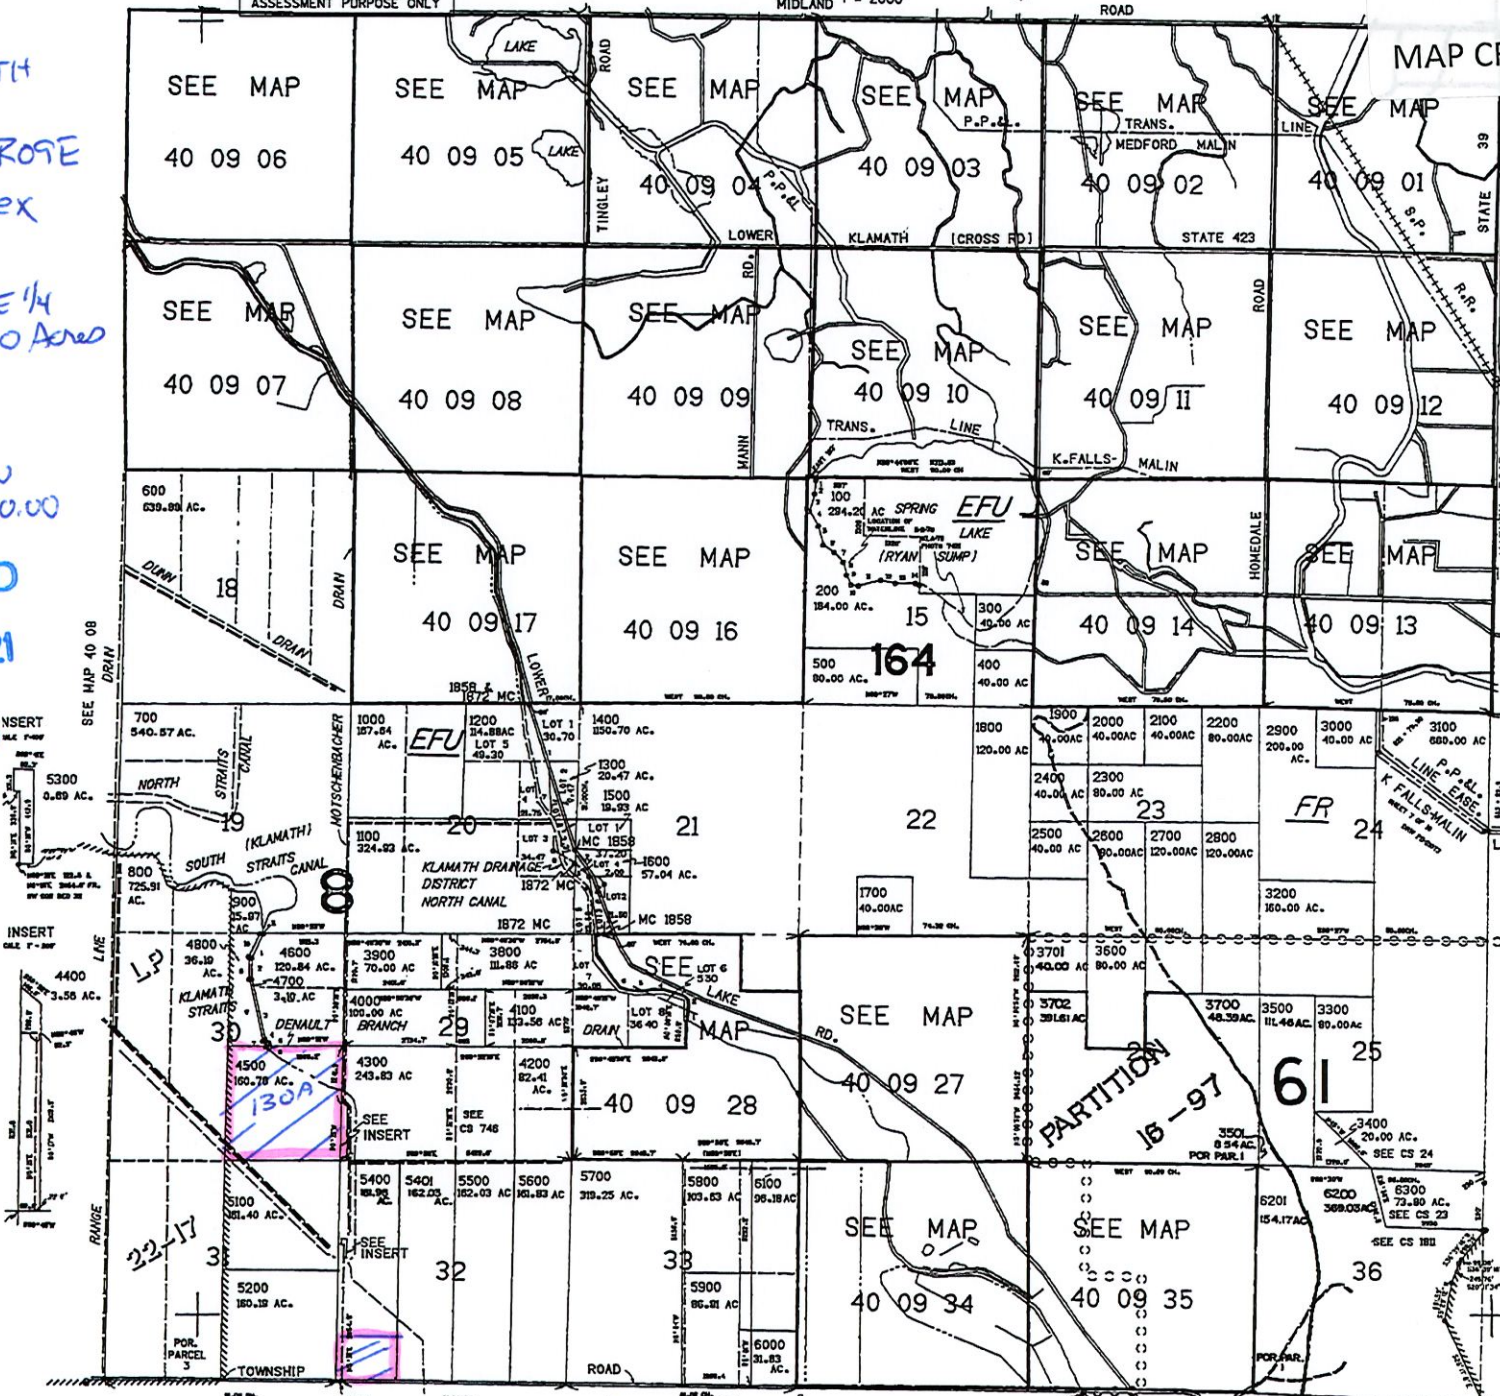

800M - 2100M  
2200M - 2300M  
2500M - 2600M  
2700M - 3500M  
3700M - 6200M  
6400M  
4900  
5000

CANCELLED NO.  
299 MI INCLUDES  
3500M, 3700M  
6200M  
6400  
4900  
5000

- 40 SWSW

40 09  
& INDEX