


REVISED 07-12-2018
THIS MAP WAS PREPARED FOR
ASSESSMENT PURPOSE ONLY

SECTION 23 T.41S. R.12E. W.M.
KLAMATH COUNTY
1" = 400'

MAP 1 - OF 3

MAP CREATED 03/19/2021

NORTH

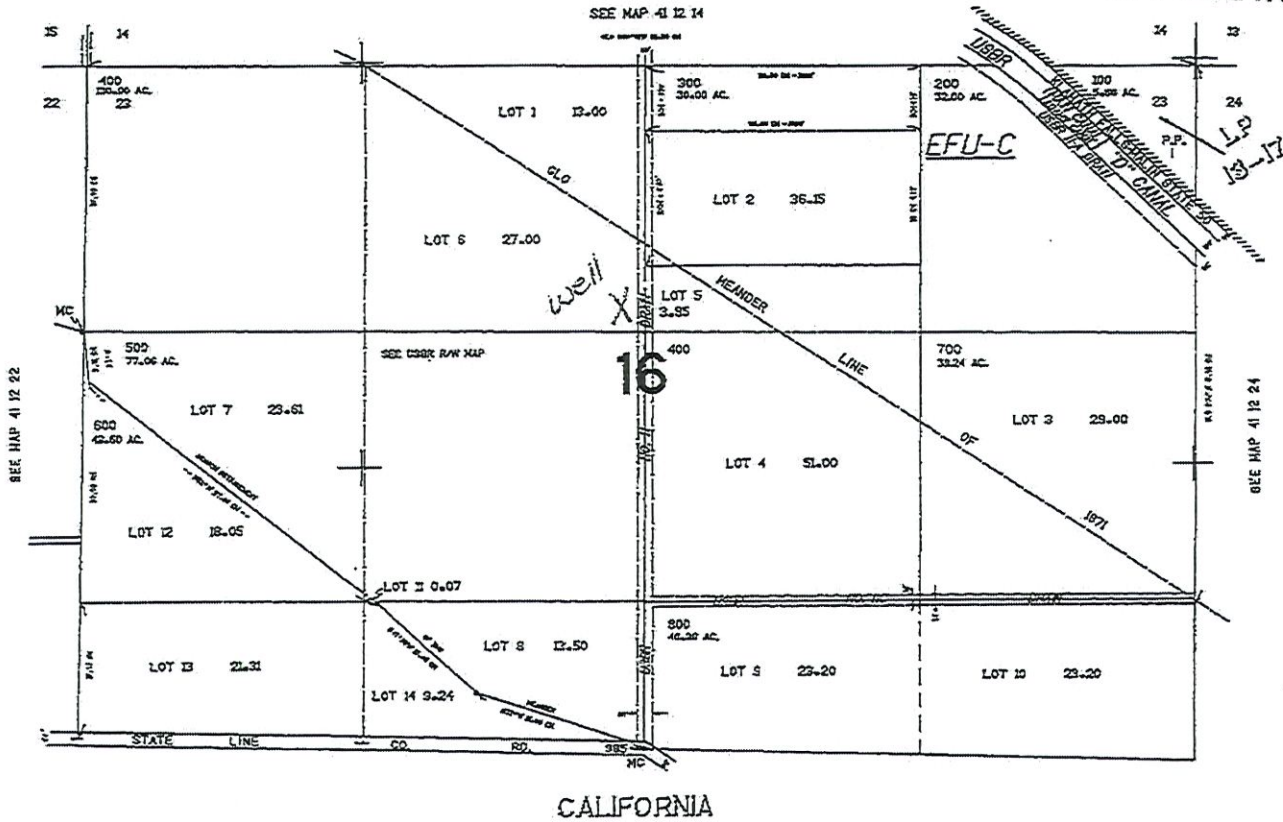

RECEIVED
APR 14 2021
OWRD

Well # 1
Well location
KLAM 10445
42.0029
-121.3796

Scale
1" = 880'


REVISED 07-12-2018
THIS MAP WAS PREPARED FOR
ASSESSMENT PURPOSE ONLY

SECTION 14 T.41S. R.12E. W.M.
KLAMATH COUNTY

1"=400'

MAP 2 OF 3

MAP CREATED 04/07/2021

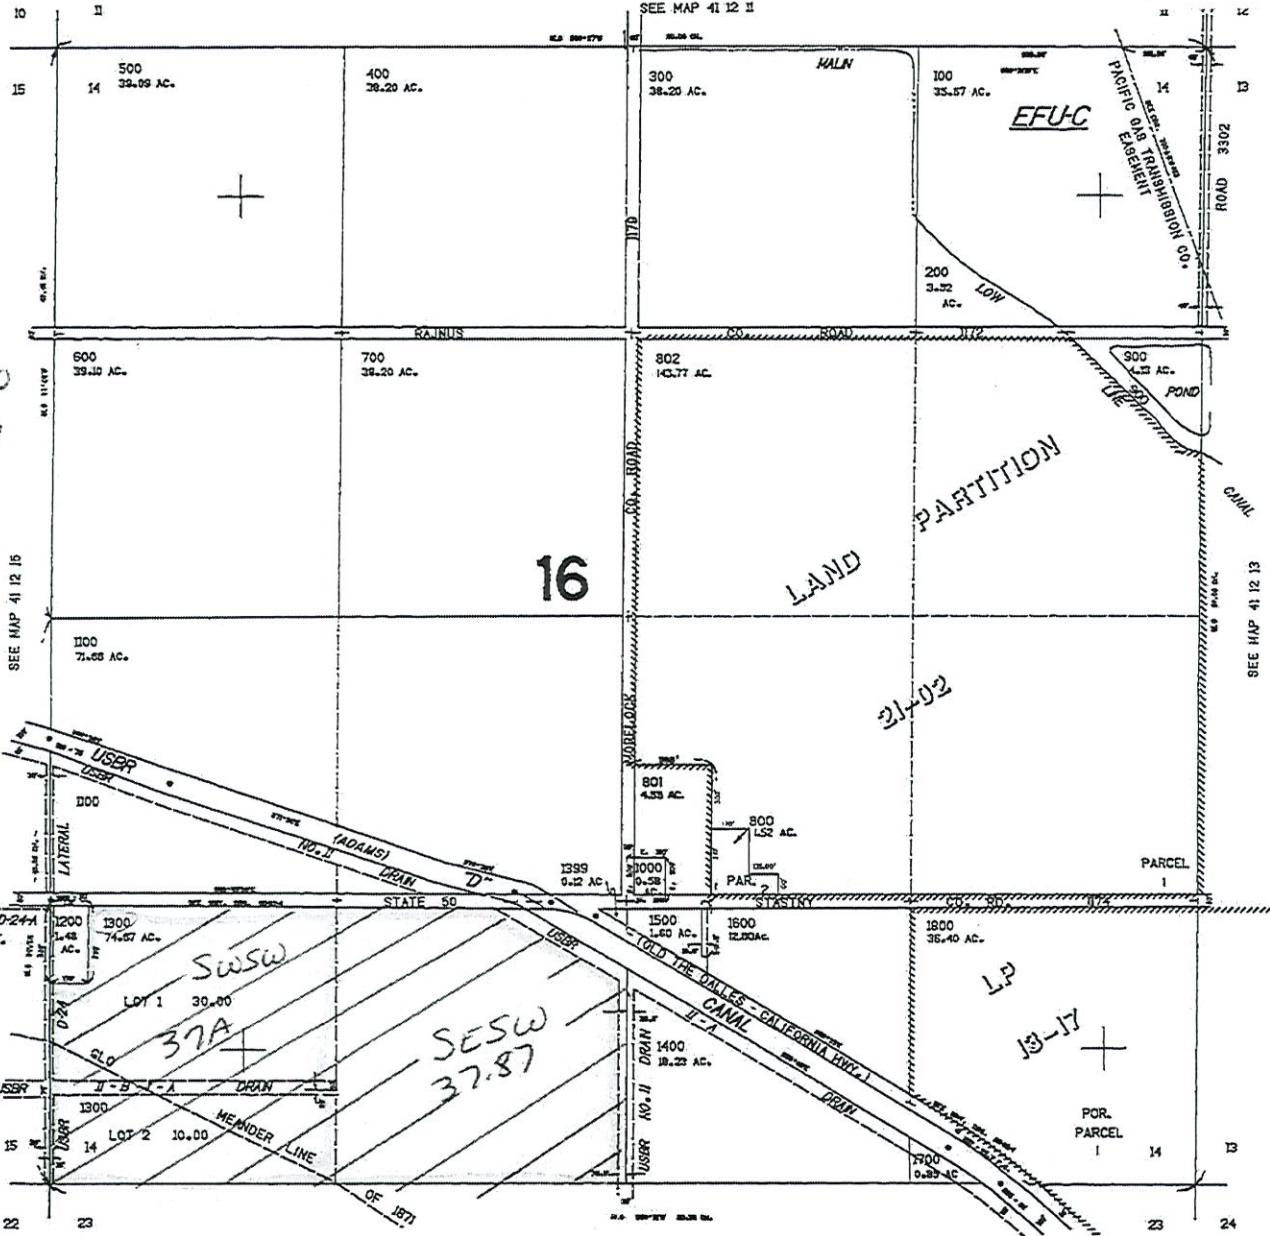

NORTH
THIS SIDE
SEC. 14

Tax lot
1300 SWSW 37.00
SESW 37.87

Scale
1" = 800'

RECEIVED
APR 14 2021
OWRD

RECEIVED
APR 14 2021
OWRD

SEE MAP 41 12 23

41 12 14

