


T.13&14 S.R.5 W.W.M.

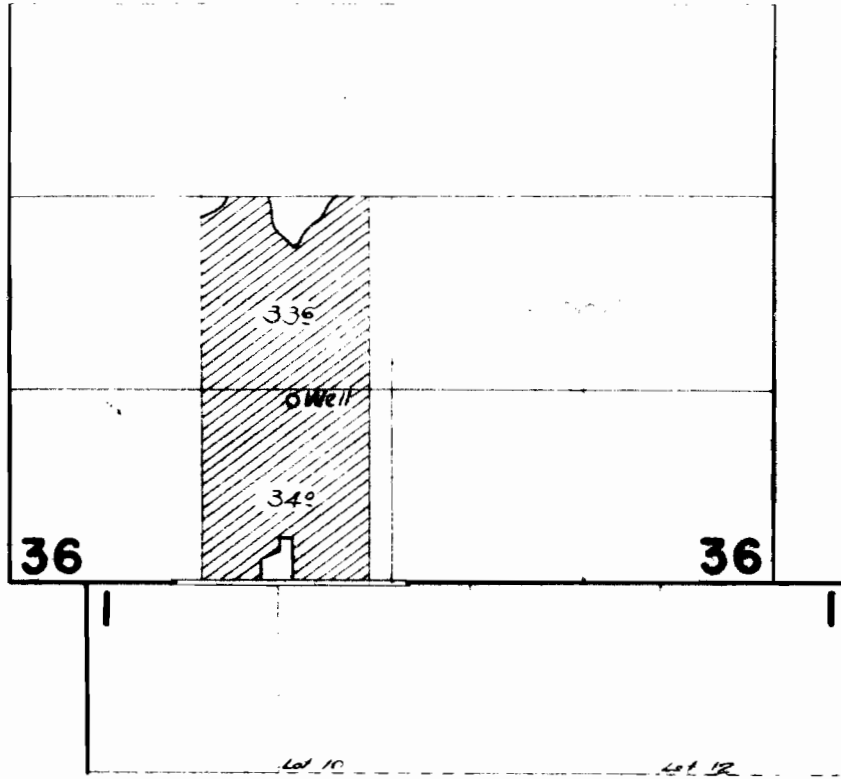

FINAL PROOF SURVEY  
UNDER

Application No. **G-2027** Permit No. **6-1865**  
IN NAME OF

**IVAN M. HORNING**

Surveyed *April 24 1963*, by *C. Baker*