

REVISED 10-22-2019

THIS MAP WAS PREPARED FOR ASSESSMENT PURPOSE ONLY

SECTION 08 T.40S. R.10E. W.M. KLAMATH COUNTY


1" = 400'

MAP 2 OF 5

MAP CREATED 4/22/2021

1
NORTH
T40S R10E
SEC 8
Tax lot
1000 NWSW 32.00
SWSW 8.42
NESW 5.00
SESW 3.00

Scale
1" = 880'

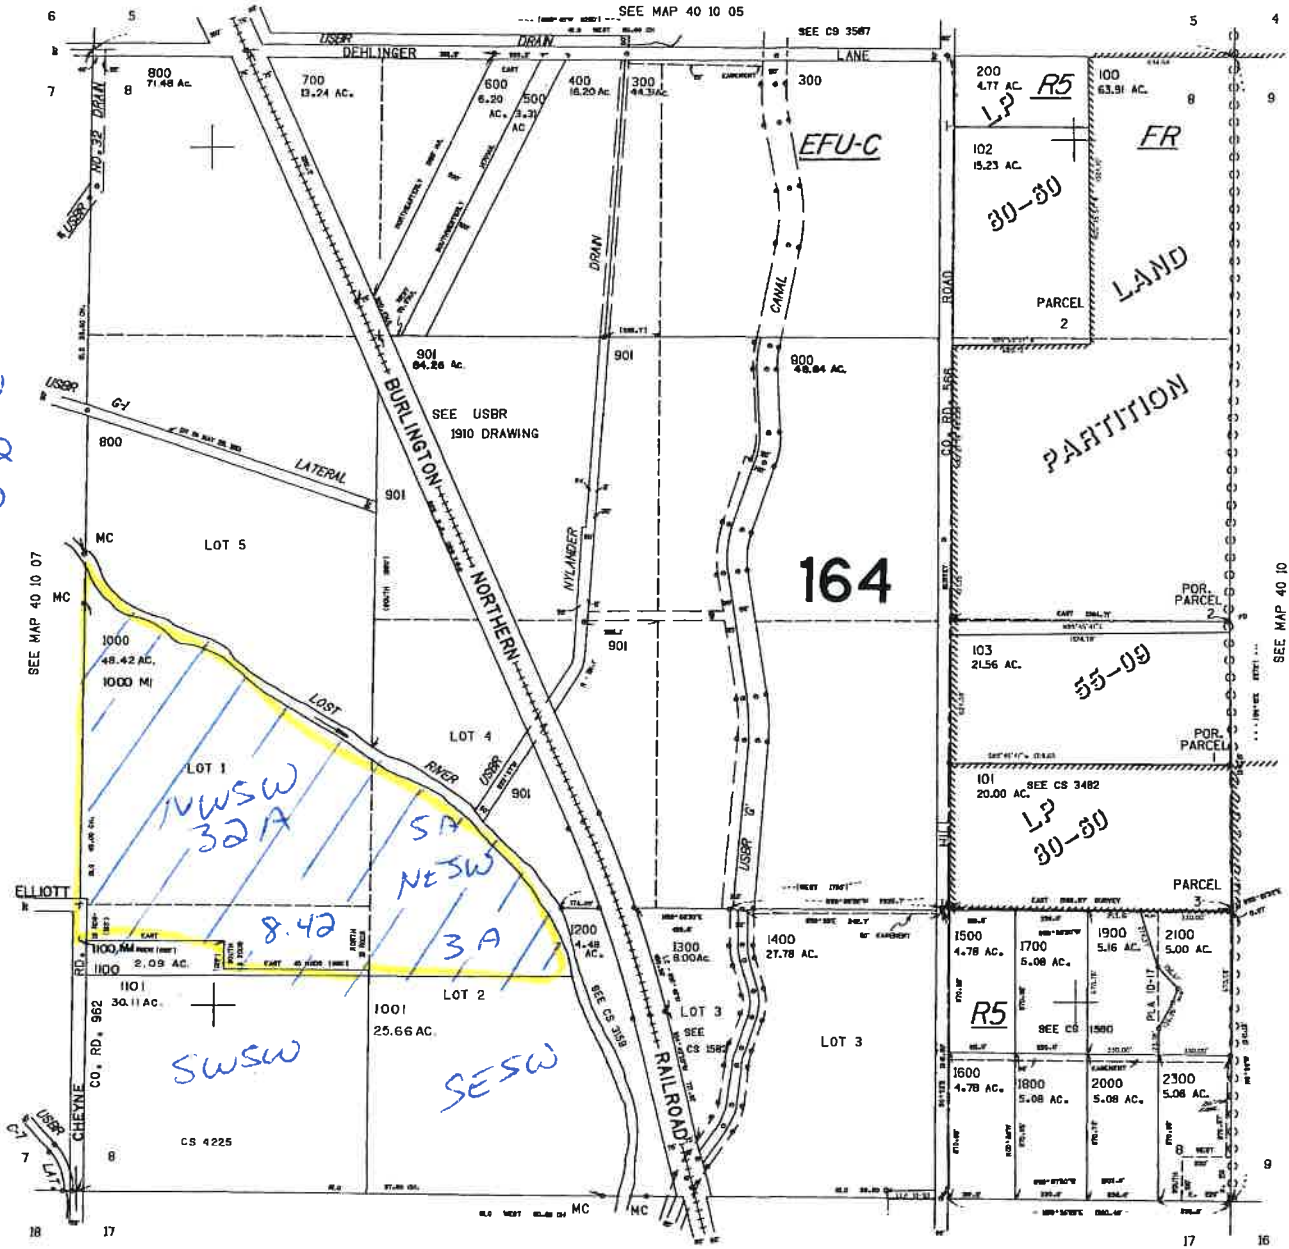

CANCELLED NO. 2200

SEE MAP 40 10 10

180.000

SEE MAP 40 10 17

SECTION 17 T.40S. R.10E. W.M.
KLAMATH COUNTY

MAP 3 OF 5


REVISED 07-01-14
THIS MAP WAS PREPARED FOR
ASSESSMENT PURPOSE ONLY

1"=400'

MAP CREATED 4-22-2001

NORTH
T40S R10E
SEC 17
Tax 800
NE1/4 20.00
NW1/4 31.00
SW1/4 37.00
SE1/4 29.31

Scale
1" = 880'

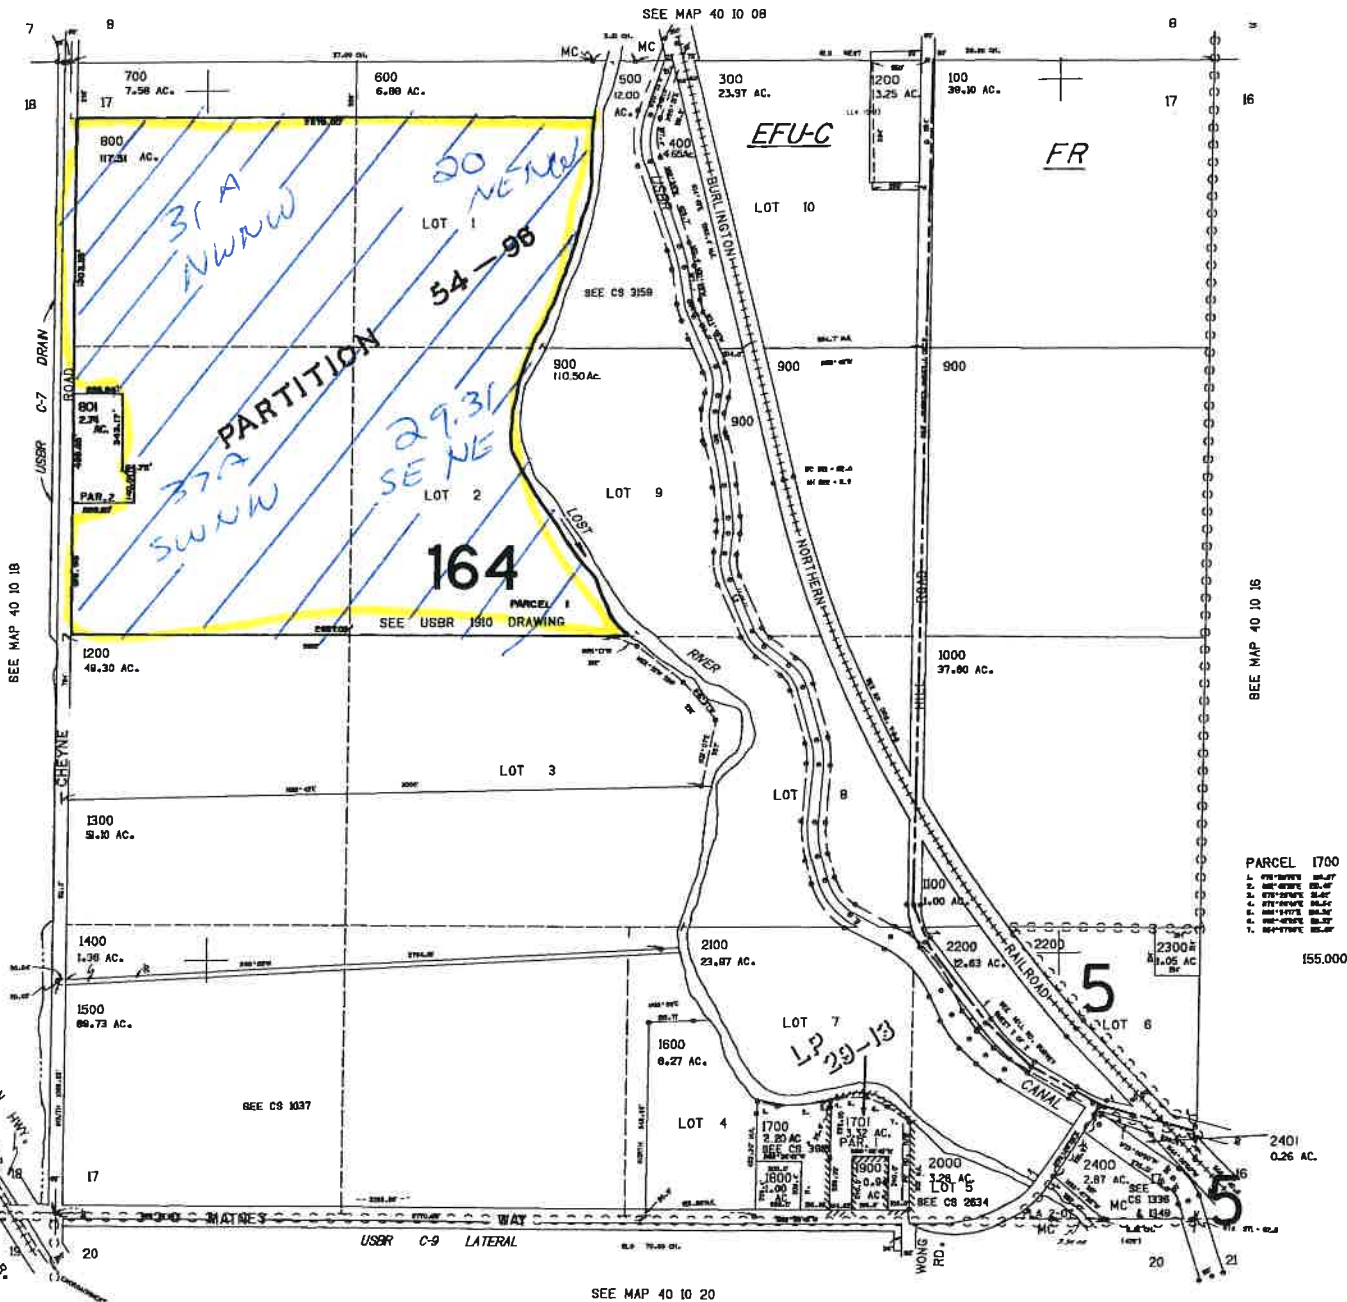

PARCEL 1700

0018100

40 10 17

REVISED 1-4-12


THIS MAP WAS PREPARED FOR ASSESSMENT PURPOSE ONLY

SECTION 18 T.40S. R.10E. W.M. KLAMATH COUNTY

1"=400'

MAP 4 OF 5

MAP CREATED 4/22/2021

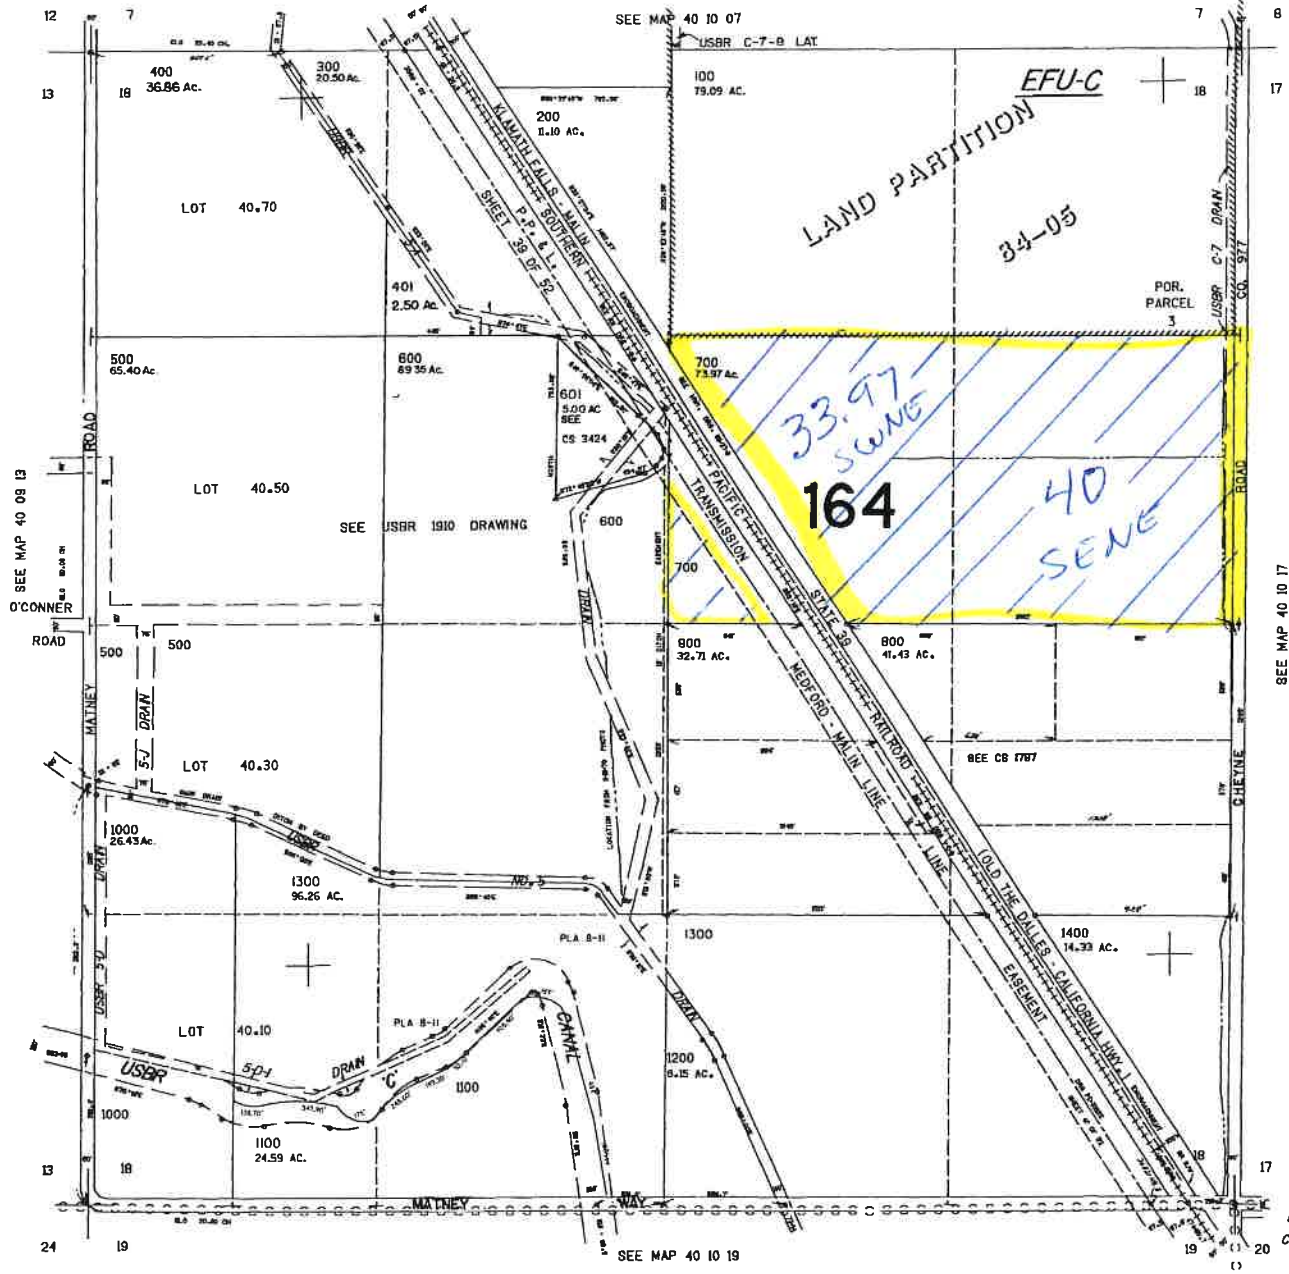

NORTH

T40S R10E
SEC 18

Tax lot
700 SWNE
33.97
SENE 40.00

Scale
1" = 880'

40 10 18

1578.000


REVISED 9-15-08
THIS MAP WAS PREPARED FOR
ASSESSMENT PURPOSE ONLY

SECTION 35 T.40S. R.10E. W.M.
KLAMATH COUNTY

1"=400'

MAP 5 OF 5

MAP CREATED 4-22-2021

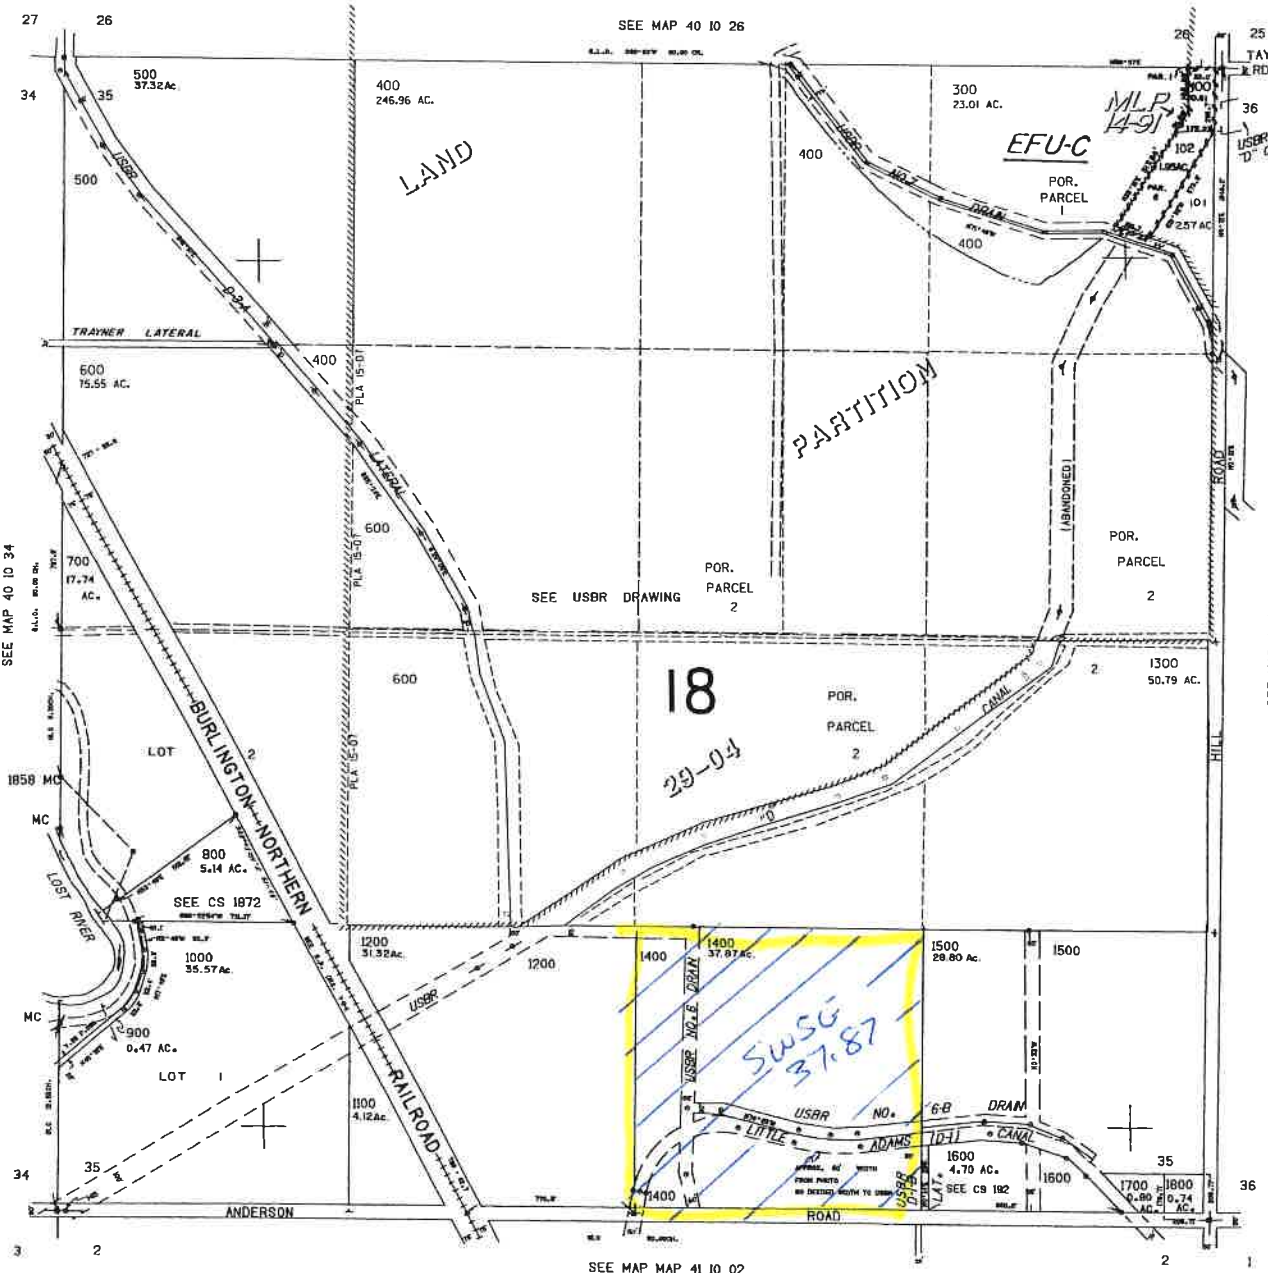

NORTH
T40S R10E
SEC 35
Tax lot
1400 SWSE
37.87

Scale
1"=880'

CANCELLED NO.
200
1301

138.000

1897.000

40 10 35

REVISED 10-22-2019

THIS MAP WAS PREPARED FOR ASSESSMENT PURPOSE ONLY

SECTION 08 T.40S. R.10E. W.M. KLAMATH COUNTY
1" = 400'


MAP _____ OF _____

MAP CREATED 04-22-2021

NORTH
T40S R10E
SEC 08

CANCELLED NO. 2200

RECEIVED
MAY 13 2021
OWRD

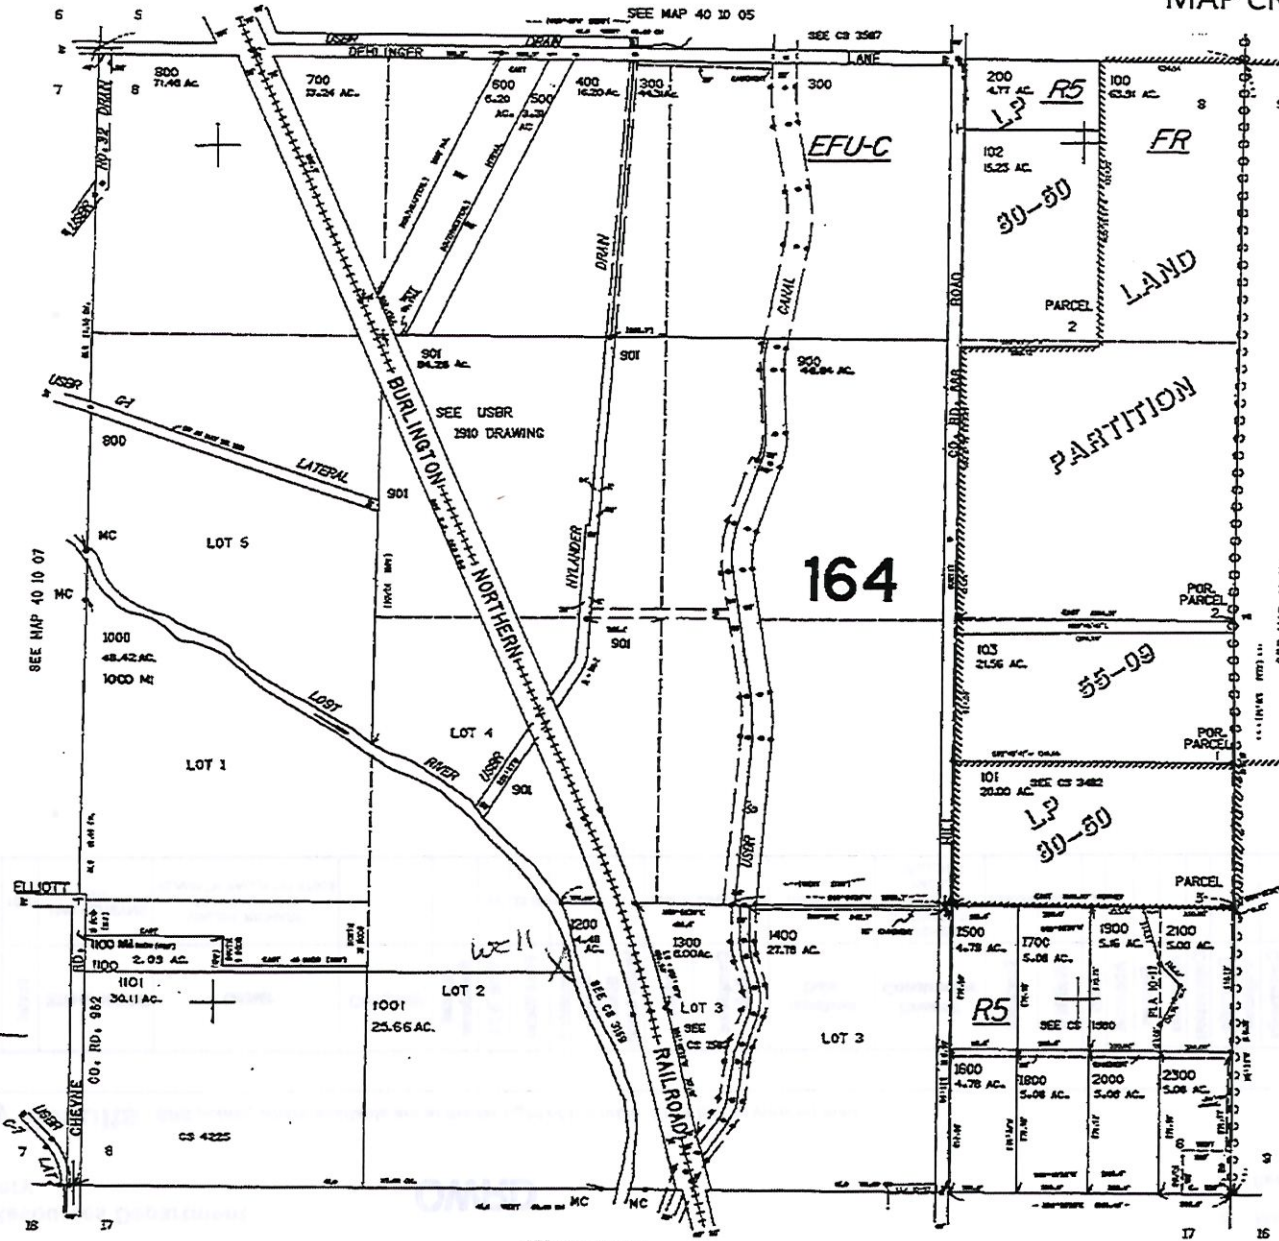

Well location
Klam 52697
42.1000
-121.6709
OR
1100' NORTH +
2186' EAST FROM SE CORNER Sec 8.

40 10 08

RECEIVED