


# Water Right Application Map

T 15 S R 11 E Section 31 WM

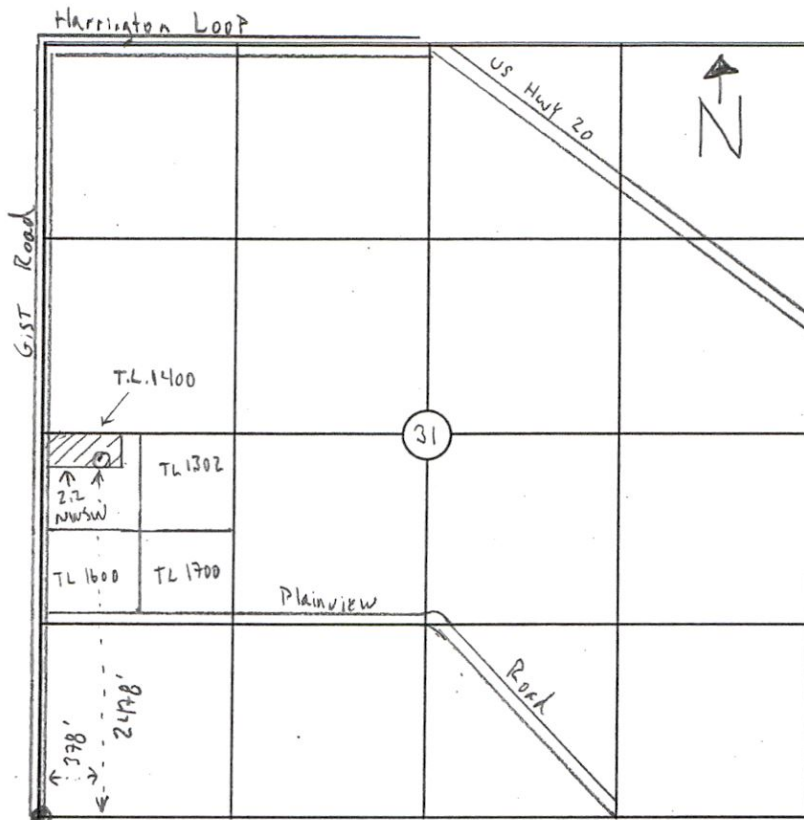

1 inch = 1320 feet



Well Location: 2478 Feet (N, S)  
and 378 Feet (E, W) of SW Corner of 31

Applicaiton Map  
IN NAME OF:

Clayton Strasser

Date: 6-28-19

RECEIVED  
JUL 17 2019  
OWRD



7-18841