



Total Irrigated Acres:

In Section 13:
SW-NW = 34^o
NW-SW = 22^o
SW-SW = 40^o

In Section 24:
NE-NW = 4^o

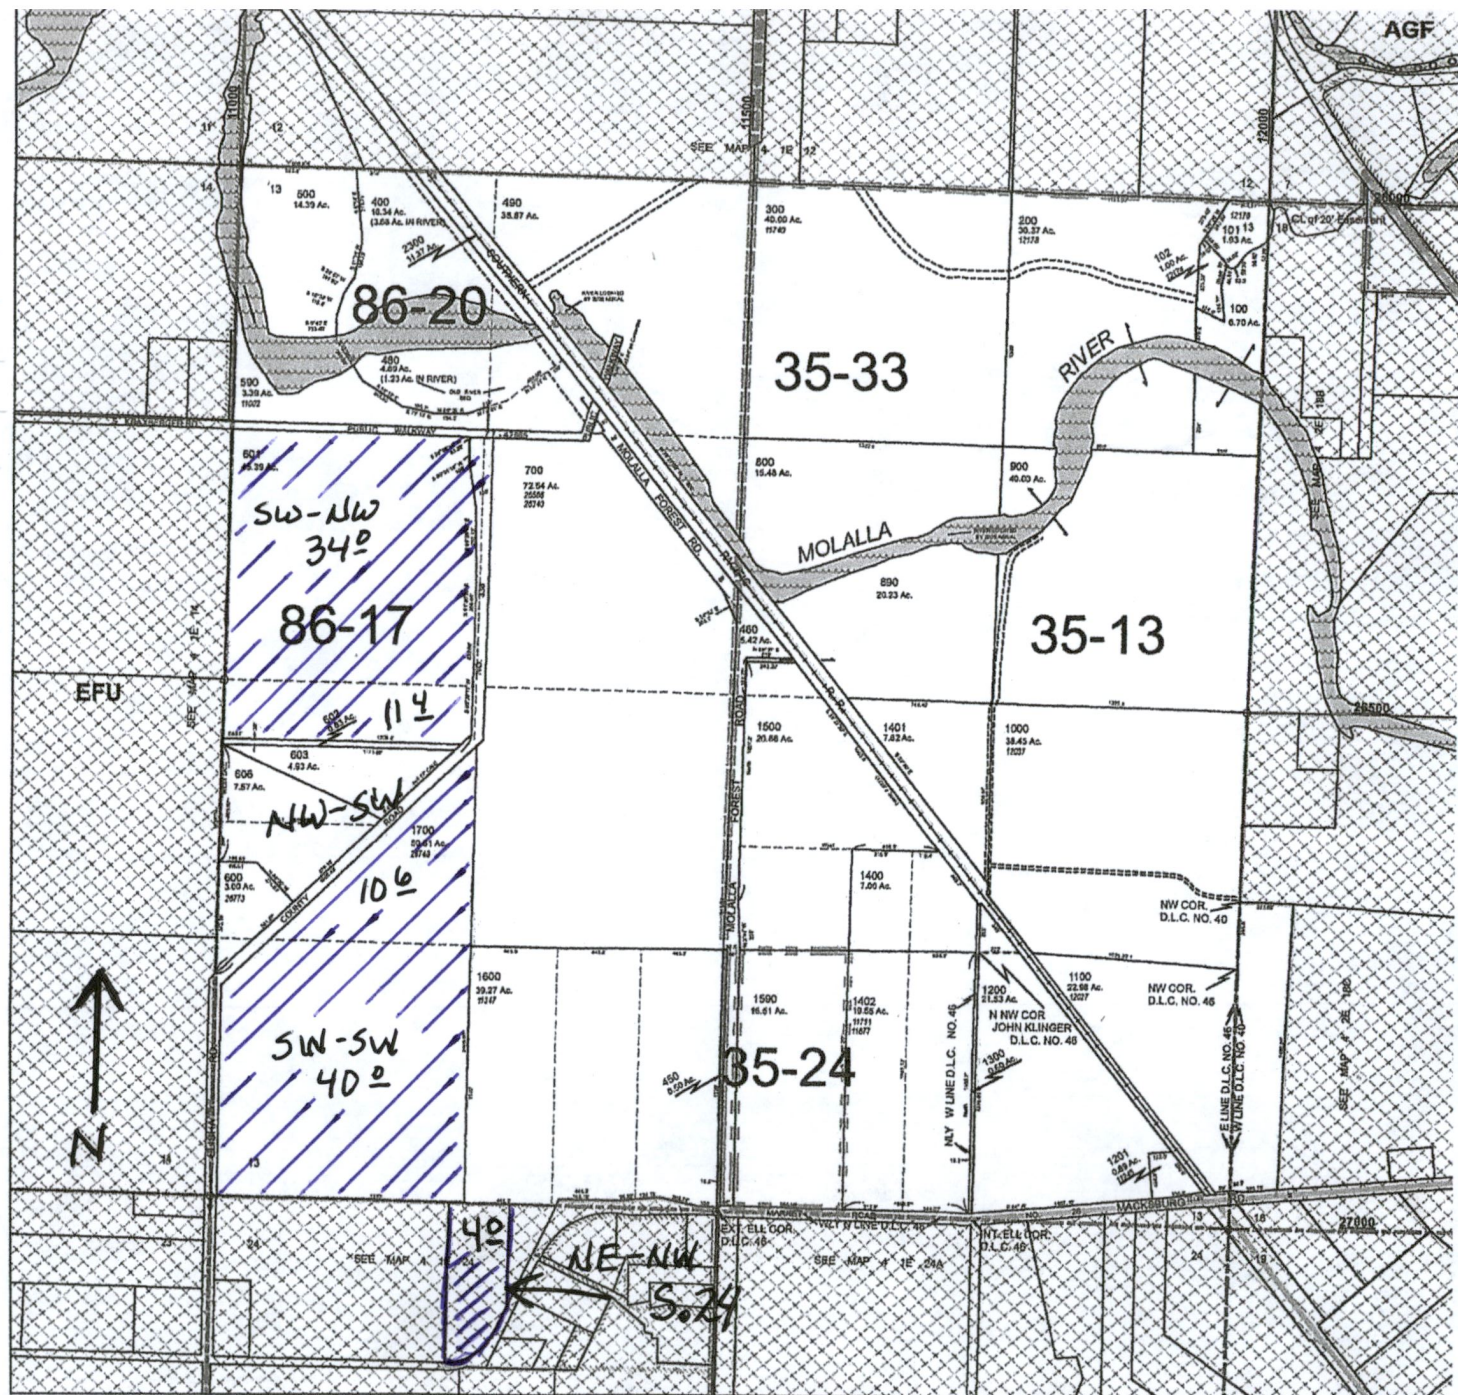

RECEIVED
JAN 23 2020
OWRD

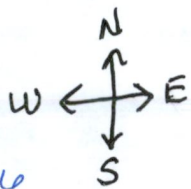

G-10906

T 4S R 1E
S. 13

WELL LOCATION

1" = 1000'

Well 1 Existing

1310' North 55° EAST



Well 2 Proposed

2320' North 40° EAST

Well 3 Proposed

2320' North 64.5° EAST

ALL FROM SWL Corner
Section 13

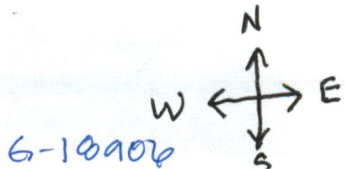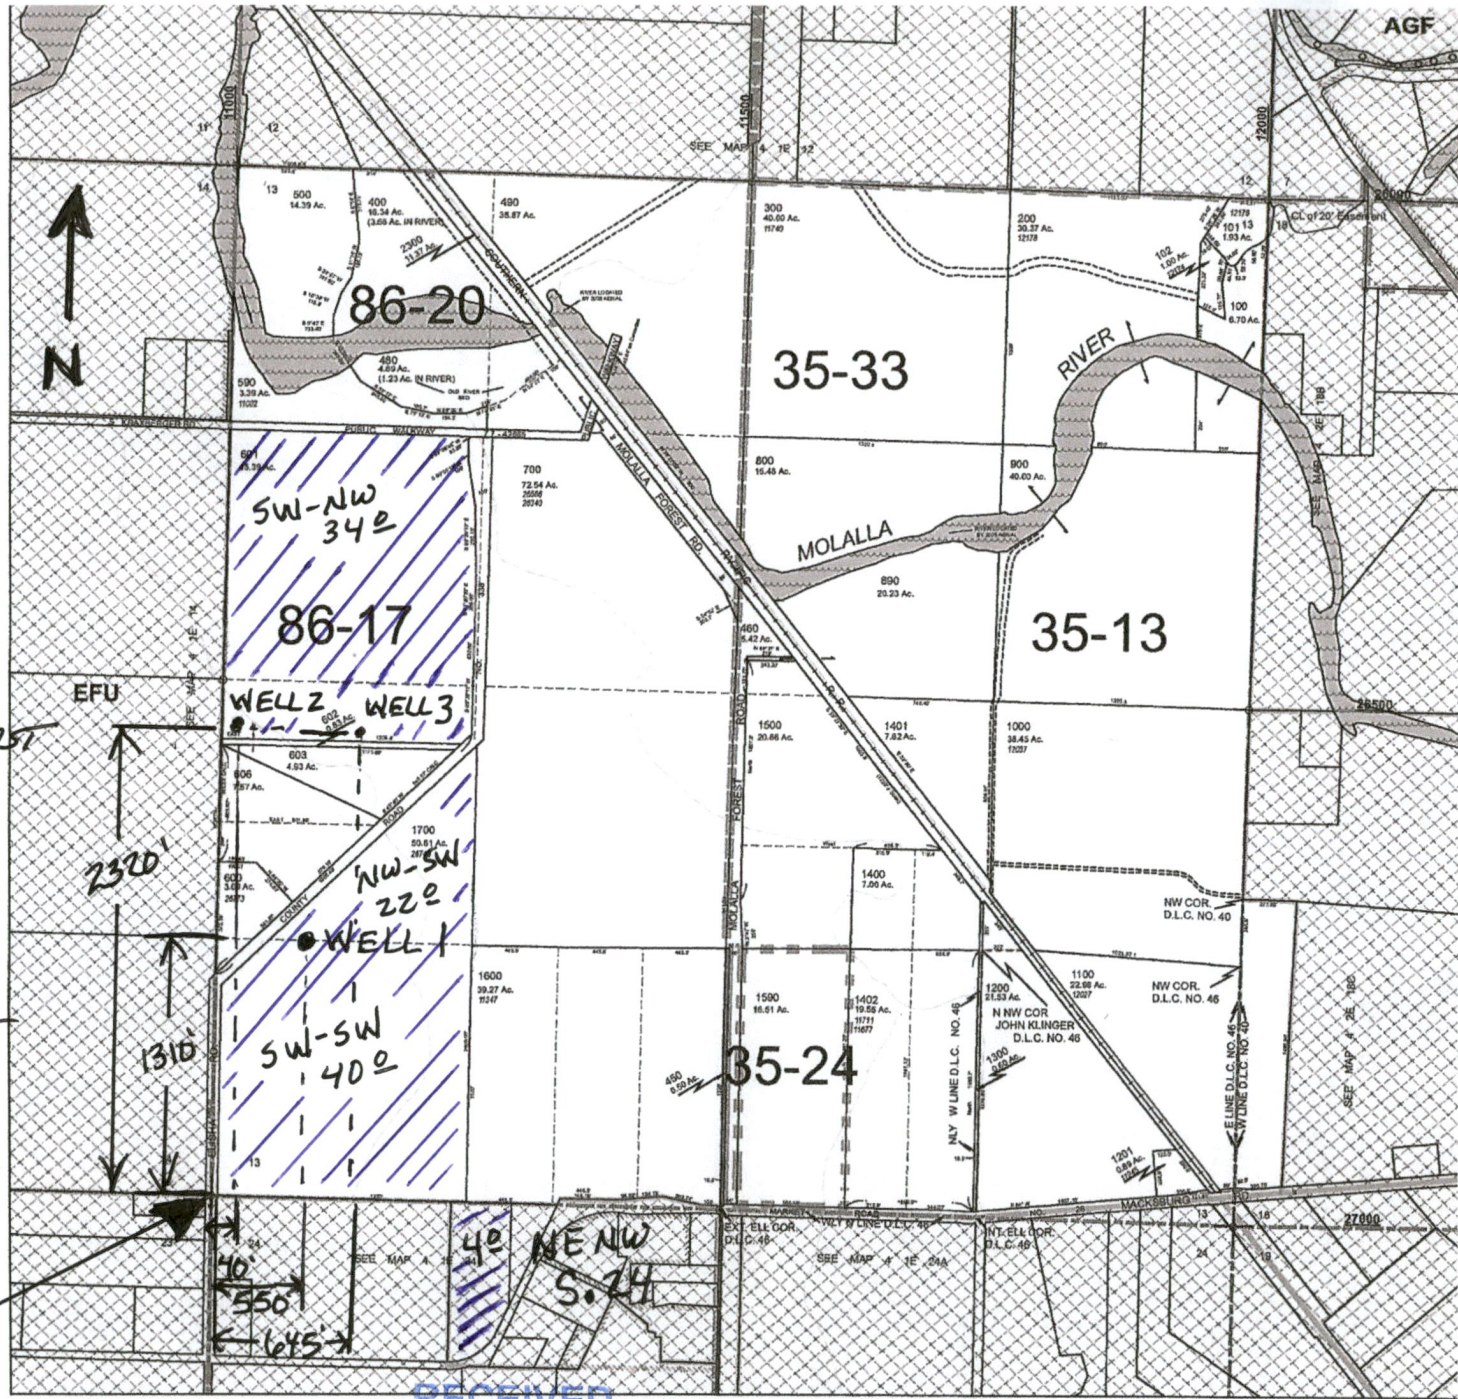

RECEIVED
JAN 23 2020

OWRD