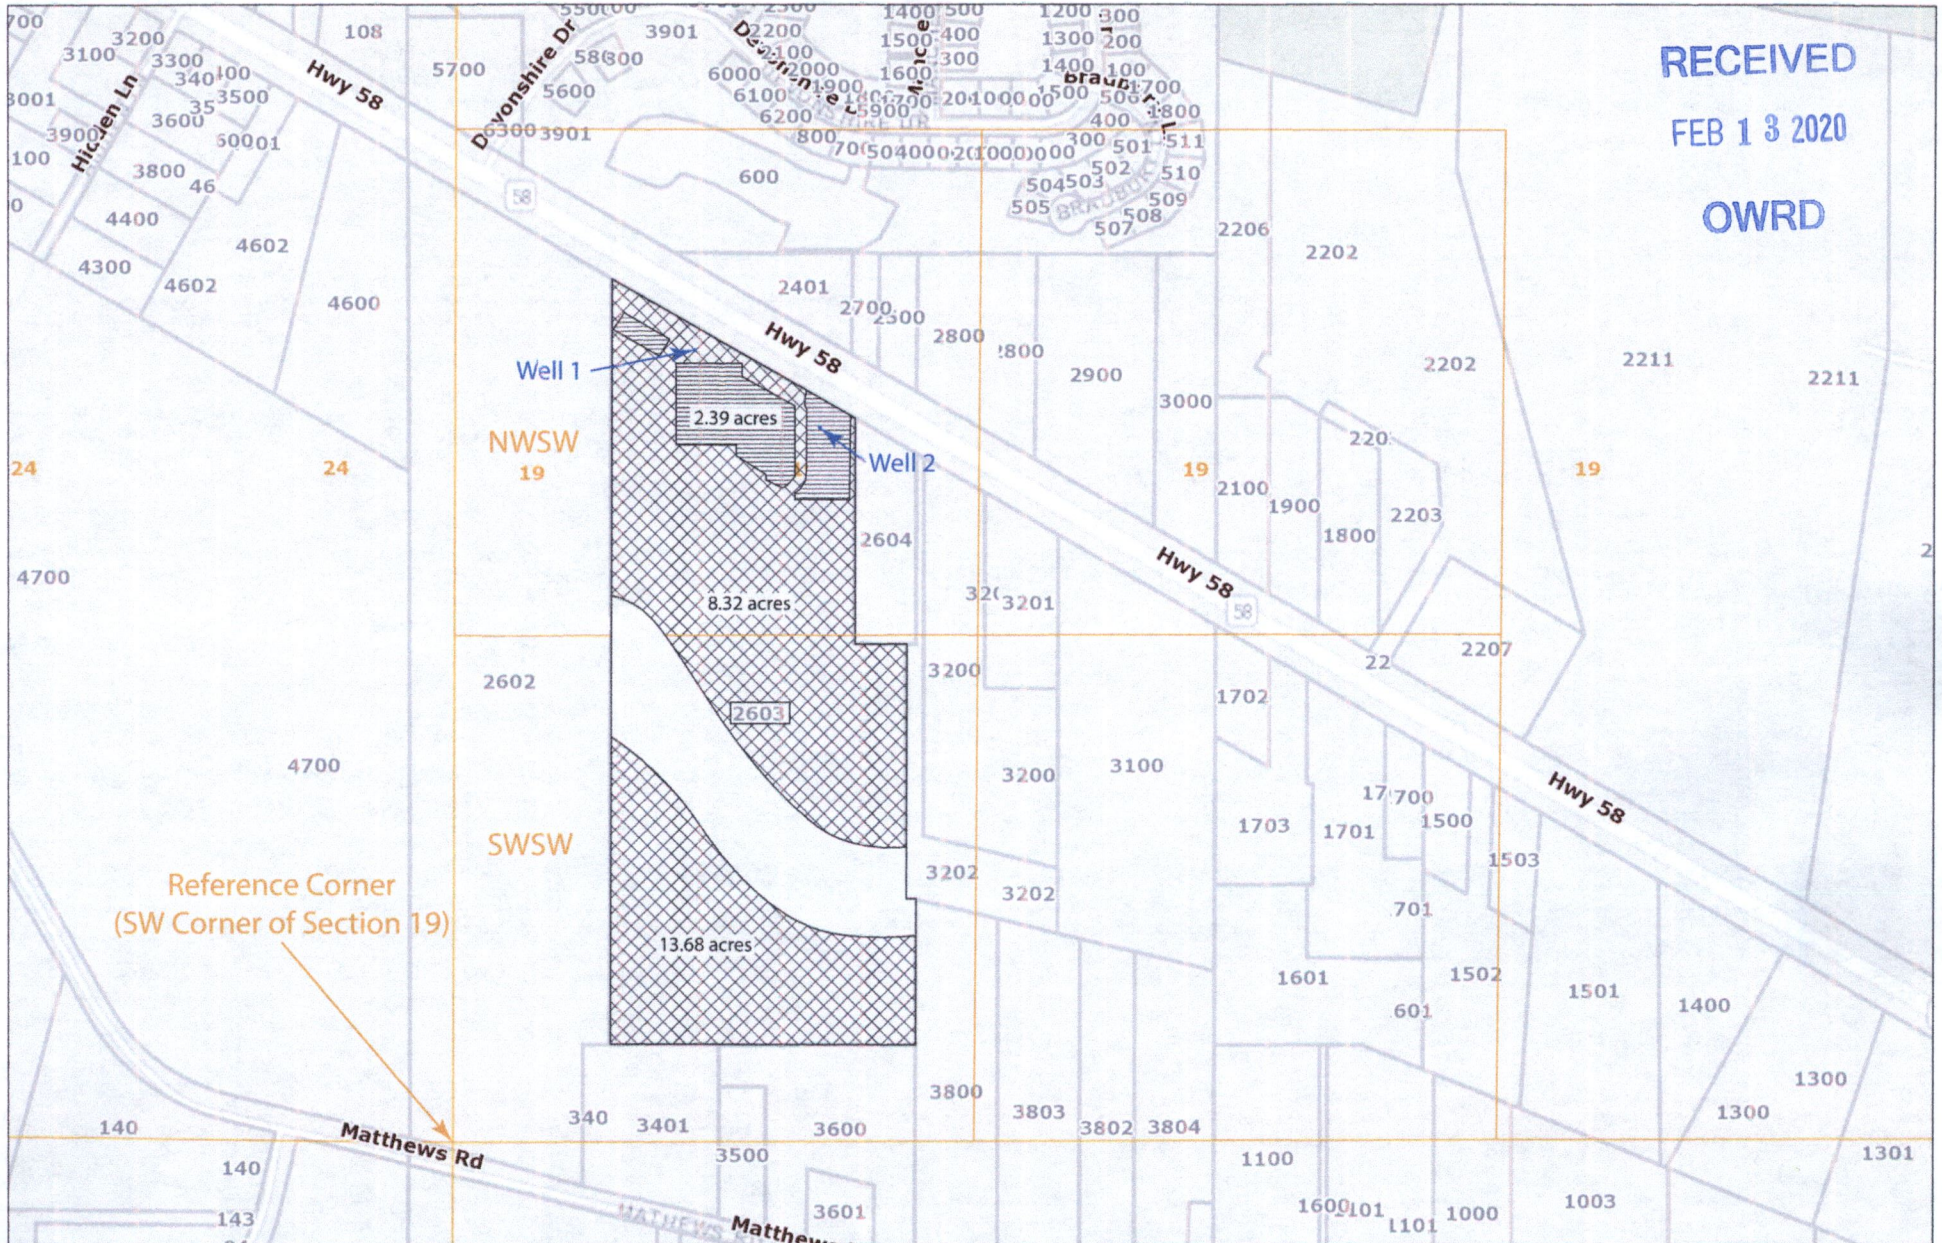

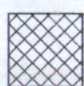
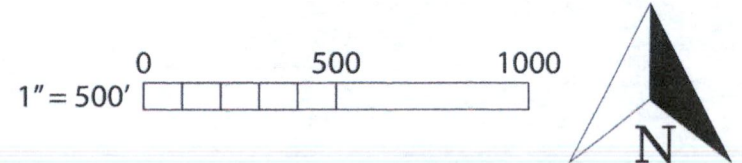


RECEIVED
FEB 13 2020
OWRD



-  = Container Area
-  = In-ground Area

Well 1 is 2084 ft N and 632 ft E of SW Corner of Section 19
Well 2 is 1886 ft N and 945 ft E of SW Corner of Section 19
Property Location 18-02-19-00-02603



6-10914

