

1" = 1320'

Tax Lot:


Township 9 South, Range 4 West, Section 4, 8 & 9, Tax Lot 1200 ~~700~~ 700

RECEIVED

FEB 25 2021



100 ~~700~~ OWRD

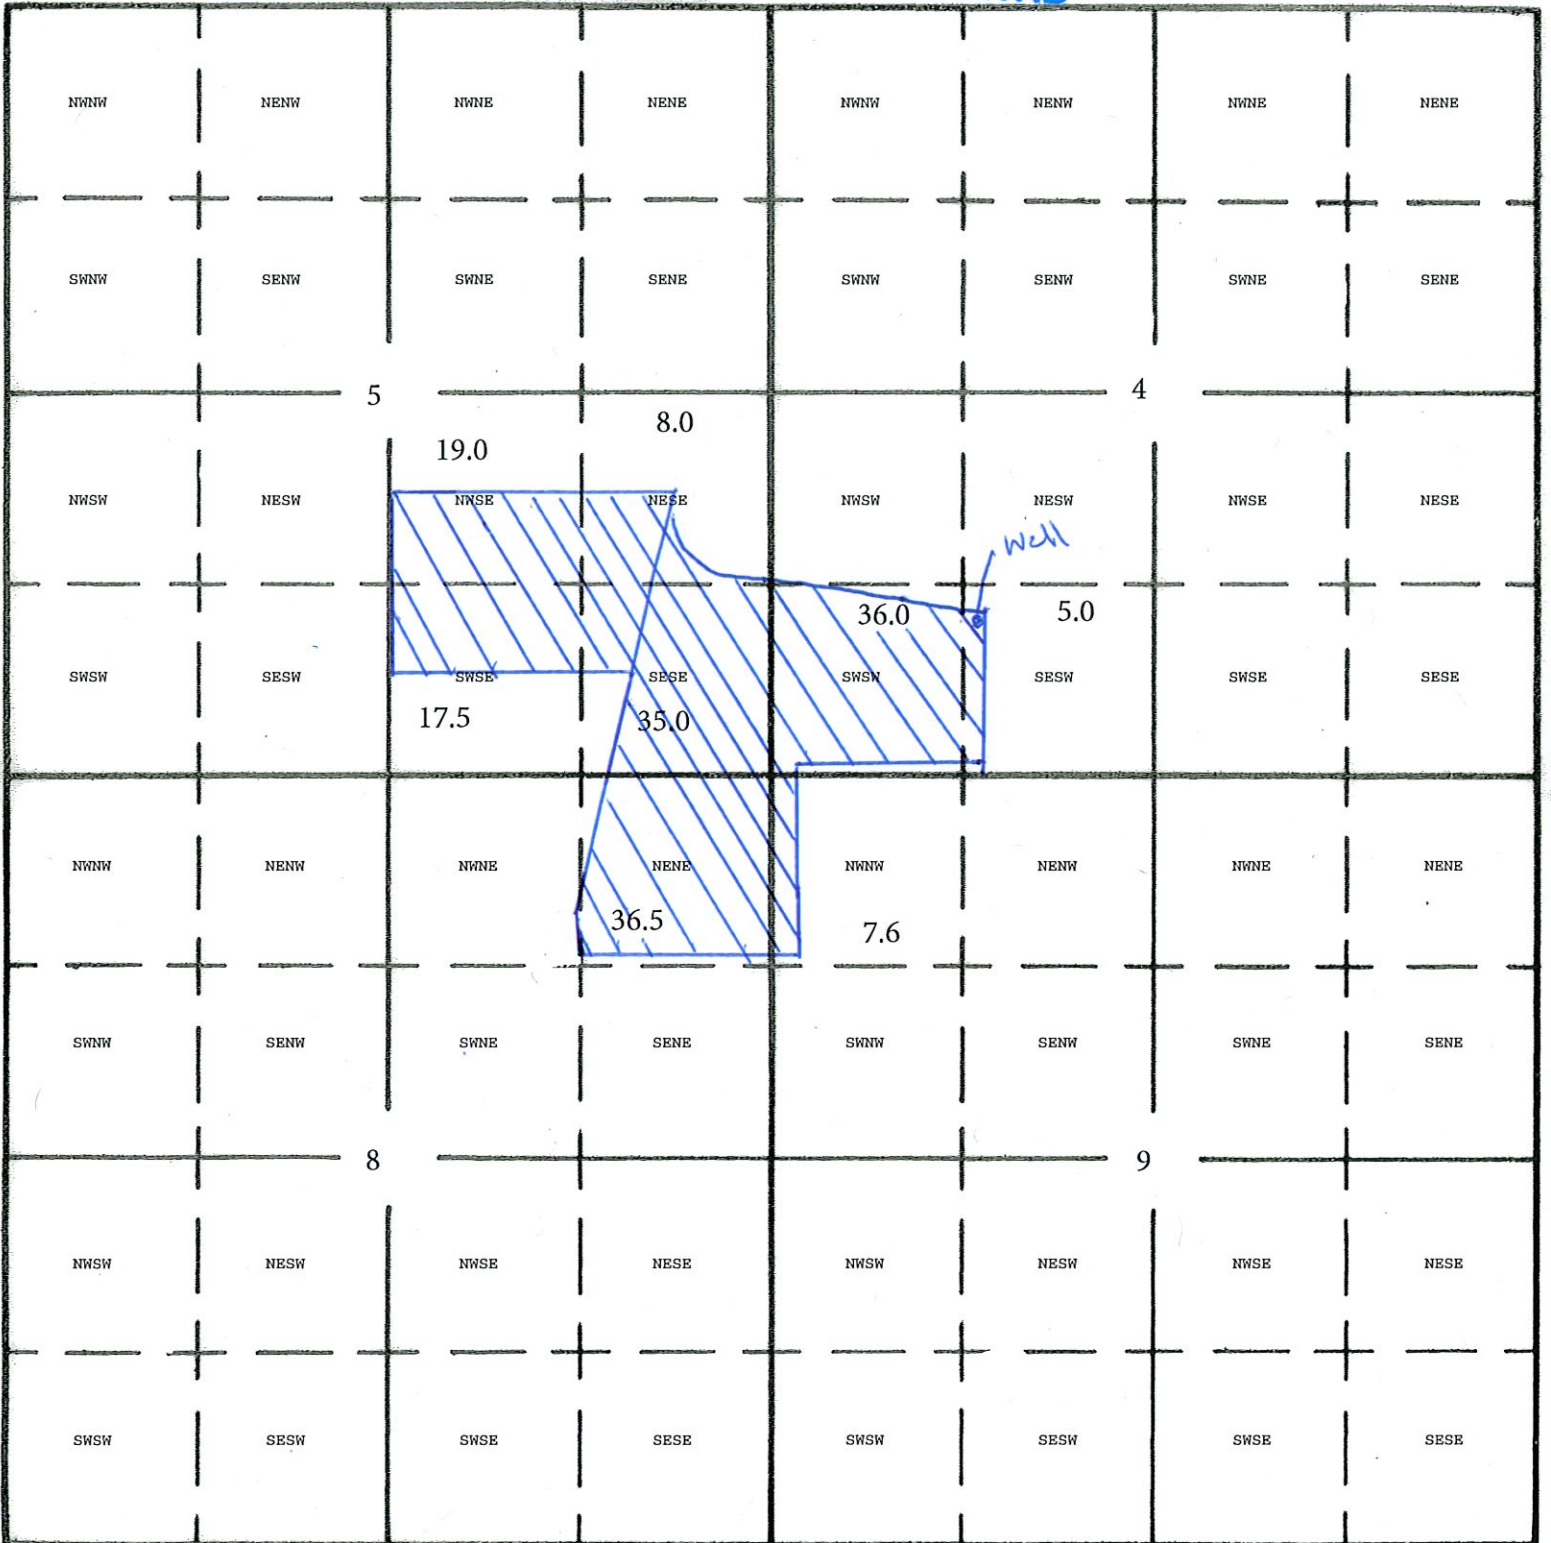

South

Well 1: 1,100 Feet North and 1,400 Feet East from SW Corner Section 4

164.6 Acres of Irrigation

*Don D. McKee*