




G-10687

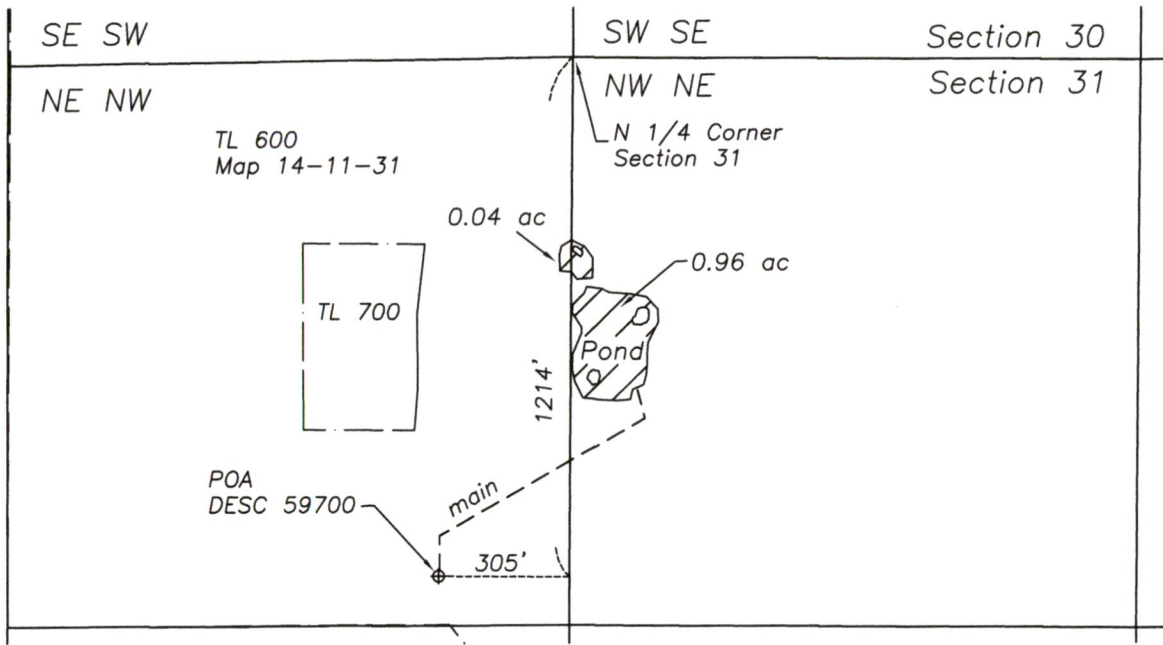

# Application Map Pond Maintenance

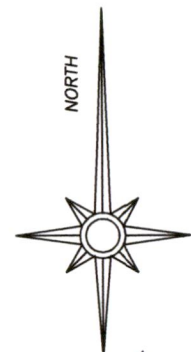

*May 7/2018*

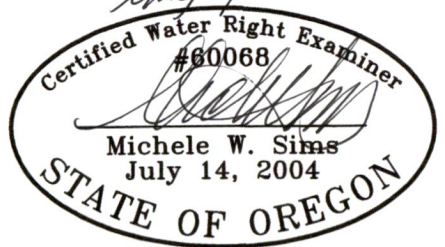



Renewal date: 6/30/2018

Section 31  
T14S R11E W.M.  
Deschutes Co., OR

Tax Lot 600  
Map 14-11-31

Proposed Point of Appropriation  
NE NW Section 31, T14S R11E, W.M.  
1214' South and 305' West from North 1/4 Corner  
Section 31

RECEIVED  
 MAY 14 2018  
 OWRD

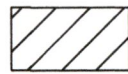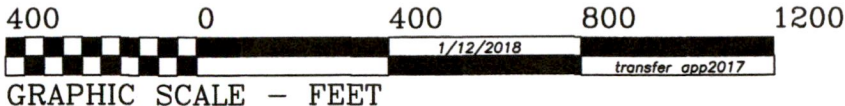

Place of use: year-round pond maintenance

This map is for the purpose of identifying the location of the water right. It is not intended to provide legal dimensions or locations of property ownership lines.

6-100082


THIS WAS PREPARED FOR  
VENT PURPOSE ONLY

SECTION 31 T.14S. R.11E. W.M.  
DESCHUTES COUNTY

14 11 31  
& INDEX

14

1" = 400'

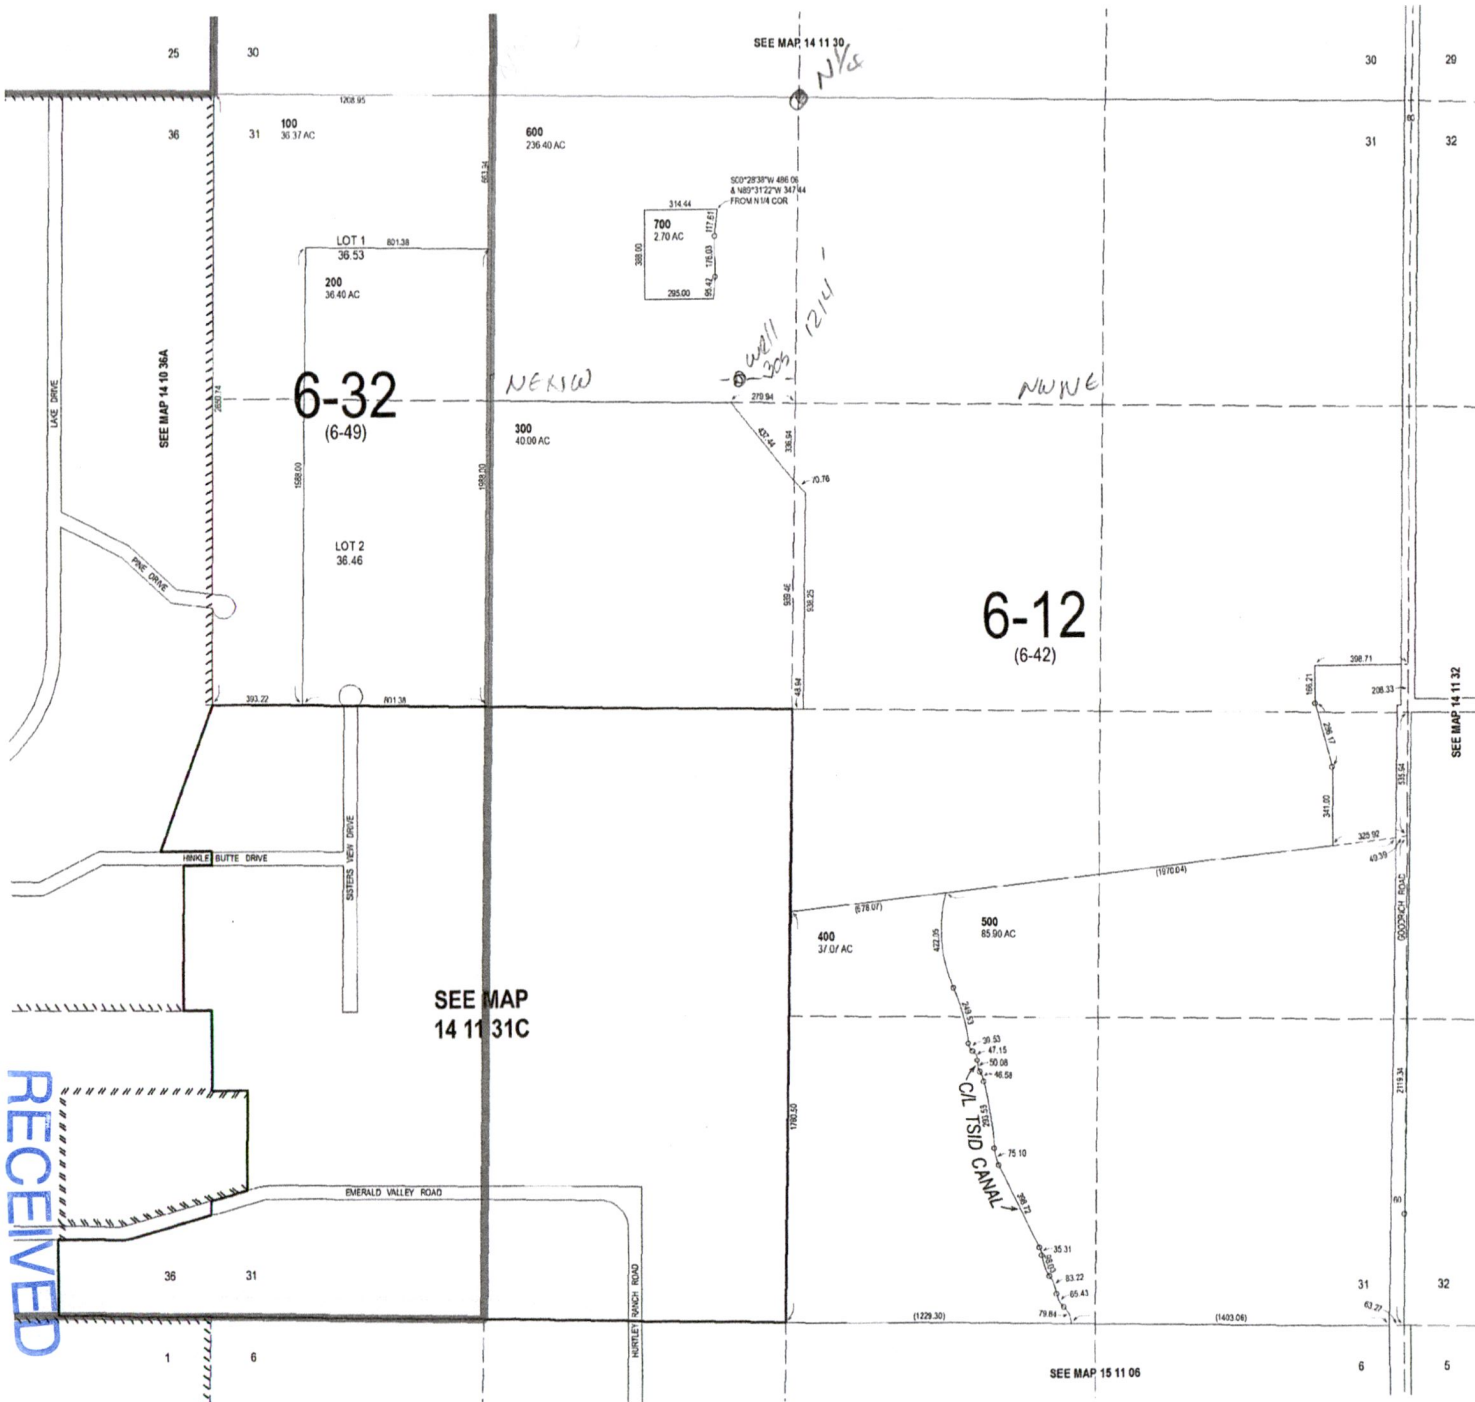

RECEIVED  
MAY 14 2018  
OWPRD

14 11 31  
& INDEX