

NE1/4 SEC 27 T5N R28E WM
UMATILLA COUNTY, OR

5N2827A


Aerial Photo No. 1P-104

SCALE: 1" = 200

22 23

Map 5N 28D

See Map 5N 28D

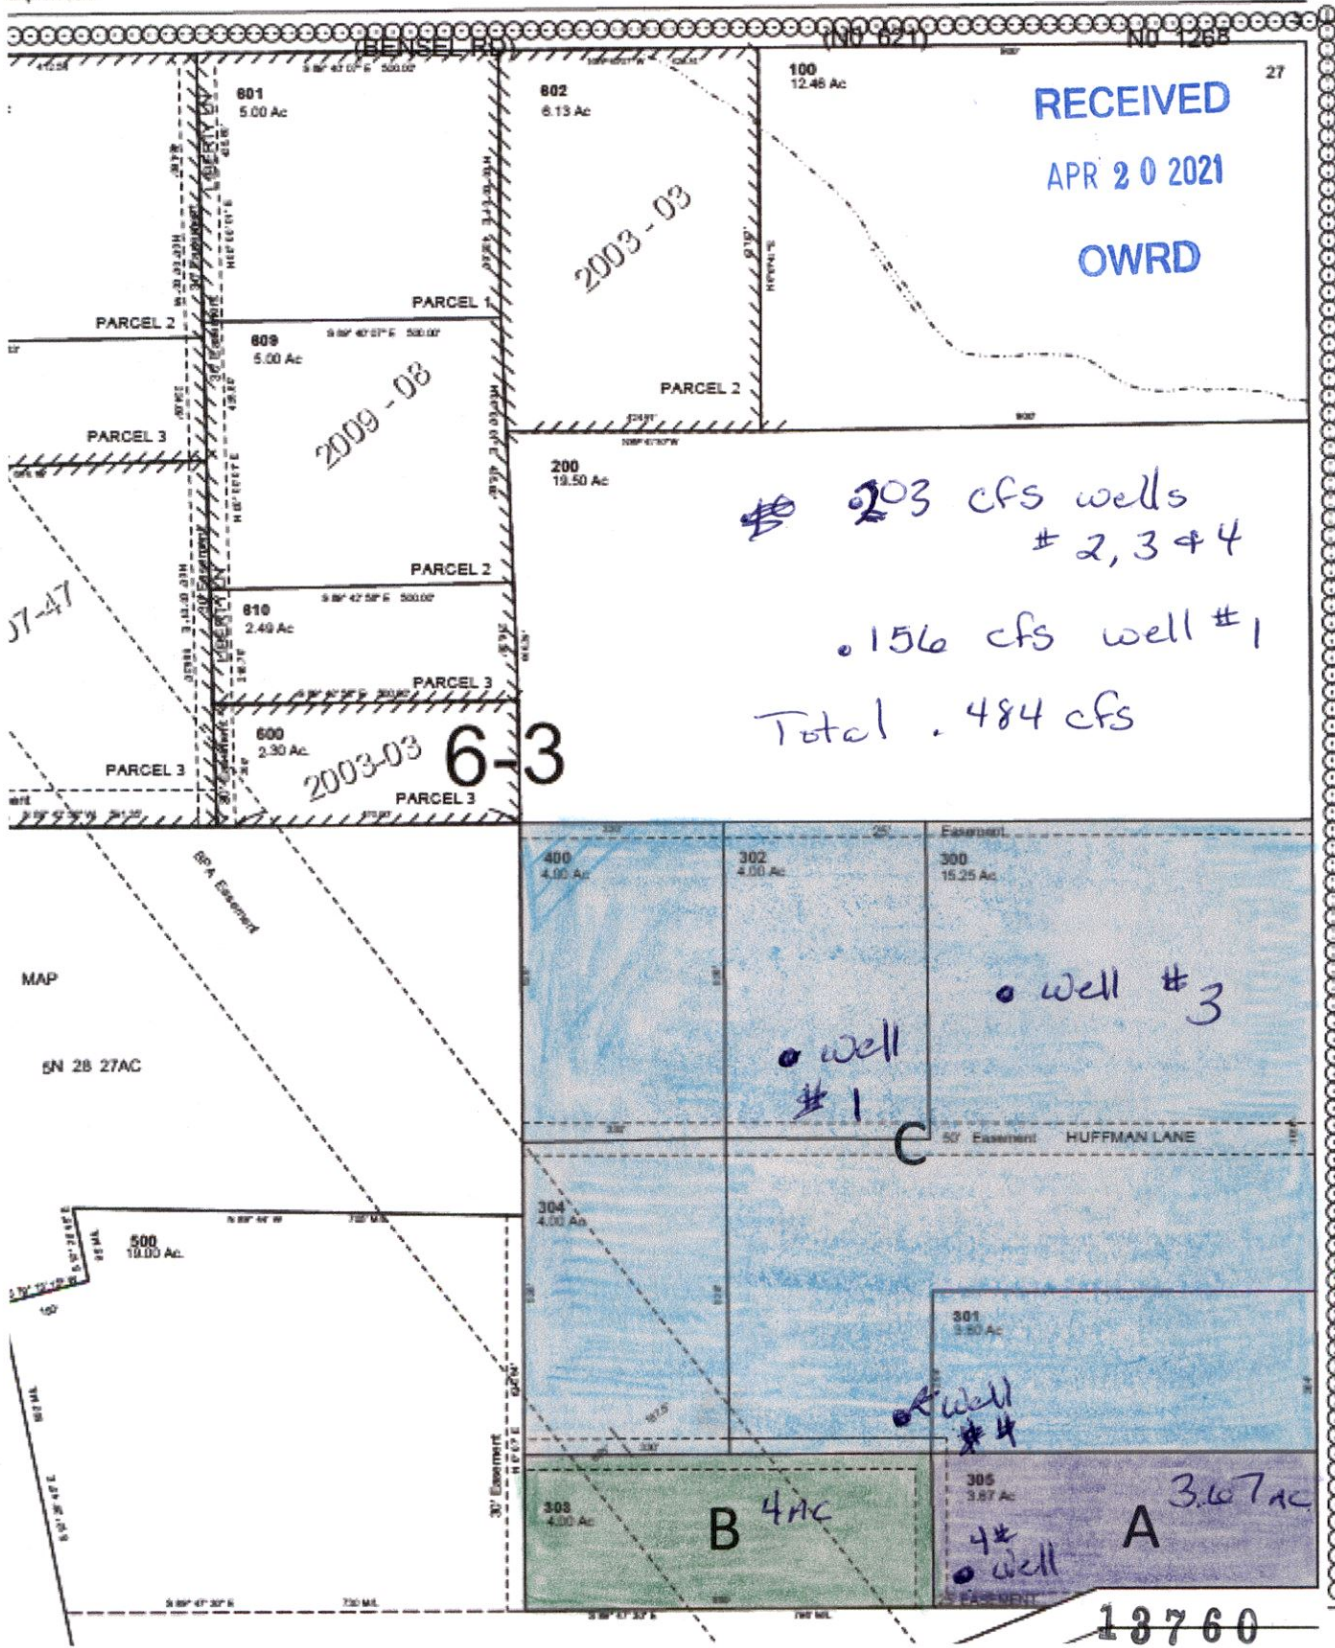

See Map 5N 28 206B

1/4 Cor.

13760